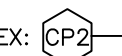


ROOM FINISH SCHEDULE


FL BA
WA CENOTE:
ROOM FINISHES
FL=FLOOR, BA=BASE, WA=WALL, CE=CEILING
EX=EXISTING NA=NO FINISH

GENERAL NOTES:

- REFER TO SECTION DETAILS & INTERIOR ELEVATIONS FOR SPECIAL WALL TREATMENT.
-  SYMBOL DENOTES ACCENT FINISH TO EXTENT AS NOTED ON PLAN. EX: 
- REFER TO SHEETS A3.01, A3.02, -----FOR COMPLETE FINISHES INFORMATION
- ALL WALL FINISHES PAINTED UNLESS OTHERWISE NOTED
- ALL ELECTRICAL PANELS, DEVICES, MECHANICAL, AND ACCESS HATCHES EXPOSED TO BE PAINTED TO MATCH ADJACENT WALL
- ALL CEILING GYPSUM BULKHEADS TO BE PAINTED TO MATCH ADJACENT WALL UNLESS OTHERWISE NOTED
- FLOOR BASE CONTINUES AROUND CONCRETE CURBS AND COLUMN BASES
- PROVIDE MIN 1% SLOPE TO DRAIN FOR ALL FLOOR DRAINS UNLESS OTHERWISE NOTED
- ALL CONCRETE COLUMN BASES TO BE SEALED. TYPICAL
- CONCRETE HOUSEKEEPING PADS TO BE 150mm HIGH UNO. TYPICAL
- PROVIDE COMPATIBLE VINYL OR RUBBER TRANSITION STRIPS AT ALL FLOOR FINISH CHANGES
- REFER TO MILLWORK DETAILS AND SPECIFICATION FOR COMPLETE MILLWORK FINISHES INFORMATION
- TYPICALLY WALLS TO RECEIVE PAINT FINISH UNO.

FLOOR	C1	SEALED CONCRETE
	C2A	SEALED CONCRETE W/ ACID ETCH COLOUR A
	C2B	SEALED CONCRETE W/ ACID ETCH COLOUR B
	C3	HARDENED CONCRETE
	C4	CONCRETE W/ WATERPROOF ADMIXTURE
	CPT	CARPET
	EF	EPOXY FLOOR W/ INTEGRAL COVE BASE (150 HIGH UNLESS OTHERWISE NOTED)
	R1	DELETED
	R2	10mm SPORT FLOOR DECOR TILE 510 DARK GRAY/BLACK
	R3	10mm SPORT FLOOR DECOR TILE 515 LIGHT GRAY/BLACK
	R4	DELETED
	R5	DELETED
	R6	PROTECTALL
	R7	10mm BLACK RUBBER
	RX	DELETED
	PU	POLYURETHANE FLOOR SYSTEM (NUMBER INDICATES COLOUR)
	SV	SHEET VINYL (NUMBER INDICATES COLOUR)
	SF	SPORTS FLOOR BY PROPRIETARY COURT SYSTEM SUPPLIER
	WD	SPRUNG HARDWOOD AEROBIC FLOOR
	CJ	TRENCH COVERS REFER TO A2.10 CONTROL JOINT
BASE	EF	EPOXY FLOOR WITH 150 INTEGRAL COVE BASE
	RB1	RUBBER COVE BASE 150 HIGH
	SVB	150 INTEGRAL COVE BASE
WALL	T	TILE - GLAZED
	P#	PAINTED - NUMBER DENOTES COLOUR. REFER TO SPEC.
	EX	EXPOSED WITH NO FINISH
	SW	SPORTS WALL BY PROPRIETARY COURT SYSTEM SUPPLIER
CEILING	CT1	SUSPENDED ACOUSTIC CEILING TILE - TYPE 1
	CT2	SUSPENDED ACOUSTIC CEILING TILE - TYPE 2
	PG	SUSPENDED GYPSUM BOARD CEILING-PAINTED
	EXP	EXPOSED STRUCTURE-PAINTED
	EX	EXPOSED STRUCTURE-UNPAINTED

GCC-0002

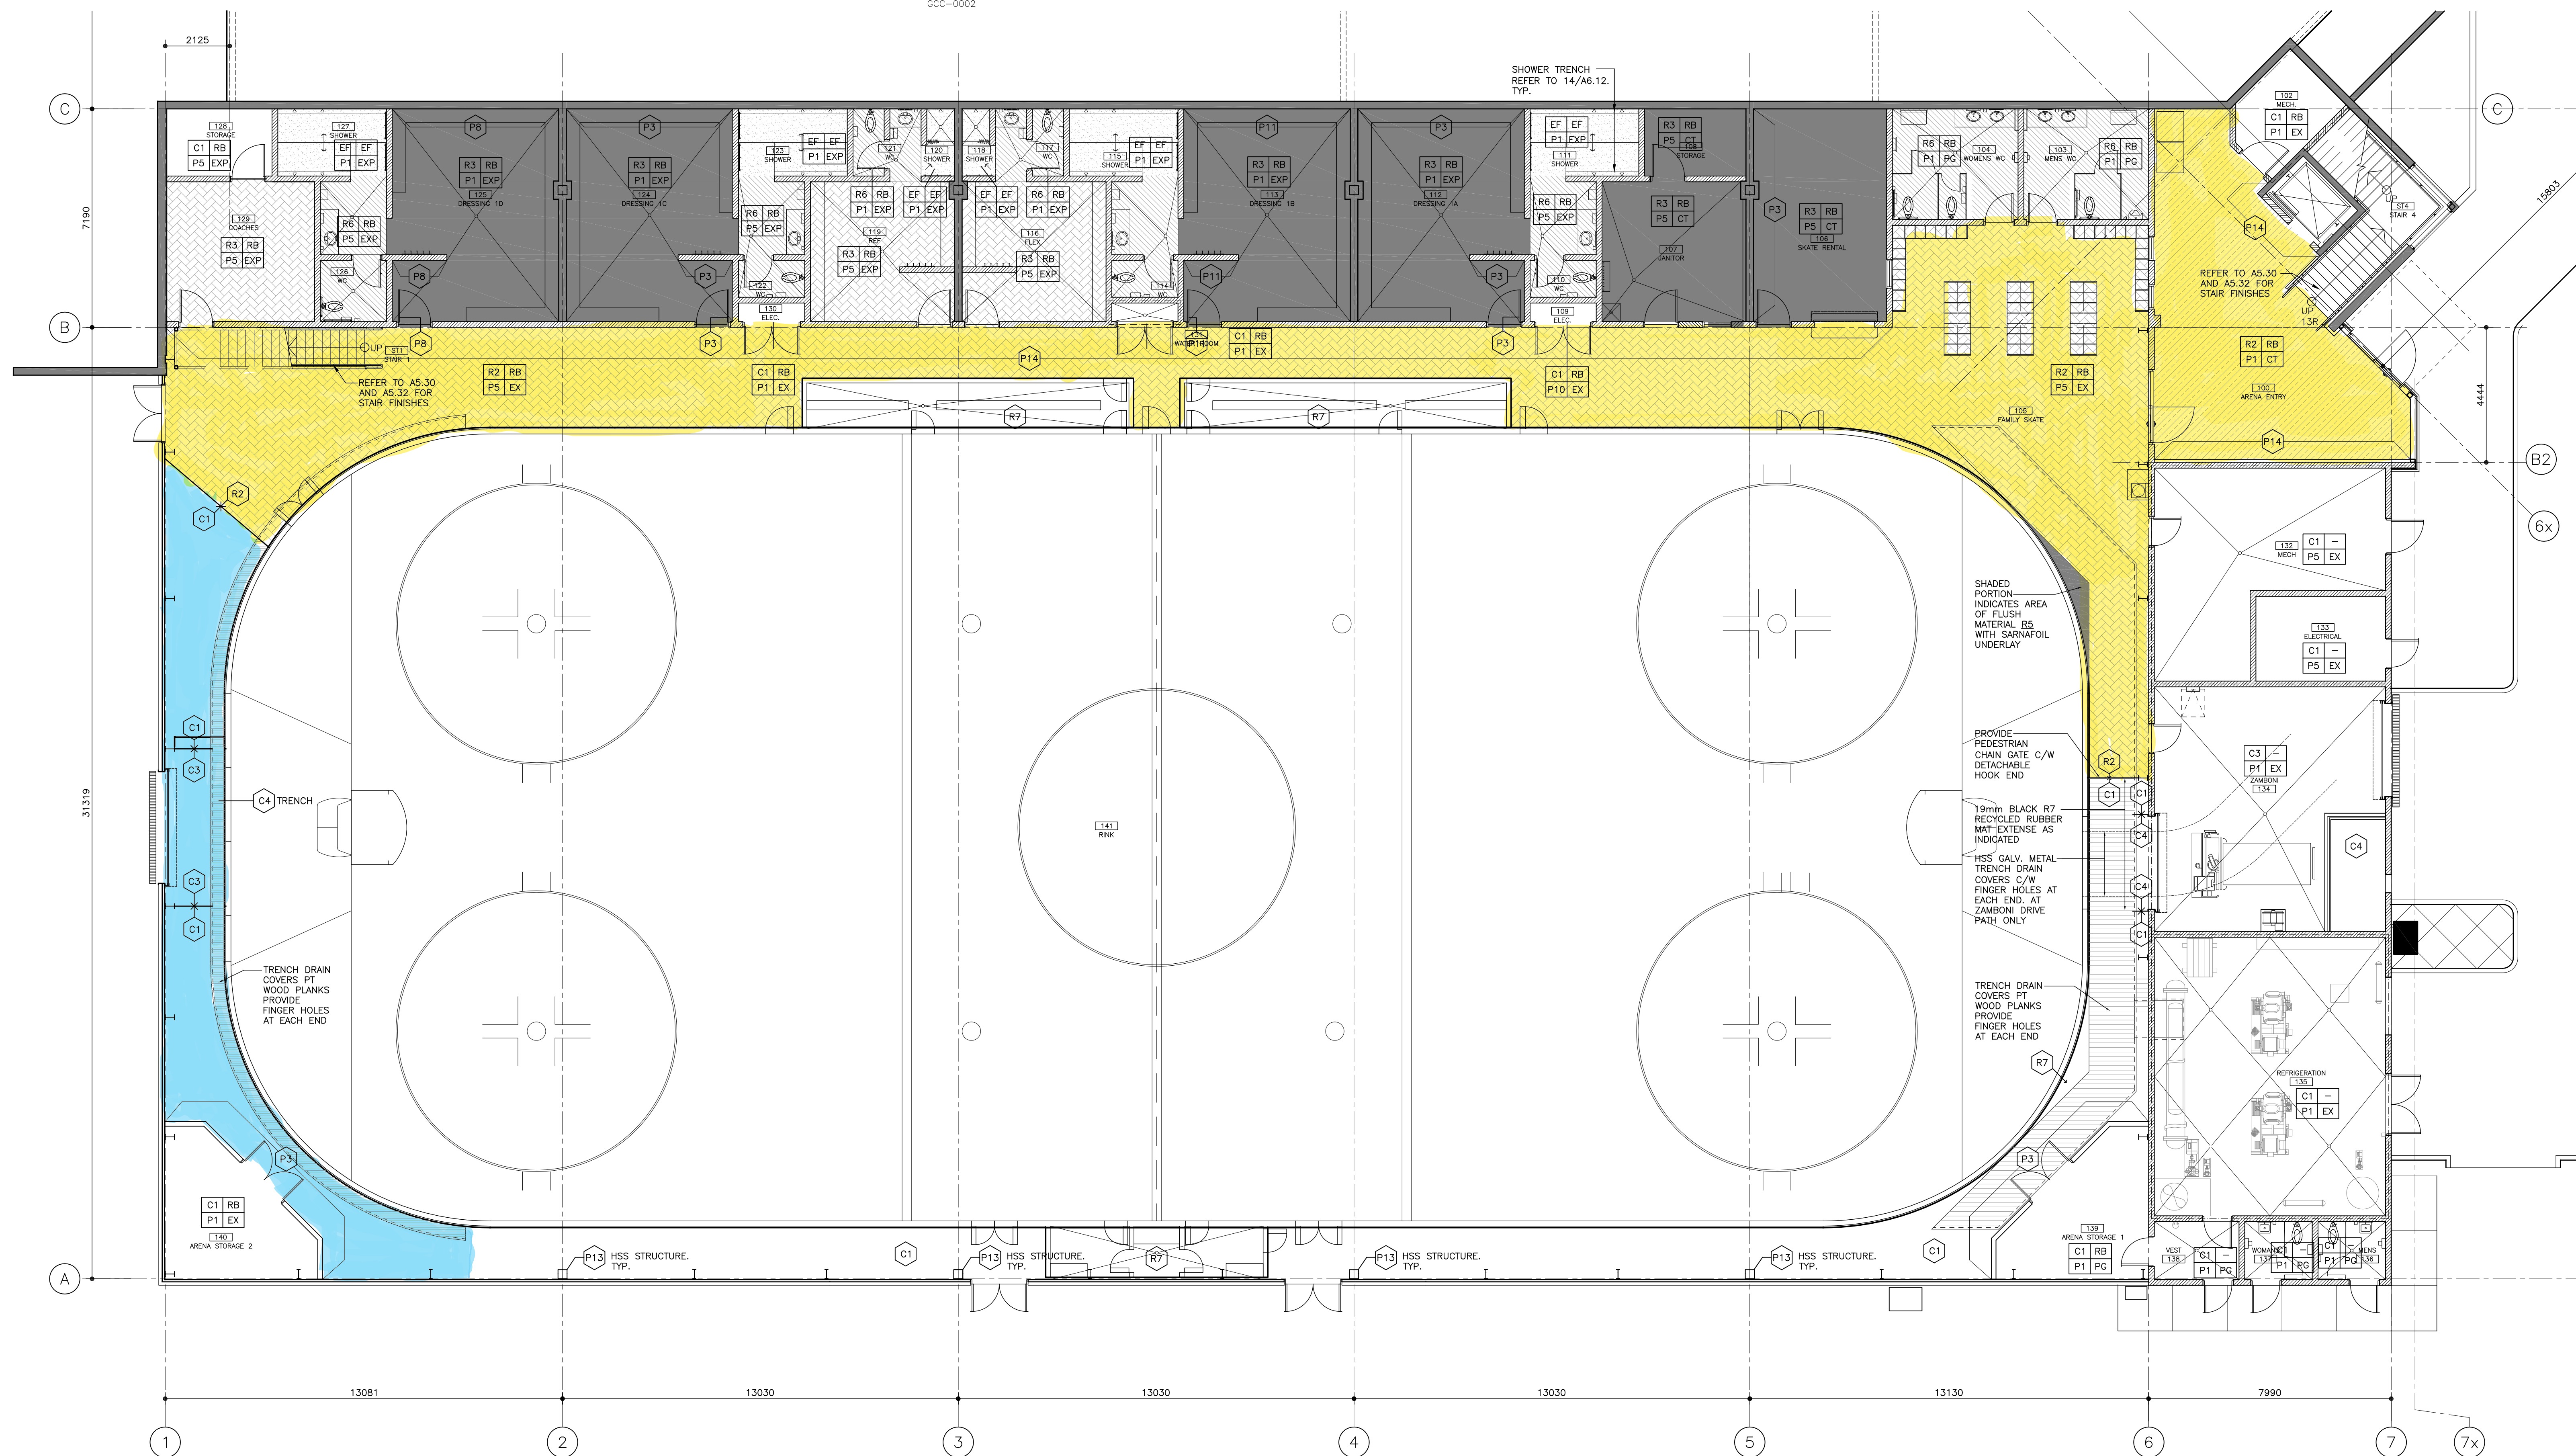

CONSULTANTS

*THIS IS A COPYRIGHT DRAWING AND DESIGN AND SHALL NOT BE USED, REPRODUCED, OR REVISED WITHOUT WRITTEN PERMISSION.
*THE CONTRACTOR SHALL CHECK AND VERIFY ALL DIMENSIONS AND REPORT ALL ERRORS AND OMISSIONS TO THE ARCHITECT PRIOR TO COMMENCING THE WORK.
*THESE DRAWINGS ARE NOT TO BE SCALED.

METRIC

ALL DIMENSIONS UNLESS OTHERWISE
NOTED ARE IN MILLIMETRES

SEALS

ISSUED FOR

NO.	DATE	DESCRIPTION
1.	03 MAY 06	ISSUED TO TOWN OF GIBSONS FOR SITE PREPARATION BUILDING PERMIT
2.	19 MAY 06	ISSUED FOR BID PACKAGE #2 REVIEW
3.	01 JUNE 06	ISSUED FOR BID PACKAGE #2 TENDER
4.	01 JUNE 06	ISSUED FOR B.P. FOUNDATION
5.	26 JUNE 06	ISSUED FOR BID PACKAGE #3 REVIEW
6.	04 JULY 06	ISSUED FOR BID PACKAGE #3 TENDER
7.	25 JULY 06	ADDENDUM #1
8.	14 JULY 06	ISSUED TO TASK INCLUDES BID PACK #3 INCLUDES ADDENDUM INFORMATION
9.	18 OCT 06	ISSUED FOR BID PACKAGE #4 TENDER
10.	27 OCT 06	ISSUED FOR BUILDING PERMIT 2
11.	27 OCT 06	ISSUED FOR CONSTRUCTION
12.	09 MAY 08	RECORD DRAWINGS

PROJECT TITLE

GIBSONS AREA
COMMUNITY CENTER

SUNSHINE COAST, BC

DRAWING TITLE

LOWER FLOOR
FINISHES PLAN
ARENA

DATE _____ DRAWN AE/DM/SC

PLOT DATE _____

CAD FILE _____

PROJECT NUMBER

DRAWING NO.

25157

A3.02

1 LOWER FLOOR FINISHES PLAN

A3.02 SCALE: 1:100
GCC-0011.dwg