


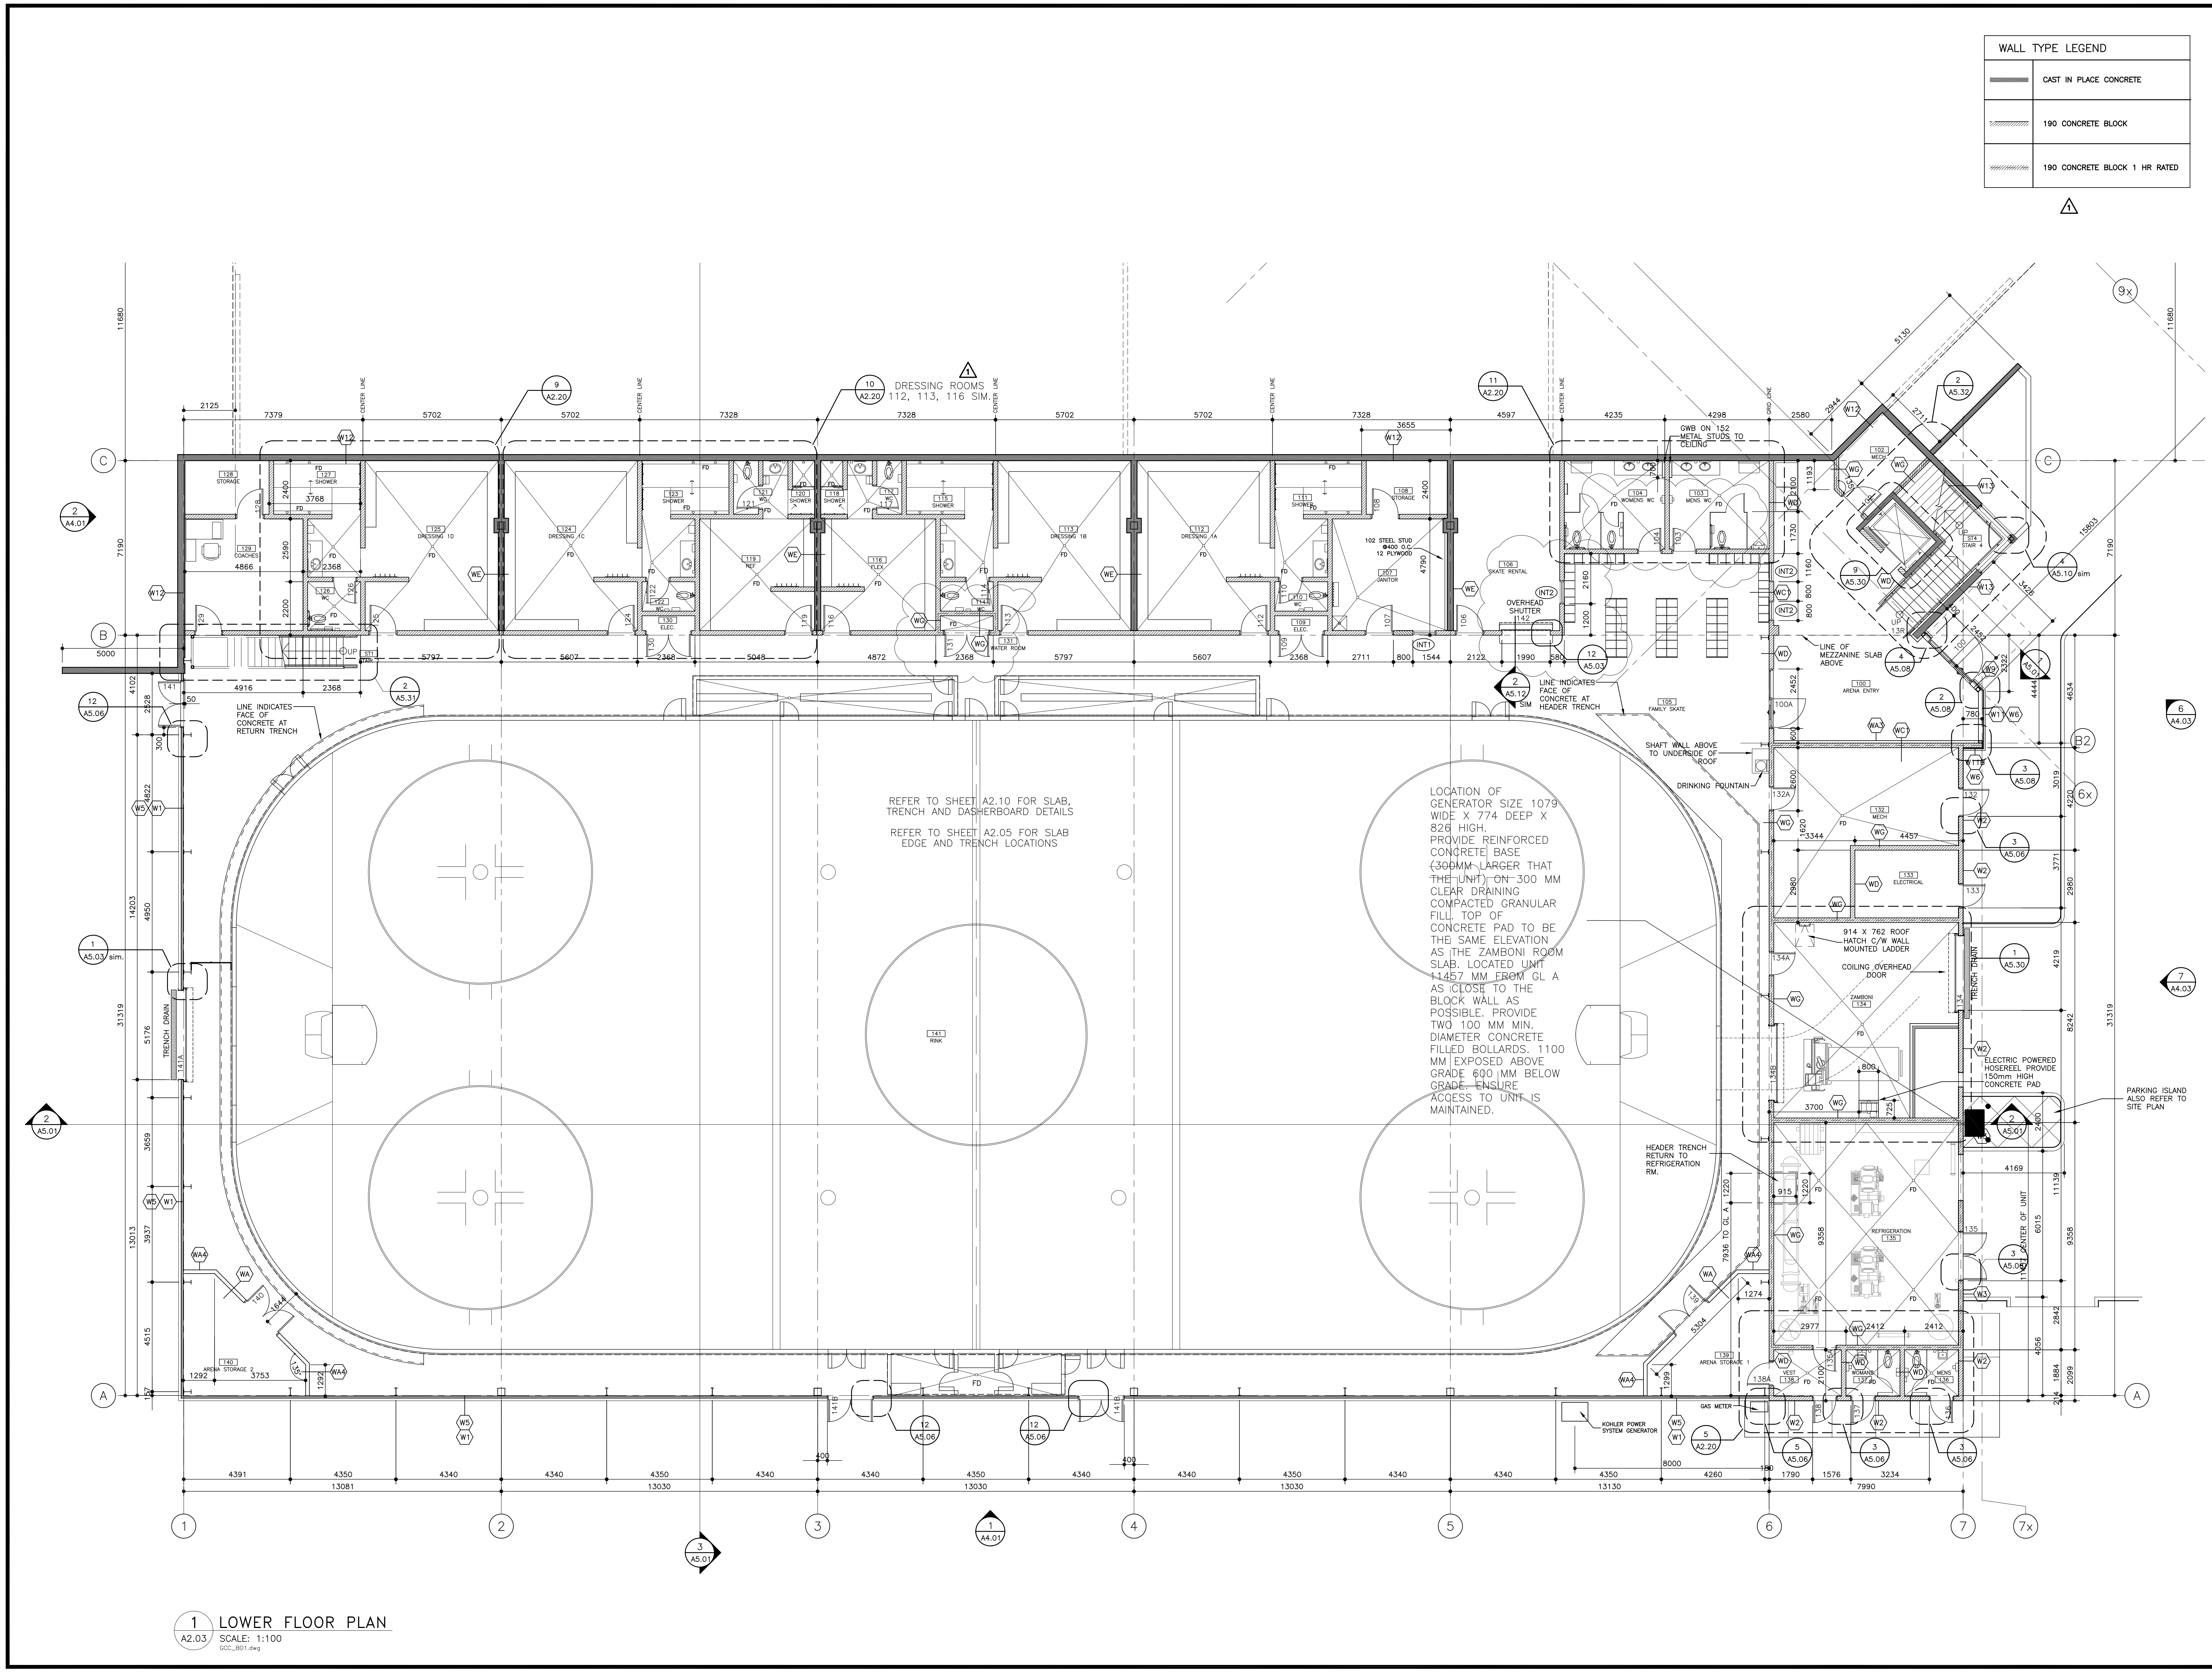

WALL TYPE LEGEND	
	CAST IN PLACE CONCRETE
	190 CONCRETE BLOCK
	190 CONCRETE BLOCK 1 HR RATED



VANCOUVER
T. 604.687.1898 F. 604.682.5398
500 - 1500 WEST GEORGIA STREET
BC CANADA V6G 2Z6

VICTORIA
T. 250.388.5588 F. 250.361.9418
210 - 2950 DOUGLAS STREET
BC CANADA V8T 4H4



CONSULTANTS

*THIS IS A COPYRIGHT DRAWING AND DESIGN AND SHALL NOT BE USED, REPRODUCED, OR REVISED WITHOUT WRITTEN PERMISSION.
*THE CONSULTANT SHALL CHECK AND VERIFY ALL DIMENSIONS AND REPORT ALL ERRORS AND OMISSIONS TO THE ARCHITECT PRIOR TO COMMENCING THE WORK. THESE DRAWINGS ARE NOT TO BE SCALED.

METRIC

ALL DIMENSIONS UNLESS OTHERWISE NOTED ARE IN MILLIMETRES

SEALS

ISSUED FOR

NO.	DATE	DESCRIPTION
1.	03 MAY 06	ISSUED TO TOWN OF GIBSONS FOR SITE PREPARATION BUILDING PERMIT
2.	19 MAY 06	ISSUED FOR BID PACKAGE #2 TENDER
3.	01 JUNE 06	ISSUED FOR BID PACKAGE #2 TENDER
4.	01 JUNE 06	ISSUED FOR B.P. FOUNDATION
5.	26 JUNE 06	ISSUED FOR BID PACKAGE #3 REVIEW
6.	04 JULY 06	ISSUED FOR BID PACKAGE #3 TENDER
7.	25 JULY 06	ADDENDUM #1
8.	14 JULY 06	ISSUED TO TASK INCLUDES BID PACK #3 INCLUDES ADDENDUM INFORMATION
9.	18 OCT 06	ISSUED FOR BID PACKAGE #4 TENDER
10.	27 OCT 06	ISSUED FOR BUILDING PERMIT 2
11.	27 OCT 06	ISSUED FOR CONSTRUCTION
12.	07 May 07	UPDATED WITH ISSUED INSTRUCTIONS TO DATE AS REQUESTED BY TASK
13.	09 MAY 08	RECORD DRAWINGS

PROJECT TITLE

GIBSONS AREA
COMMUNITY CENTER

SUNSHINE COAST, BC

DRAWING TITLE

LOWER
FLOOR PLAN
ARENA

DATE: _____ DRAWN: AE/DM/SC

PLOT DATE: _____

CAD FILE: _____

PROJECT NUMBER: _____ DRAWING NO.: _____

25157 A2.03