


SUNSHINE COAST REGIONAL DISTRICT
GARDEN BAY UV BUILDING

CONTRACT No. 12-175

RECORD DRAWINGS

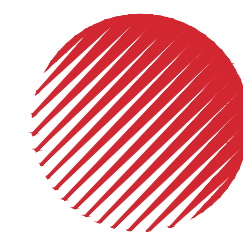


OPUS DAYTONKNIGHT

North Vancouver Office
604-990-4800

210-889 Harbourside Drive
North Vancouver BC
V7P 3S1, Canada



AREA PLAN
(N.T.S.)

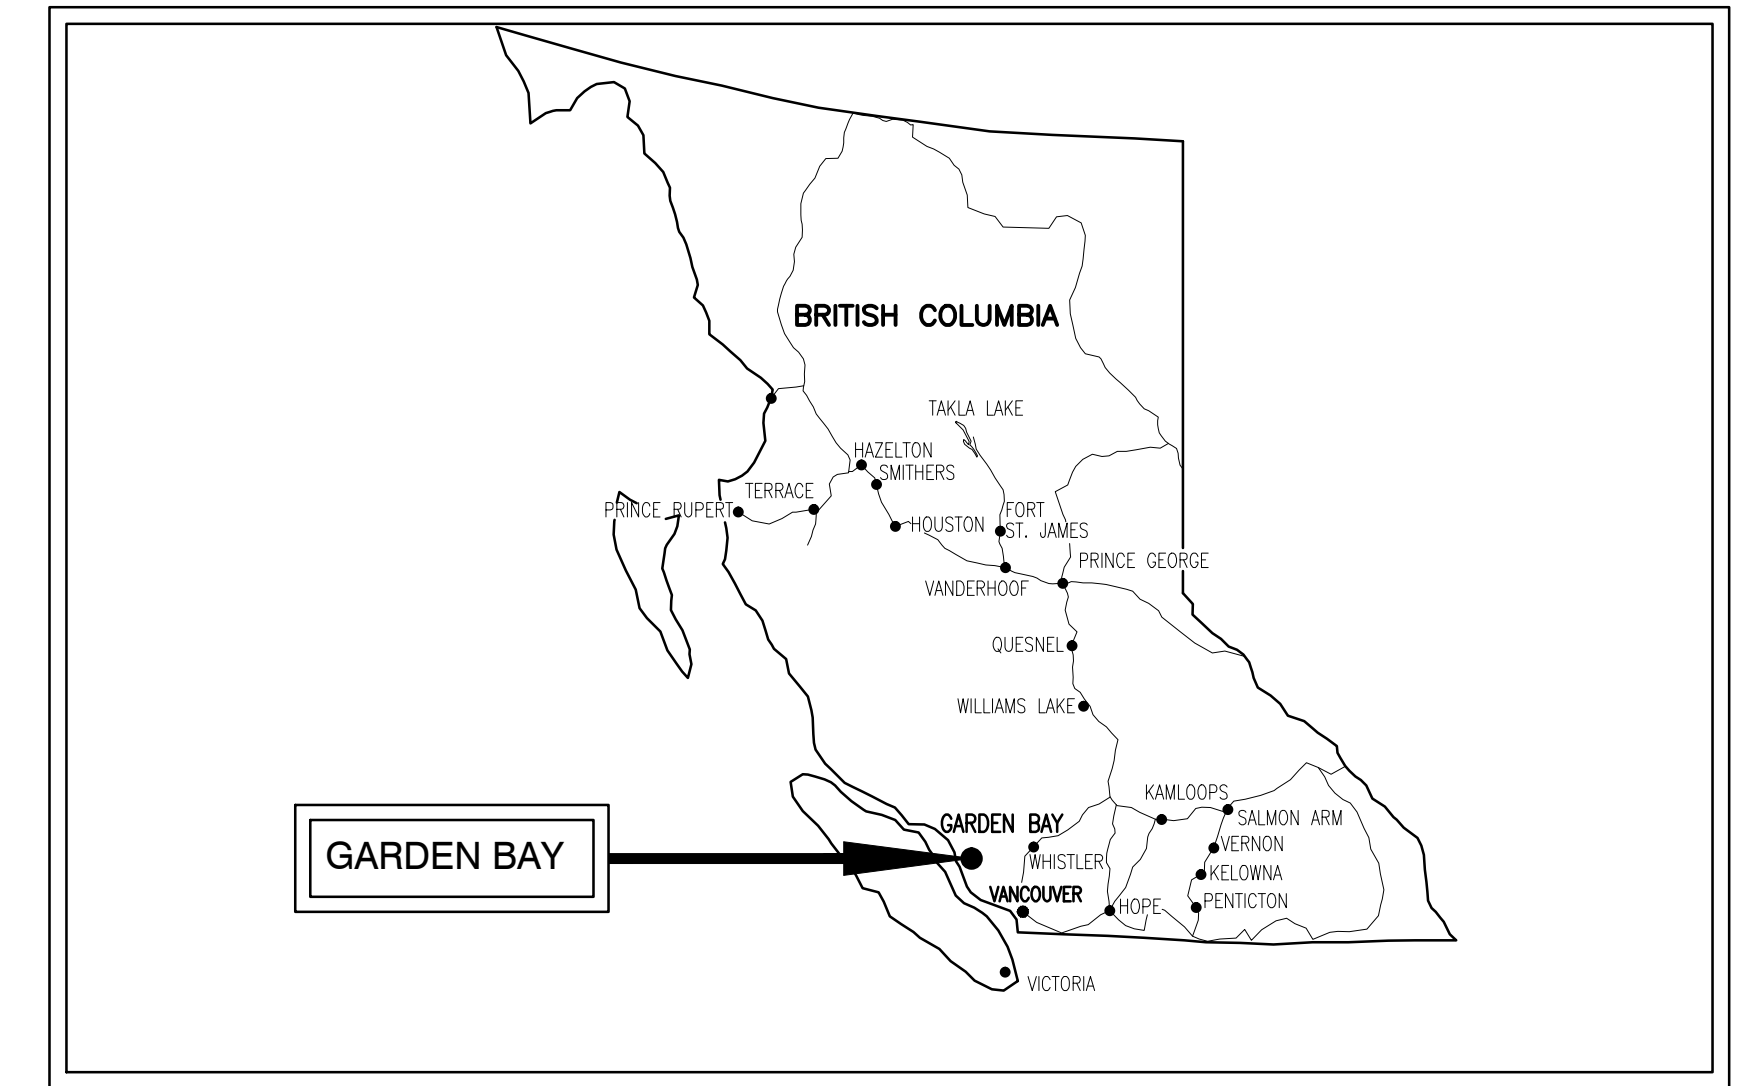


KEY PLAN

INDEX TO DRAWINGS (TOTAL DRAWINGS = 19)

No.	TITLE	No.	TITLE
GENERAL		ELECTRICAL	
G1	KEY PLAN – AREA PLAN – INDEX TO DRAWINGS	E1	ELECTRICAL – SINGLE LINE DIAGRAM & MISCELLANIOUS DETAILS
PROCESS AND INSTRUMENTATION		E2	ELECTRICAL – LIGHTING, UTILITY, POWER AND CONTROL LAYOUT
P1	STANDARD TAGS AND ABBREVIATIONS	E3	ELECTRICAL – PLC NEW I/O
P2	P&ID STANDARD SYMBOLS, EQUIPMENT, VALVES AND INSTRUMENTATION	E4	ELECTRICAL – PLC LAYOUT / COMMUNICATION BLOCK DIAGRAM
P3	PROCESS AND INSTRUMENTATION DIAGRAM		
ARCHITECTURAL			
A1	ARCHITECTURAL – WEST ELEVATION		
A2	ARCHITECTURAL – ROOF PLAN		
STRUCTURAL			
S1	GENERAL CONSTRUCTION NOTES		
S2	GENERAL STRUCTURAL & MASONRY DETAILS		
S3	STRUCTURAL – PLANS		
S4	STRUCTURAL – SECTIONS		
S5	NOT USED		
S6	STRUCTURAL – SECTIONS		
MECHANICAL			
M1	MECHANICAL – PLANS		
M2	MECHANICAL – SECTIONS		
HVAC			
H1	HVAC – PLANS & SECTION		

" This Record Drawing has been prepared by Opus DaytonKnight ("Opus DK") for the exclusive use of "Sunshine Coast Regional District" (the "Client"). Any use which a third party makes of this drawing, or any reliance or decisions or actions taken by any such third party based upon this drawing, are the sole responsibility of any such third party and Opus DK accepts no responsibility, liability or risk for any damages, loss, or claims, if any, suffered by any such third party or any related party of such third party as a result of any reliance, or decisions made or actions taken, based upon this drawing. It is the user's sole responsibility to check the accuracy of this digital drawing."

SUNSHINE COAST REGIONAL DISTRICT
GARDEN BAY UV BUILDING
CONTRACT No. 12-175

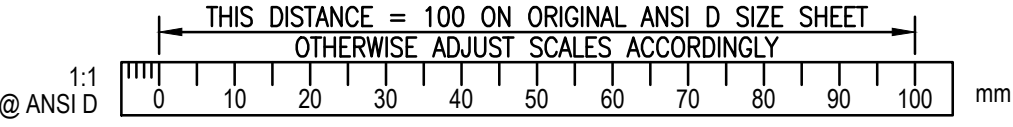

FILE: G:\D&K CAD Drawings\KORSEVER, P. Share\Records\SUNSHINE_COAST\28-206\GENERAL_28-206_G1.dwg, Tab: G1, 13-06-07, vscjg

ISSUE	DATE	DRAWN	CHK'D	APP'D	DESCRIPTION
A	JAN27/12	AIS	WB	WB	ISSUED FOR TENDER
B	APR25/12	AIS	WB	WB	ISSUED FOR CONSTRUCTION
C	MAY08/13	RB	WB	WB	RECORD DRAWING

DESIGNED	DRAWN	CHECKED
WB	AIS	WB

OPUS DAYTONKNIGHT
North Vancouver Office
604-990-4800
210-889 Harbourside Drive
North Vancouver BC
V7P 3S1, Canada

SUNSHINE COAST REGIONAL DISTRICT
GARDEN BAY UV BUILDING
KEY PLAN, AREA PLAN & INDEX TO DRAWINGS

SCALE: AS SHOWN
DRAWING No. 028.206
SHEET No. G1 ISSUE C

INSTRUMENT SYMBOLS

	CONTROL ROOM LOCATION ACCESSIBLE TO OPERATOR	CONTROL ROOM LOCATION INACCESSIBLE TO OPERATOR	LOCAL LOCATION ACCESSIBLE TO OPERATOR	LOCAL LOCATION INACCESSIBLE TO OPERATOR	FIELD LOCATED
DISCRETE INSTRUMENTS					
HMI FROM DISTRIBUTED CONTROL SYSTEM					
SCADA DISPLAY/COMPUTER FUNCTION					
PROGRAMMABLE LOGIC CONTROLLER					

GENERAL NOTES

1. FADED SYMBOLS AND LINES REPRESENT EXISTING EQUIPMENT.
2. HATCHED EQUIPMENT AND LINES TO BE REMOVED.
3. FOR DETAILS OF INSTRUMENTATION LINES 1" OR LESS REFER TO INSTALLATION OR LOOP DIAGRAMS.
4. INSTRUMENTATION FOLLOWS ISA STANDARDS & PRACTICES 5.1, 5.2, 5.3, 5.4, 5.5.

FLOW UNITS

AIR: m³/HR
 CHEMICALS: kg PER DAY/ GRAMS PER LITRE/ LITRES PER SECOND
 SEWERS: LITRES PER SECOND
 SOLIDS: DRY METRIC TONNES PER DAY/ OR kg/D
 WATER: LITRES PER SECOND

*NOTE: NUMBERS INDICATE MAXIMUM FLOW FOR PIPE AND EQUIPMENT SIZING. CONTROL VALVES MAY BE SIZED FOR LESS.

EQUIPMENT GENERAL

- | | |
|----------------------------|-------------------------------------|
| AP - ACID METER PUMP | OMI - OPERATOR MACHINE INTERFACE |
| B - BLOWER | P - PUMP |
| BP - CAUSTIC METER PUMP | PG - PRESSURE GAUGE |
| CRN - O/H CRANE | PLC - PROGRAMMABLE LOGIC CONTROLLER |
| CPS - COMPUTER | PRV - PRESSURE REDUCING VALVE |
| CON - CONVEYOR | SCB - SCRUBBER |
| CV - CHECK VALVE | SCC - SECONDARY CLARIFIER |
| CP - COMPRESSOR | SCRN - ROTATING SCREEN |
| EF - EXHAUST FAN | SF - SUPPLY FAN |
| FC - FLUSHING CONNECTION | SG - SLIDE GATE |
| HE - HEAT EXCHANGER | SLG - SLUICE GATE |
| M - MOTOR | SL - STOP LOG |
| MXR - MIXER | SP - SLUDGE PUMP |
| MCB - MASTER CONTROL BOARD | SV - SOLENOID VALVE |
| MCC - MOTOR CONTROL CENTRE | TK - TANK |
| ME - MECHANICAL EQUIPMENT | VA - VALVE |
| MV - MOTORIZED VALVE | UP - UTILITY PUMP |
| | VT - VENTURA-NOZZLE |
| | WG - WEIR |

PROCESS LINE TYPES

- MAIN (OR NEW) PROCESS LINE
- SECONDARY (OR EXISTING) PROCESS LINE
- EXISTING PIPING AND EQUIPMENT
- FUTURE PROCESS LINE
- EXISTING PIPING AND EQUIPMENT TO BE REMOVED
- OPEN CHANNEL (EXIST./NEW)

INSTRUMENT SIGNAL LINE TYPES

- CAPILLARY TUBE OR FILLED SYSTEM SIGNAL LINE
- ELECTRIC INSTRUMENT LINE - ANALOG
- ELECTRIC INSTRUMENT LINE - DIGITAL (ASD DRIVE)
- ELECTRIC INSTRUMENT SIGNAL (EXIST./NEW)
- ELECTRIC OR ELECTRONIC INSTRUMENT SIGNAL WITH DIRECTION AS SHOWN, PROCESS TAPS
- INTERNAL SYSTEM LINK (CPS, HMI)
- INTERNAL SYSTEM LINK (ISL - SOFTWARE OR DATA)
- PNEUMATIC INSTRUMENT SIGNAL
- SPARE

INSTRUMENT FUNCTIONAL IDENTIFICATION LETTERS

FIRST LETTERS (4)		SUCCEEDING LETTERS (3)		
MEASURED OR INITIATING VARIABLE	MODIFIER	READOUT OR PASSIVE FUNCTION	OUTPUT FUNCTION	MODIFIER
A ANALYSIS		ALARM		
B BURNER, COMBUSTION		UNCLASSIFIED	CLOSE-STOP DECREASE	UNCLASSIFIED
C CONDUCTIVITY, pH (ACIDITY)		CLOSE	CONTROL OR CONTROLLER	
D DENSITY, SPECIFIC GRAVITY	DIFFERENTIAL		OPEN-START-INCREASE	
E VOLTAGE (EMF)		SENSOR (PRIMARY ELEMENT)		
F FLOW RATE	RATIO (FRACTION)			FAIL
G GAS, GAUGING (DIMENSIONAL)		GLASS, VIEWING DEVICE		
H HAND, MANUAL				H-HIGH-(ALARM) HH-HIGH-(SHUTDOWN)
I CURRENT (ELECTRICAL)		INDICATE		
J POWER	SCAN			
K TIME, TIME SCHEDULE	TIME RATE OF CHANGE		CONTROL STATION	
L LEVEL		LIGHT		L-LOW-(ALARM) LL-LOW-(SHUTDOWN)
M MOTOR	MOMENTARY	MONITOR, ON OR OPERATE		MIDDLE, INTERMEDIATE
N MOISTURE, HUMIDITY		UNCLASSIFIED	START	USER'S CHOICE
O UNCLASSIFIED		OPEN ORIFICE, RESTRICTION POINT (TEST) CONNECTION	STOP	OVERLOAD
P PRESSURE, VACUUM		POINT (TEST) CONNECTION	PNEUMATIC	
Q QUANTITY	INTEGRATE, TOTALIZE	INTEGRATE, TOTALIZE	INTEGRATE OR TOTALIZE	
R RADIATION, RADIOACTIVITY	RATIO	RECORD		
S SPEED, FREQUENCY, SOLENOID	SAFETY		SWITCH OR SAFETY	
T TEMPERATURE			TRANSMIT	
TQ TORQUE				
TV TELEVISION				
U MULTIVARIABLE		MULTIFUNCTION	MULTIFUNCTION	MULTIFUNCTION
V VIBRATION, MECHANICAL ANALYSIS			VALVE, DAMPER, LOUVRE	
VS VISCOSITY				
W WEIGHT, FORCE		WELL		
X ON/OFF	X AXIS	UNCLASSIFIED	UNCLASSIFIED	UNCLASSIFIED
Y EVENT, STATE OR PRESENCE	Y AXIS		RELAY, COMPUTE, CONVERT	
Z POSITION, DIMENSION PRESENCE	Z AXIS		DRIVER, ACTUATOR, UNCLASSIFIED FINAL CONTROL ELEMENT	

ALARMS:

PC H HH = HIGH HIGH ALARM
 069 L H = HIGH ALARM
 L = LOW ALARM
 R = RATE ALARM

EXAMPLES: PI 22 FIELD LOCATED DISCRETE PRESSURE INDICATOR


YS 327 % AI = ANALOG INPUT
 % AQ = ANALOG OUTPUT
 PLC, % Q = DISCRETE OUTPUT
 % I = DISCRETE INPUT
 YS = STATUS OF SWITCH (EVENT SWITCH)

LAH 07 CONTROL ROOM PC COMPUTER DISPLAY HIGH LEVEL ALARM

AREA CODES

- 100 HEADWORKS -
- 200 PRIMARY -
- 300 ATAD, SEPTAGE, RBS -
- 400 TRICKLING FILTER, SOLIDS CONTACT -
- 500 SOLIDS DEWATERING -
- 600 FGR REMOVAL -
- 700 CLARIFIER -
- 800 FILTRATION/DISINFECTION -
- 900 CONTROL BUILDING, ADMINISTRATION -

LINE NUMBERING SYSTEM

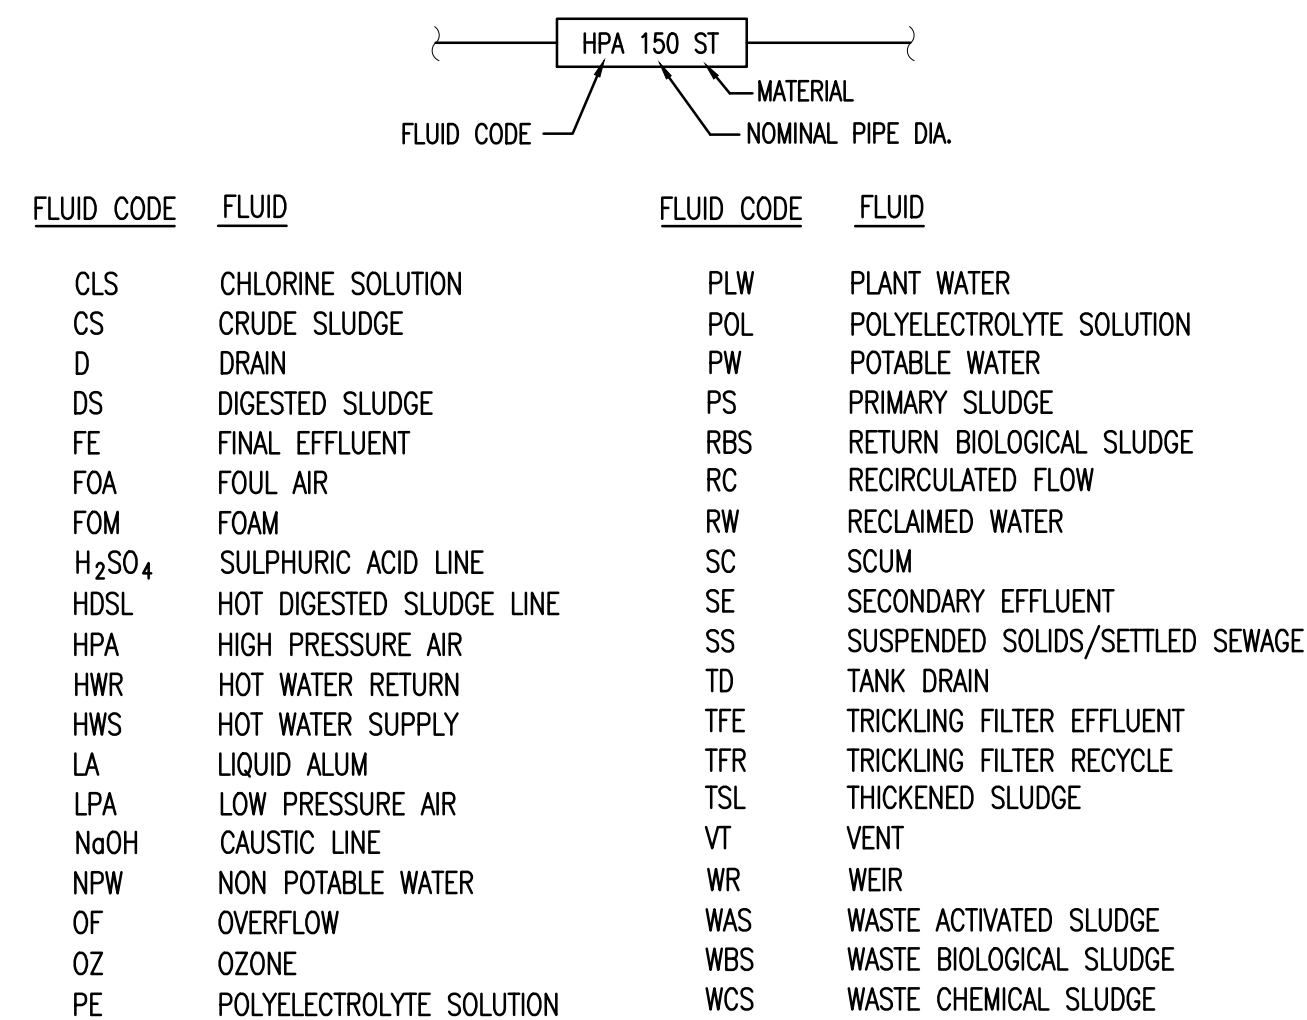


NOTE: ALSO SEE MECHANICAL AND ELECTRICAL ABBREV.

GENERAL SYMBOLS AND TAGS


1. ON DRAWING (IE. P101) CONTINUATION IS SHOWN AS:
 2. ON DRAWING (IE. P102) CONTINUATION IS SHOWN AS:
- EXISTING EQUIPMENT TAG
 - NEW EQUIPMENT TAG
 - EXISTING PIPE TAG
 - NEW PIPE TAG
 - REVISION TAG

ATTRIBUTE LEGEND

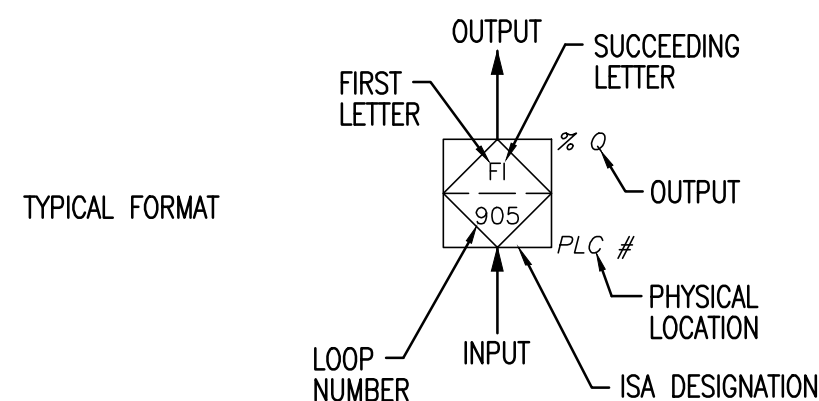


" This Record Drawing has been prepared by Opus DaytonKnight ("Opus DK") for the exclusive use of "Sunshine Coast Regional District" (the "Client"). Any use which a third party makes of this drawing, or any reliance or decisions or actions taken by any such third party based upon this drawing, are the sole responsibility of any such third party and Opus DK accepts no responsibility, liability or risk for any damages, loss, or claims, if any, suffered by any such third party or any related party of such third party as a result of any reliance, or decisions made or actions taken, based upon this drawing. It is the user's sole responsibility to check the accuracy of this digital drawing."

EQUIPMENT NUMBER

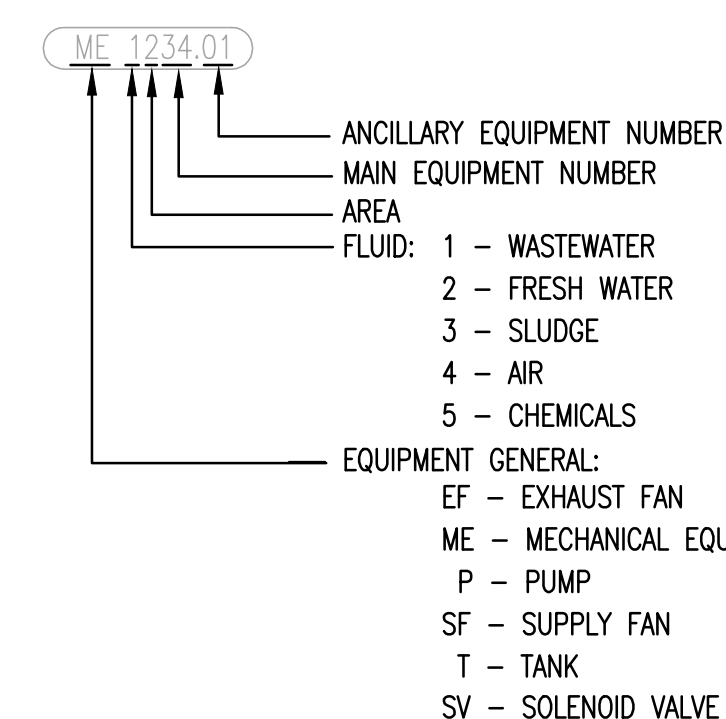

LINE DESIGNATIONS

- ELECTRIC POWER SUPPLY 120 VAC 60 HZ (UNLESS OTHERWISE NOTED)
- LINE CONTINUATION TO/FROM
- SPECIFICATION AND/OR LINE NUMBER CHANGE
- SUPPLIED BY EQUIPMENT VENDOR

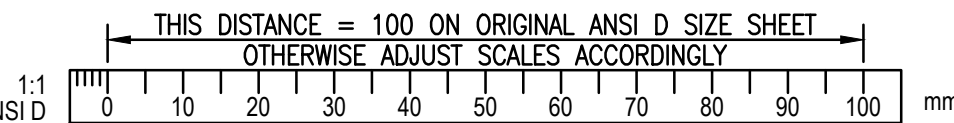


ISSUE	DATE	DRAWN	CHK'D	APP'D	DESCRIPTION	ISSUE	DATE	DRAWN	CHK'D	APP'D	DESCRIPTION
A	JAN27/12	AIS	WB	WB	ISSUED FOR TENDER						
B	APR25/12	AIS	WB	WB	ISSUED FOR CONSTRUCTION						
C	MAY08/13	RB	WB	WB	RECORD DRAWING						

DESIGNED	WB
DRAWN	AIS
CHECKED	WB

OPUS DAYTONKNIGHT
 North Vancouver Office 604-990-4800
 210-889 Harbourside Drive North Vancouver BC V7P 3S1, Canada

SUNSHINE COAST REGIONAL DISTRICT
 GARDEN BAY UV BUILDING
 STANDARD TAGS AND ABBREVIATIONS

SCALE: NTS
DRAWING No. 028.206
SHEET No. P1 ISSUE C

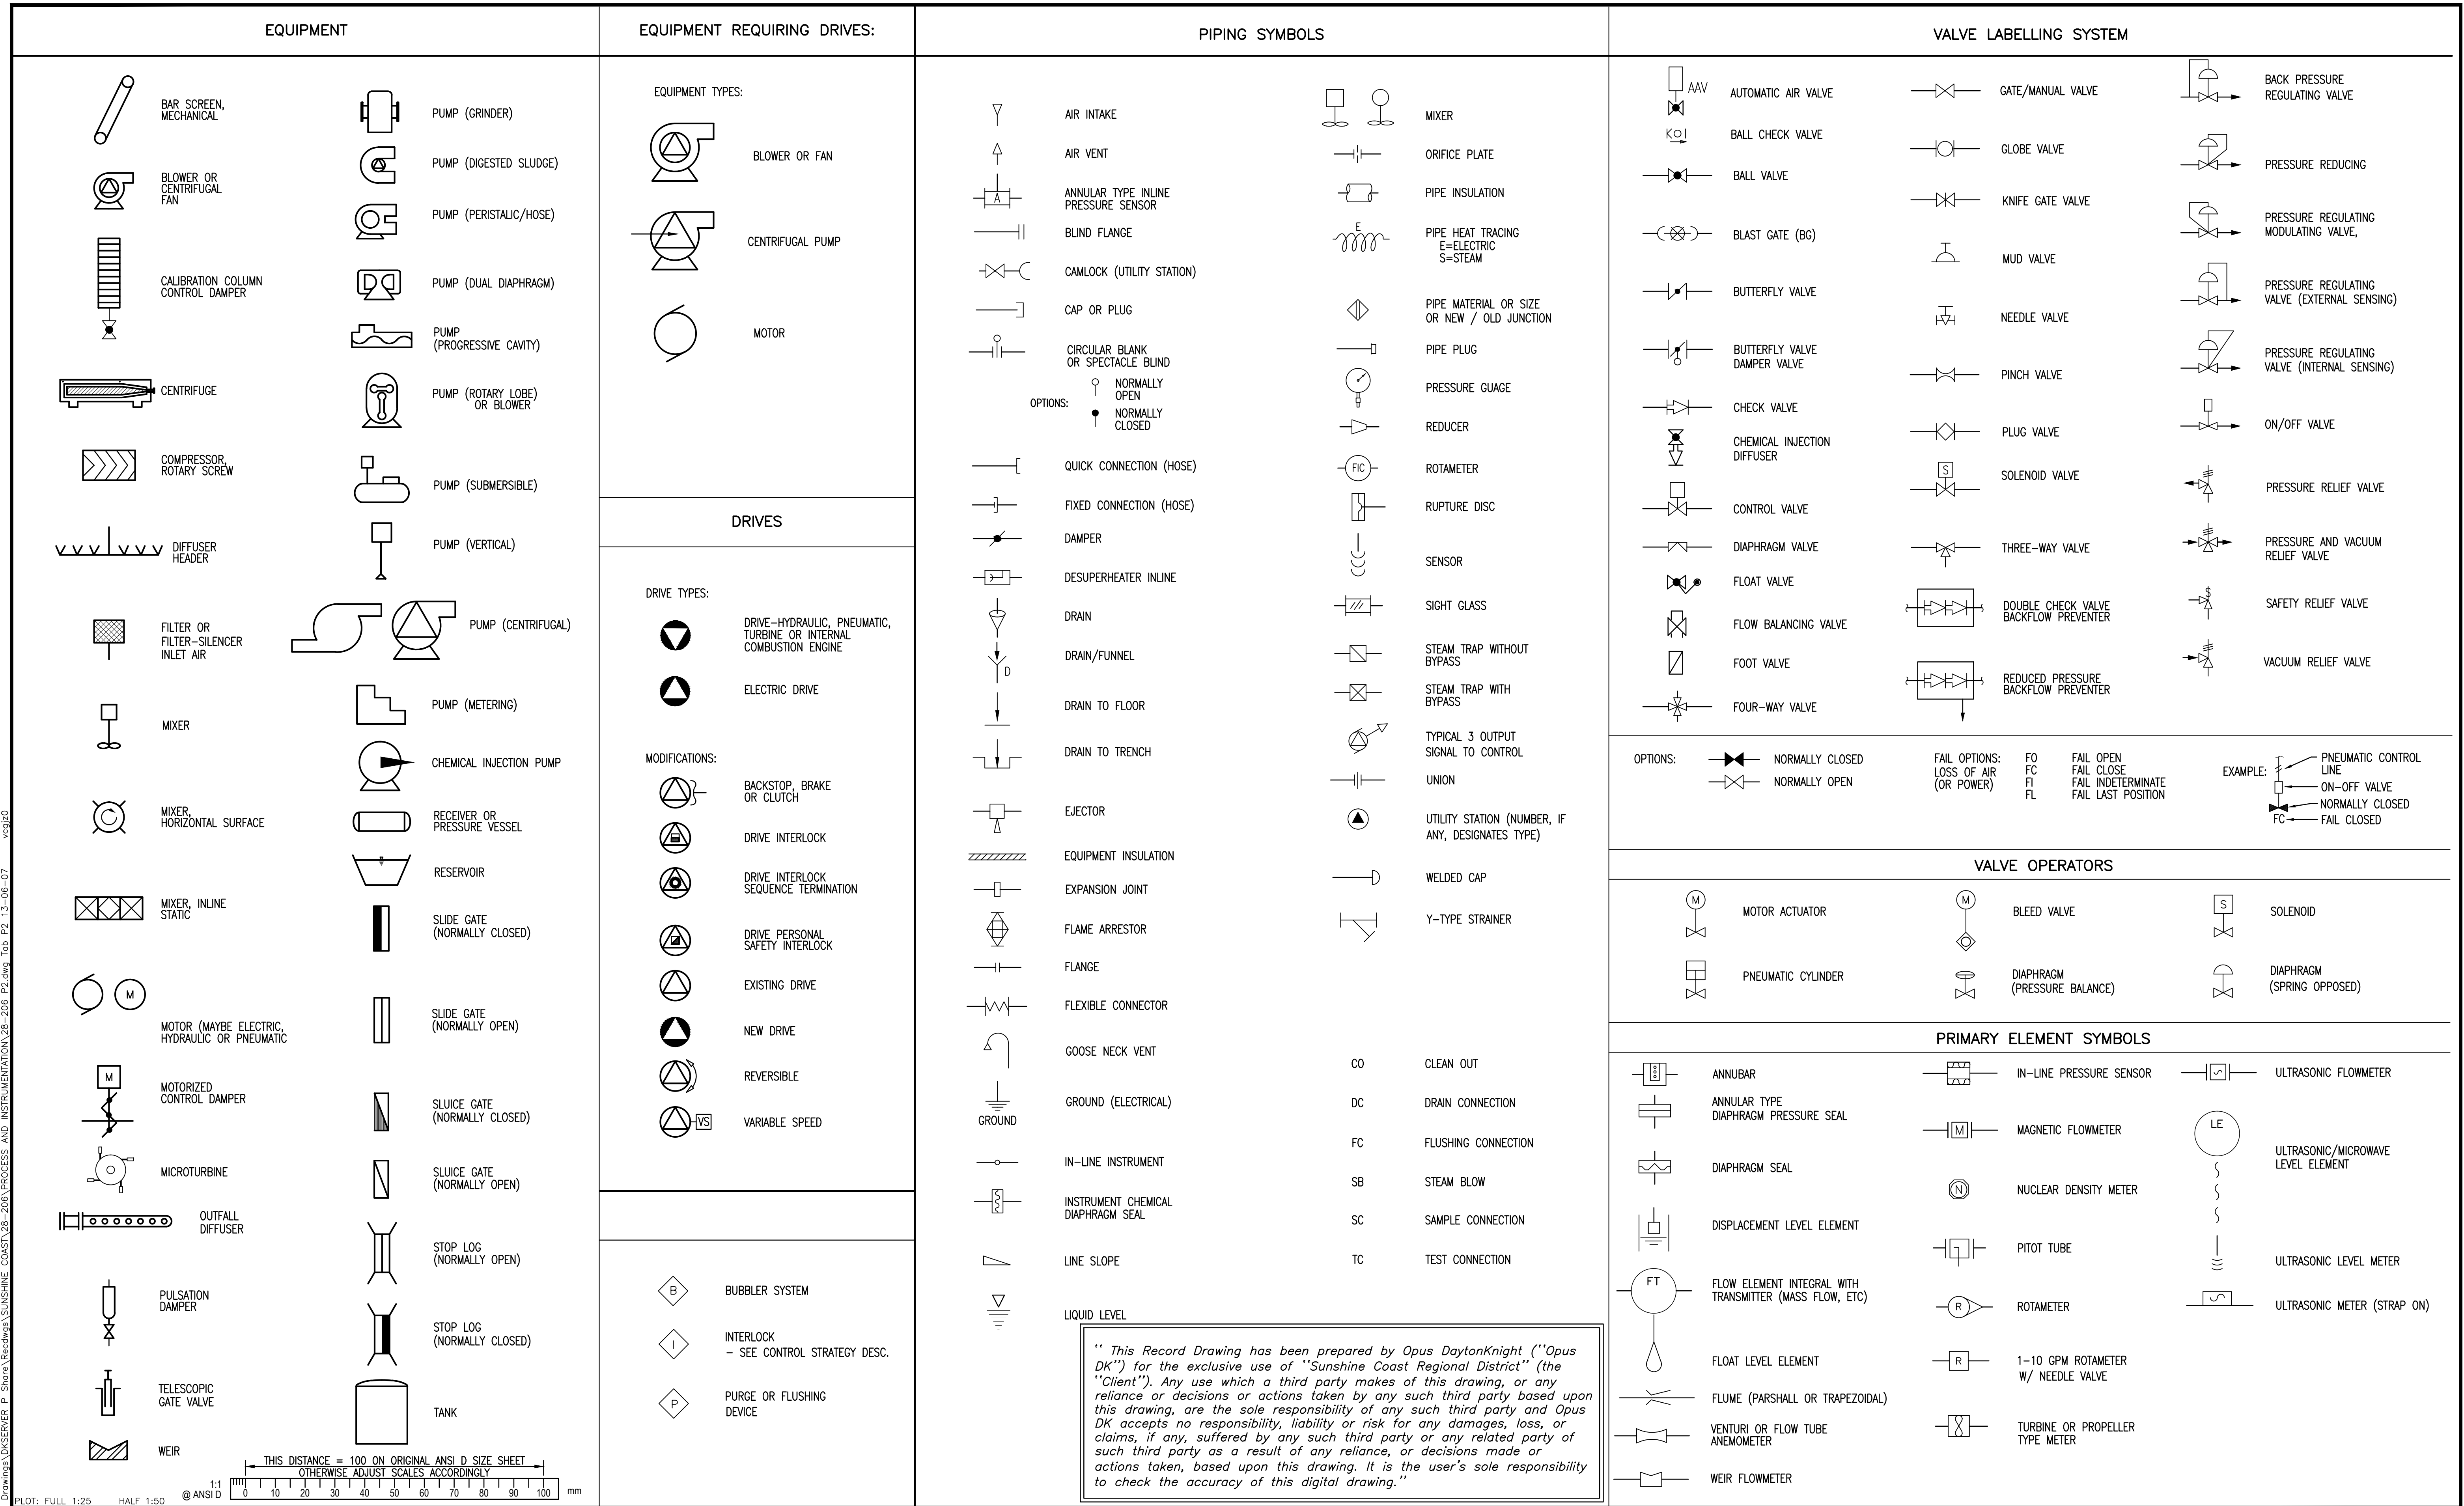

ISSUE	DATE	DRAWN	CHK'D	APP'D	DESCRIPTION
A	JAN27/12	AIS	WB	WB	ISSUED FOR TENDER
B	APR25/12	AIS	WB	WB	ISSUED FOR CONSTRUCTION
C	MAY08/13	RB	WB	WB	RECORD DRAWING

ISSUE	DATE	DRAWN	CHK'D	APP'D	DESCRIPTION


DESIGNED WB
 DRAWN AIS
 CHECKED WB

OPUS DAYTONKNIGHT
 North Vancouver Office
 604-990-4800
 210-889 Harbourside Drive
 North Vancouver BC
 V7P 3S1, Canada


SUNSHINE COAST REGIONAL DISTRICT
 GARDEN BAY UV BUILDING
P&ID STANDARD SYMBOLS, EQUIPMENTS, VALVES AND INSTRUMENTATION

SCALE: NTS	DRAWING No. 028.206
SHEET No. P2	ISSUE C

FILE: G:\D&K CAD Drawings\LINKSERVER P. Shera\Records\SUNSHINE COAST\28-206\PROCESS AND INSTRUMENTATION\28-206 P3.dwg Tab P3 13-06-07 vcsjpd

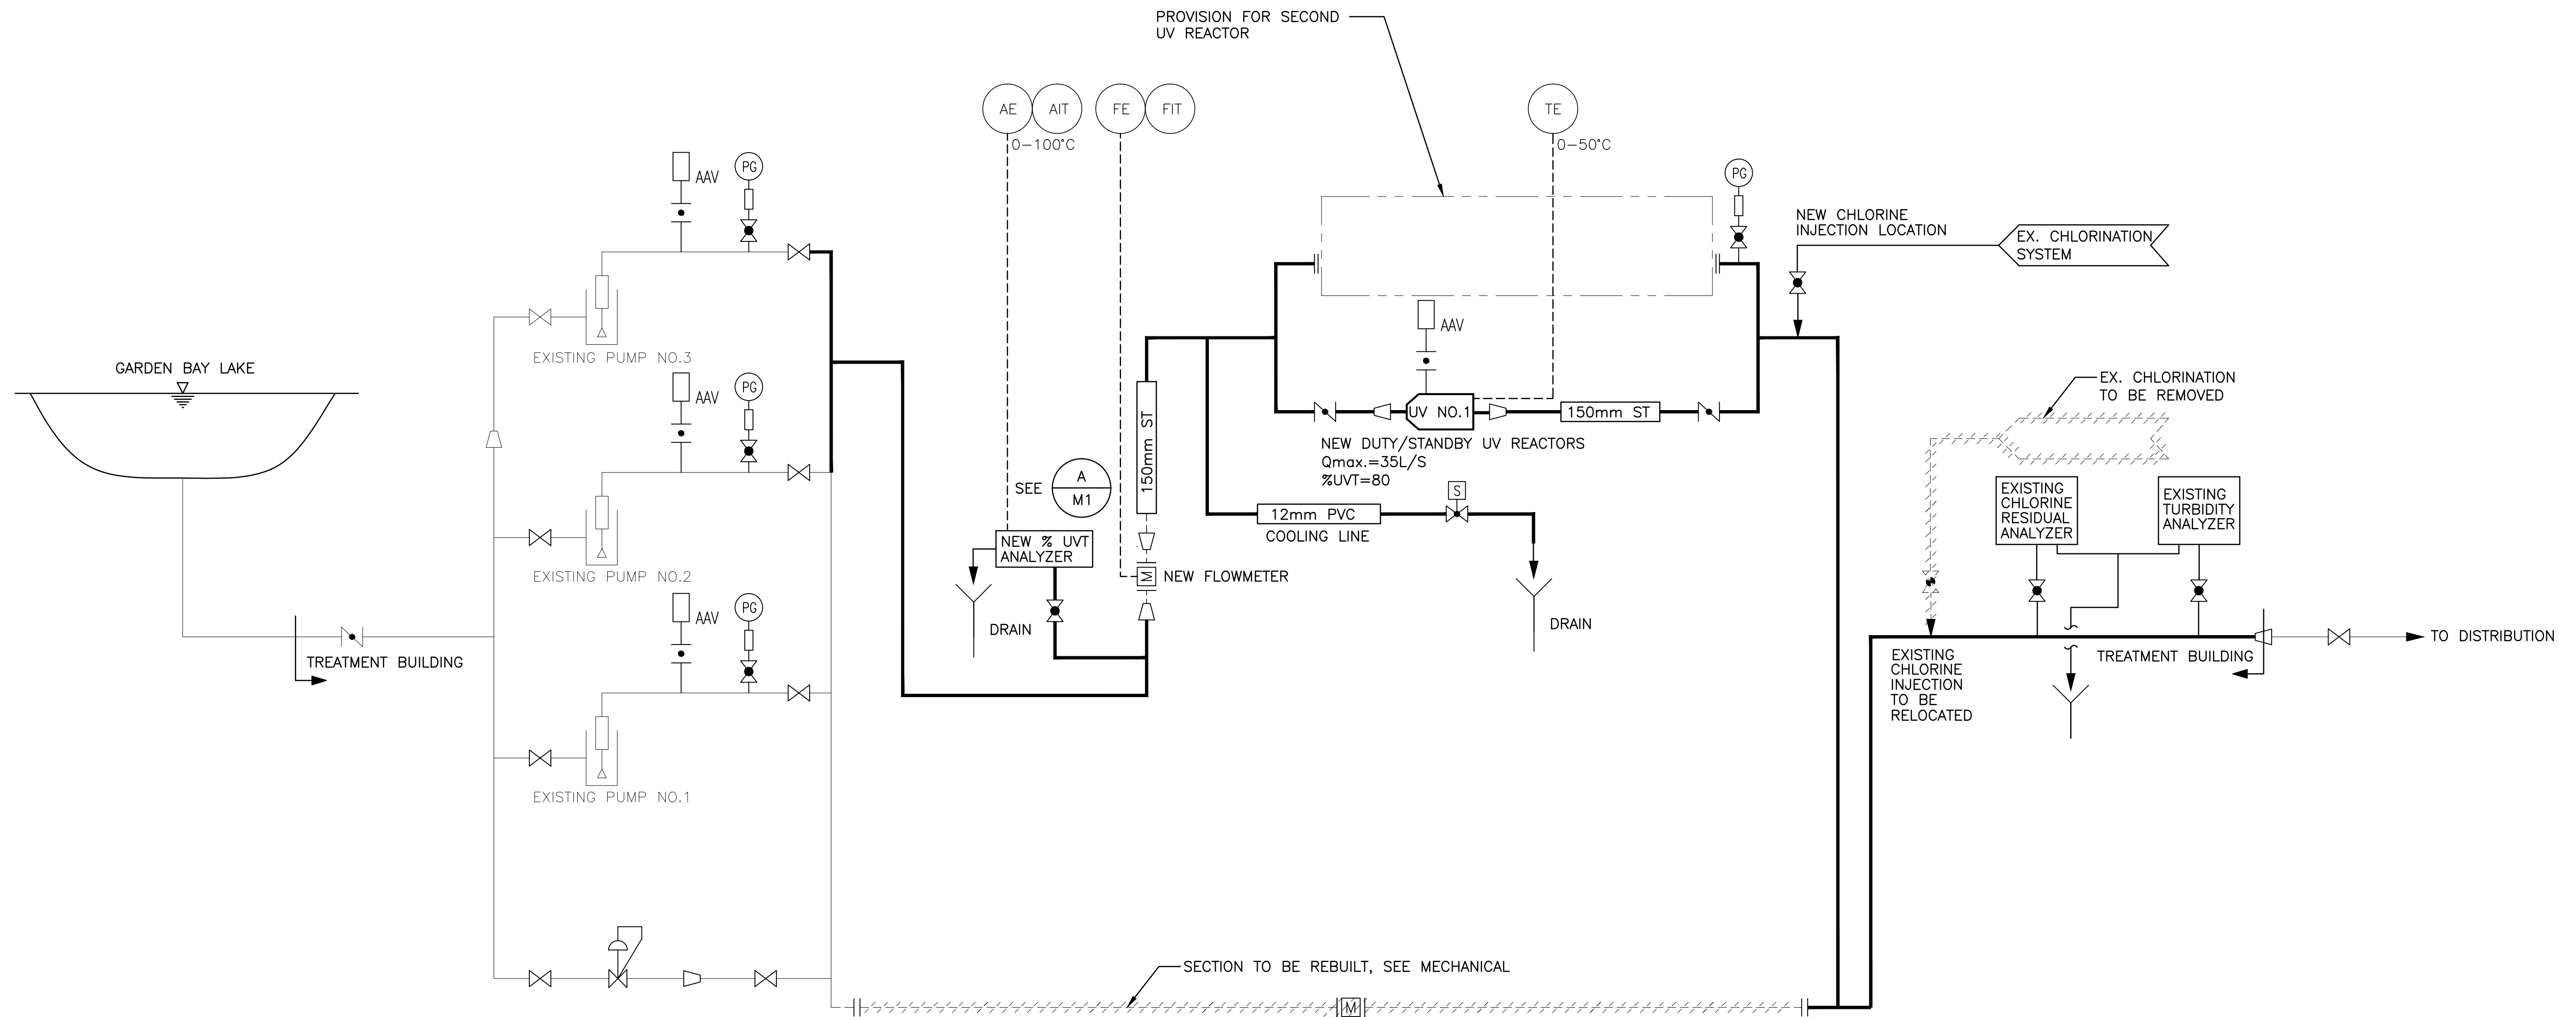


" This Record Drawing has been prepared by Opus DaytonKnight ("Opus DK") for the exclusive use of "Sunshine Coast Regional District" (the "Client"). Any use which a third party makes of this drawing, or any reliance or decisions or actions taken by any such third party based upon this drawing, are the sole responsibility of any such third party and Opus DK accepts no responsibility, liability or risk for any damages, loss, or claims, if any, suffered by any such third party or any related party of such third party as a result of any reliance, or decisions made or actions taken, based upon this drawing. It is the user's sole responsibility to check the accuracy of this digital drawing."

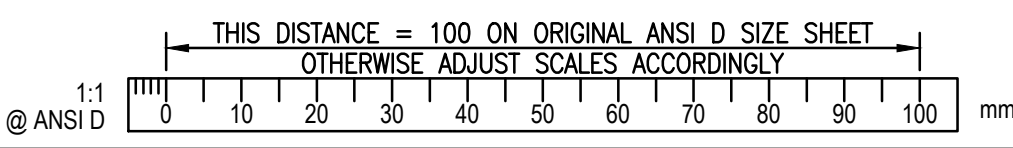

PLOT: FULL 1:25 HALF 1:50 AutoCAD DRAWING REVISIONS A JAN27/12 AIS WB WB ISSUED FOR TENDER B APR25/12 AIS WB WB ISSUED FOR CONSTRUCTION C MAY14/13 MMc WB WB RECORD DRAWING	<table border="1"> <thead> <tr> <th>ISSUE</th> <th>DATE</th> <th>DRAWN</th> <th>CHK'D</th> <th>APP'D</th> <th>DESCRIPTION</th> </tr> </thead> <tbody> <tr> <td> </td> <td> </td> <td> </td> <td> </td> <td> </td> <td> </td> </tr> <tr> <td> </td> <td> </td> <td> </td> <td> </td> <td> </td> <td> </td> </tr> <tr> <td> </td> <td> </td> <td> </td> <td> </td> <td> </td> <td> </td> </tr> </tbody> </table>	ISSUE	DATE	DRAWN	CHK'D	APP'D	DESCRIPTION																			DESIGNED <u>WB</u> DRAWN <u>AIS</u> CHECKED <u>WB</u>	OPUS DAYTONKNIGHT North Vancouver Office 604-990-4800 210-889 Harbourside Drive North Vancouver BC V7P 3S1, Canada	SUNSHINE COAST REGIONAL DISTRICT GARDEN BAY UV BUILDING PROCESS AND INSTRUMENTATION DIAGRAM	SCALE: NTS DRAWING No. 028.206 SHEET No. P3 ISSUE C
ISSUE	DATE	DRAWN	CHK'D	APP'D	DESCRIPTION																								

FILE: G:\D&K CAD Drawings\DKSERVER\ P. Shira\Records\SUNSHINE COAST\28-206\Architectural\28-206-A1.dwg Tab. A1 13-06-11 .xgs\$D

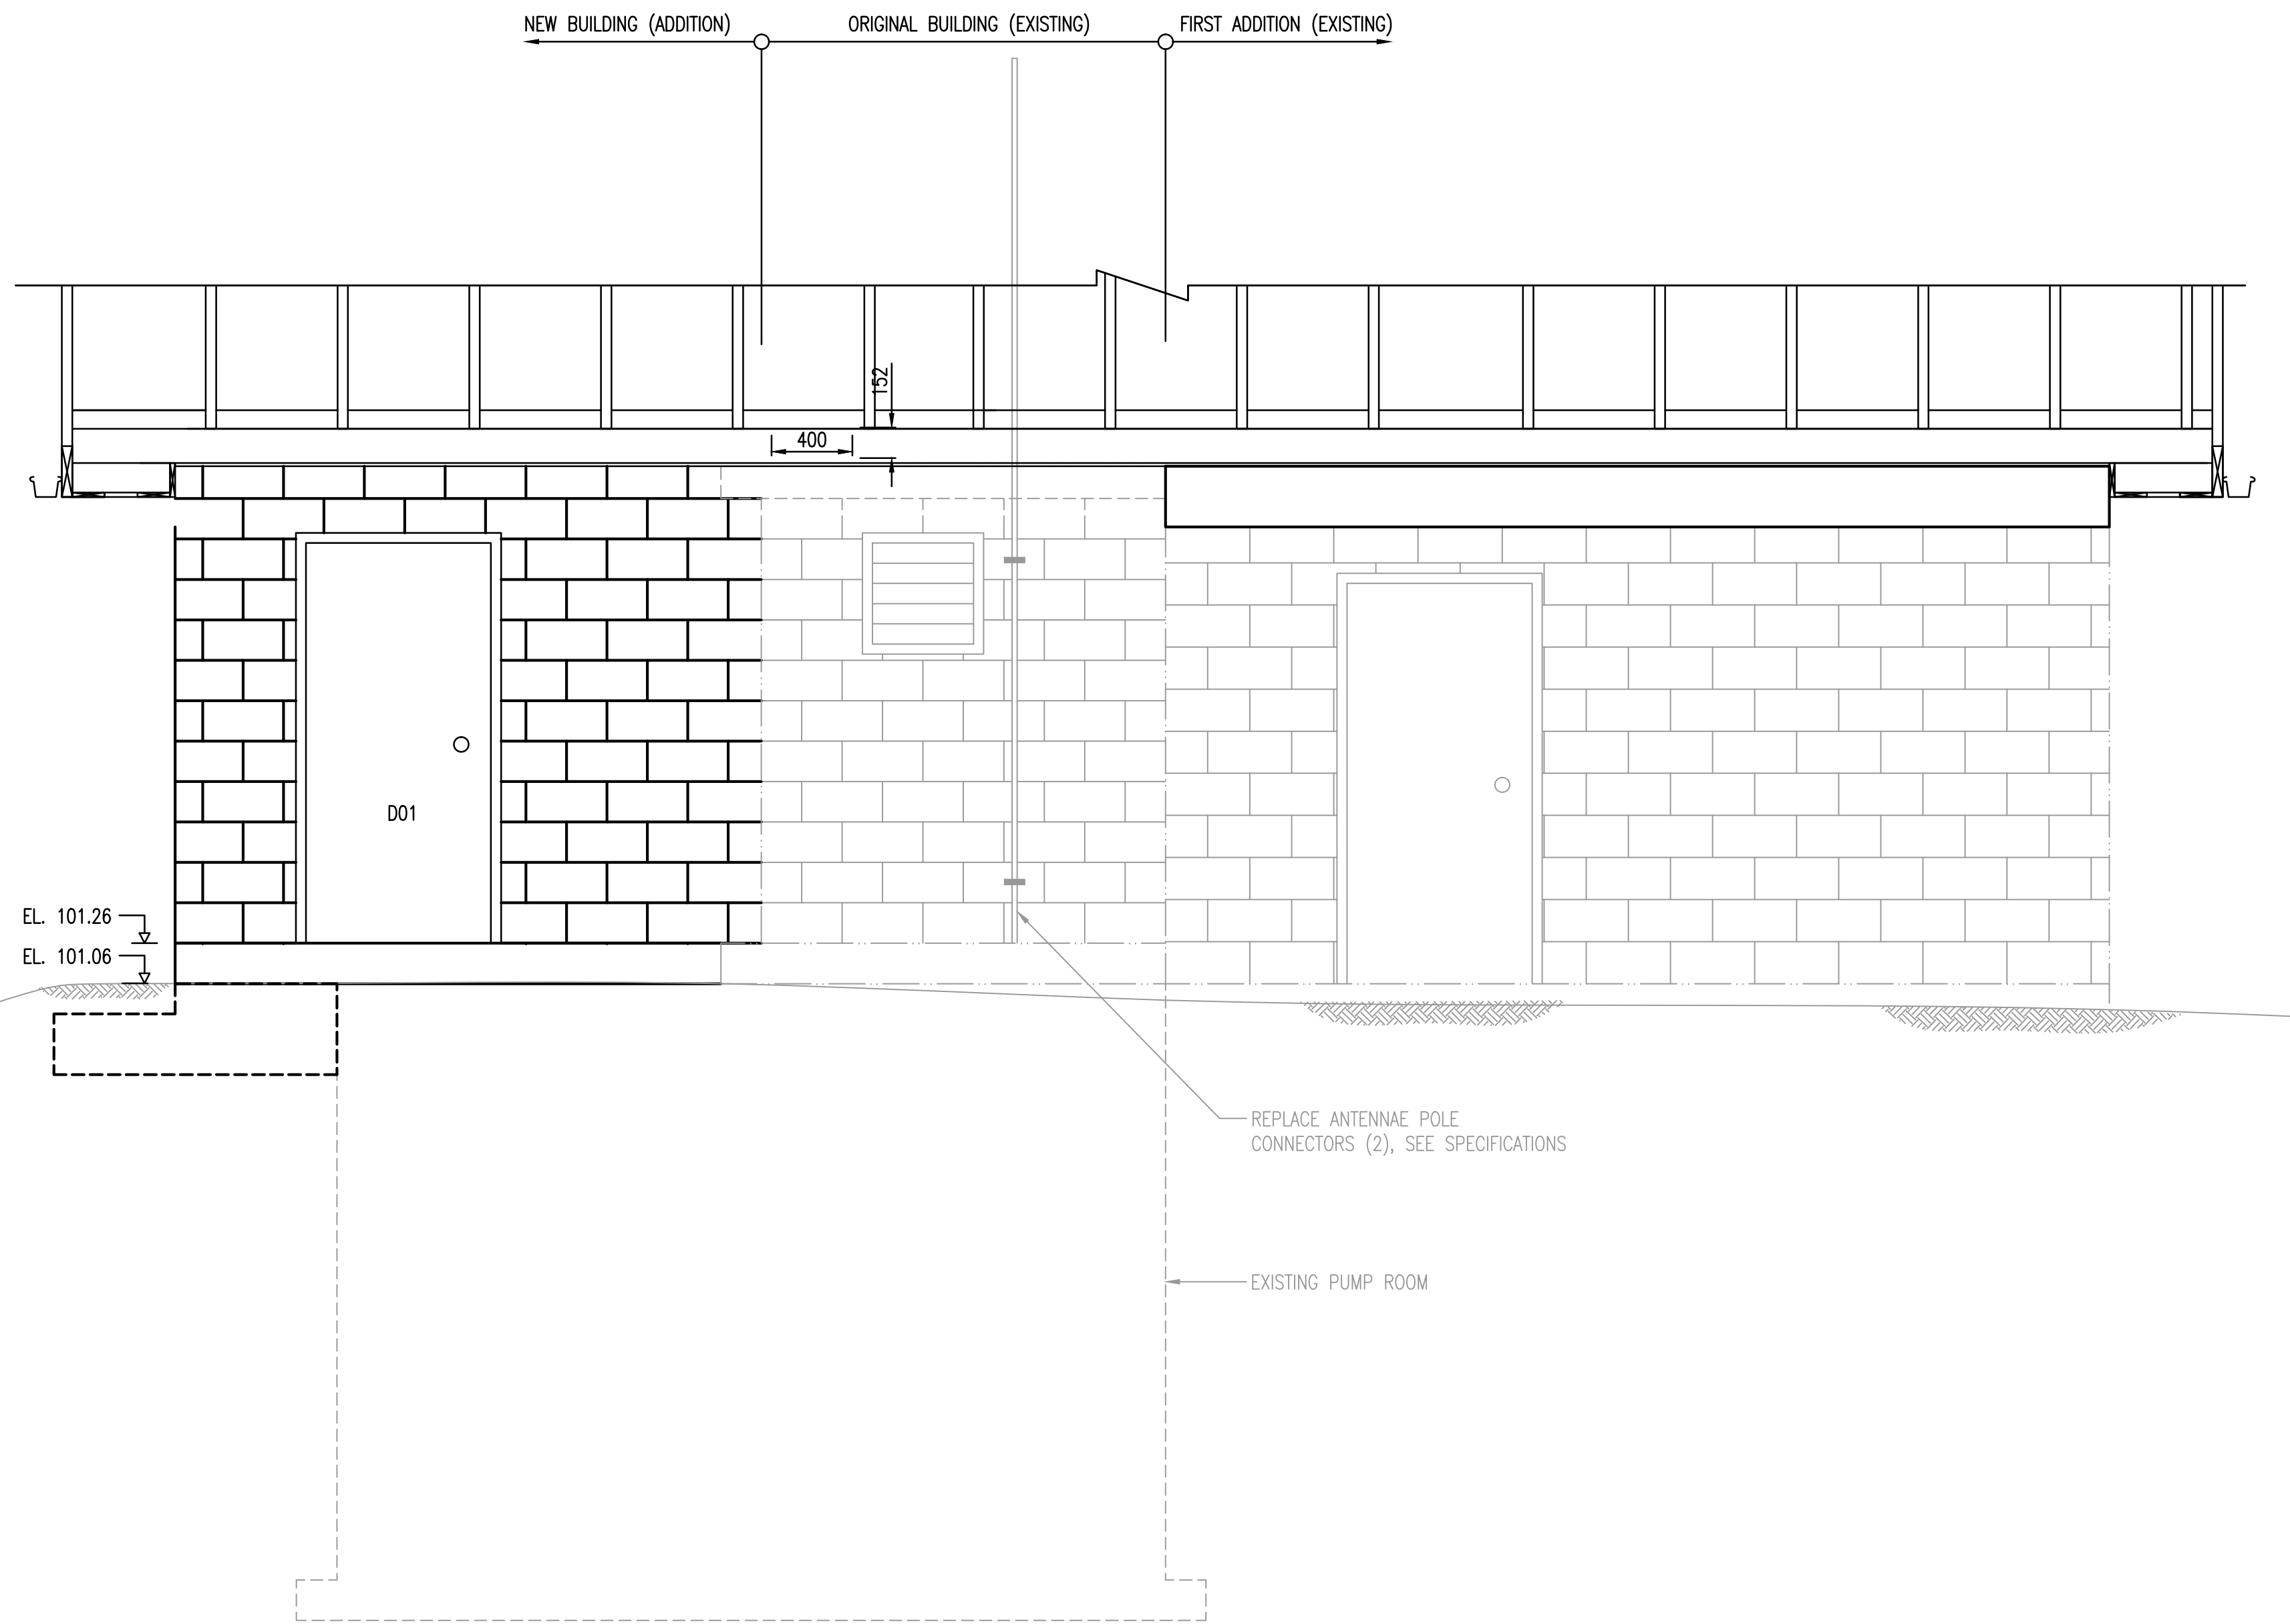


WEST ELEVATION
1:25



DOOR SCHEDULE				
DOOR NO.	WIDTH	HEIGHT	THICK	FRAME
D01	915	2032	45	50 x 146
1. SEE SPECIFICATION FOR MATERIALS AND HARDWARE.				

NOTE:
THE BOTTOM OF THE PARAPET WALL SHALL BE ALIGNED AT AN ELEVATION THAT WILL MEET THE FOLLOWING CLEARANCES:
- MIN. 25mm ABOVE NEW DOOR FRAME

" This Record Drawing has been prepared by Opus DaytonKnight ("Opus DK") for the exclusive use of "Sunshine Coast Regional District" (the "Client"). Any use which a third party makes of this drawing, or any reliance or decisions or actions taken by any such third party based upon this drawing, are the sole responsibility of any such third party and Opus DK accepts no responsibility, liability or risk for any damages, loss, or claims, if any, suffered by any such third party or any related party of such third party as a result of any reliance, or decisions made or actions taken, based upon this drawing. It is the user's sole responsibility to check the accuracy of this digital drawing."

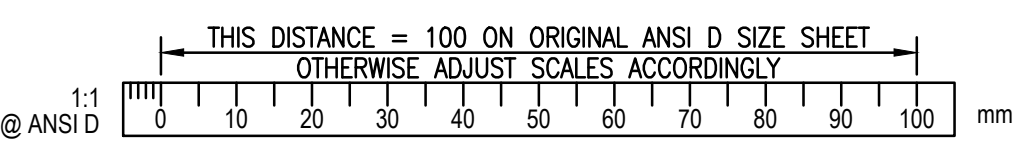


PLOT: FULL 1:25 HALF 1:50 AutoCAD DRAWING REVISIONS A JAN27/12 AIS MR MR ISSUED FOR TENDER B APR25/12 AIS MR MR ISSUED FOR CONSTRUCTION C MAY15/13 MMc WB WB RECORD DRAWING	ISSUE DATE DRAWN CHK'D APP'D DESCRIPTION ISSUE DATE DRAWN CHK'D APP'D DESCRIPTION	DESIGNED MR DRAWN AIS CHECKED MR	OPUS DAYTONKNIGHT North Vancouver Office 604-990-4800 210-889 Harbourside Drive North Vancouver BC V7P 3S1, Canada	SUNSHINE COAST REGIONAL DISTRICT GARDEN BAY UV BUILDING ARCHITECTURAL - WEST ELEVATION	SCALE: AS SHOWN DRAWING No. 028.206 SHEET No. A1 ISSUE C
--------------------------------------------------------------------------------------------------------------------------------------------------------------------------------------------	--------------------------------------------------------------------------------------	----------------------------------------	---------------------------------------------------------------------------------------------------------------------------------	----------------------------------------------------------------------------------------------	----------------------------------------------------------------

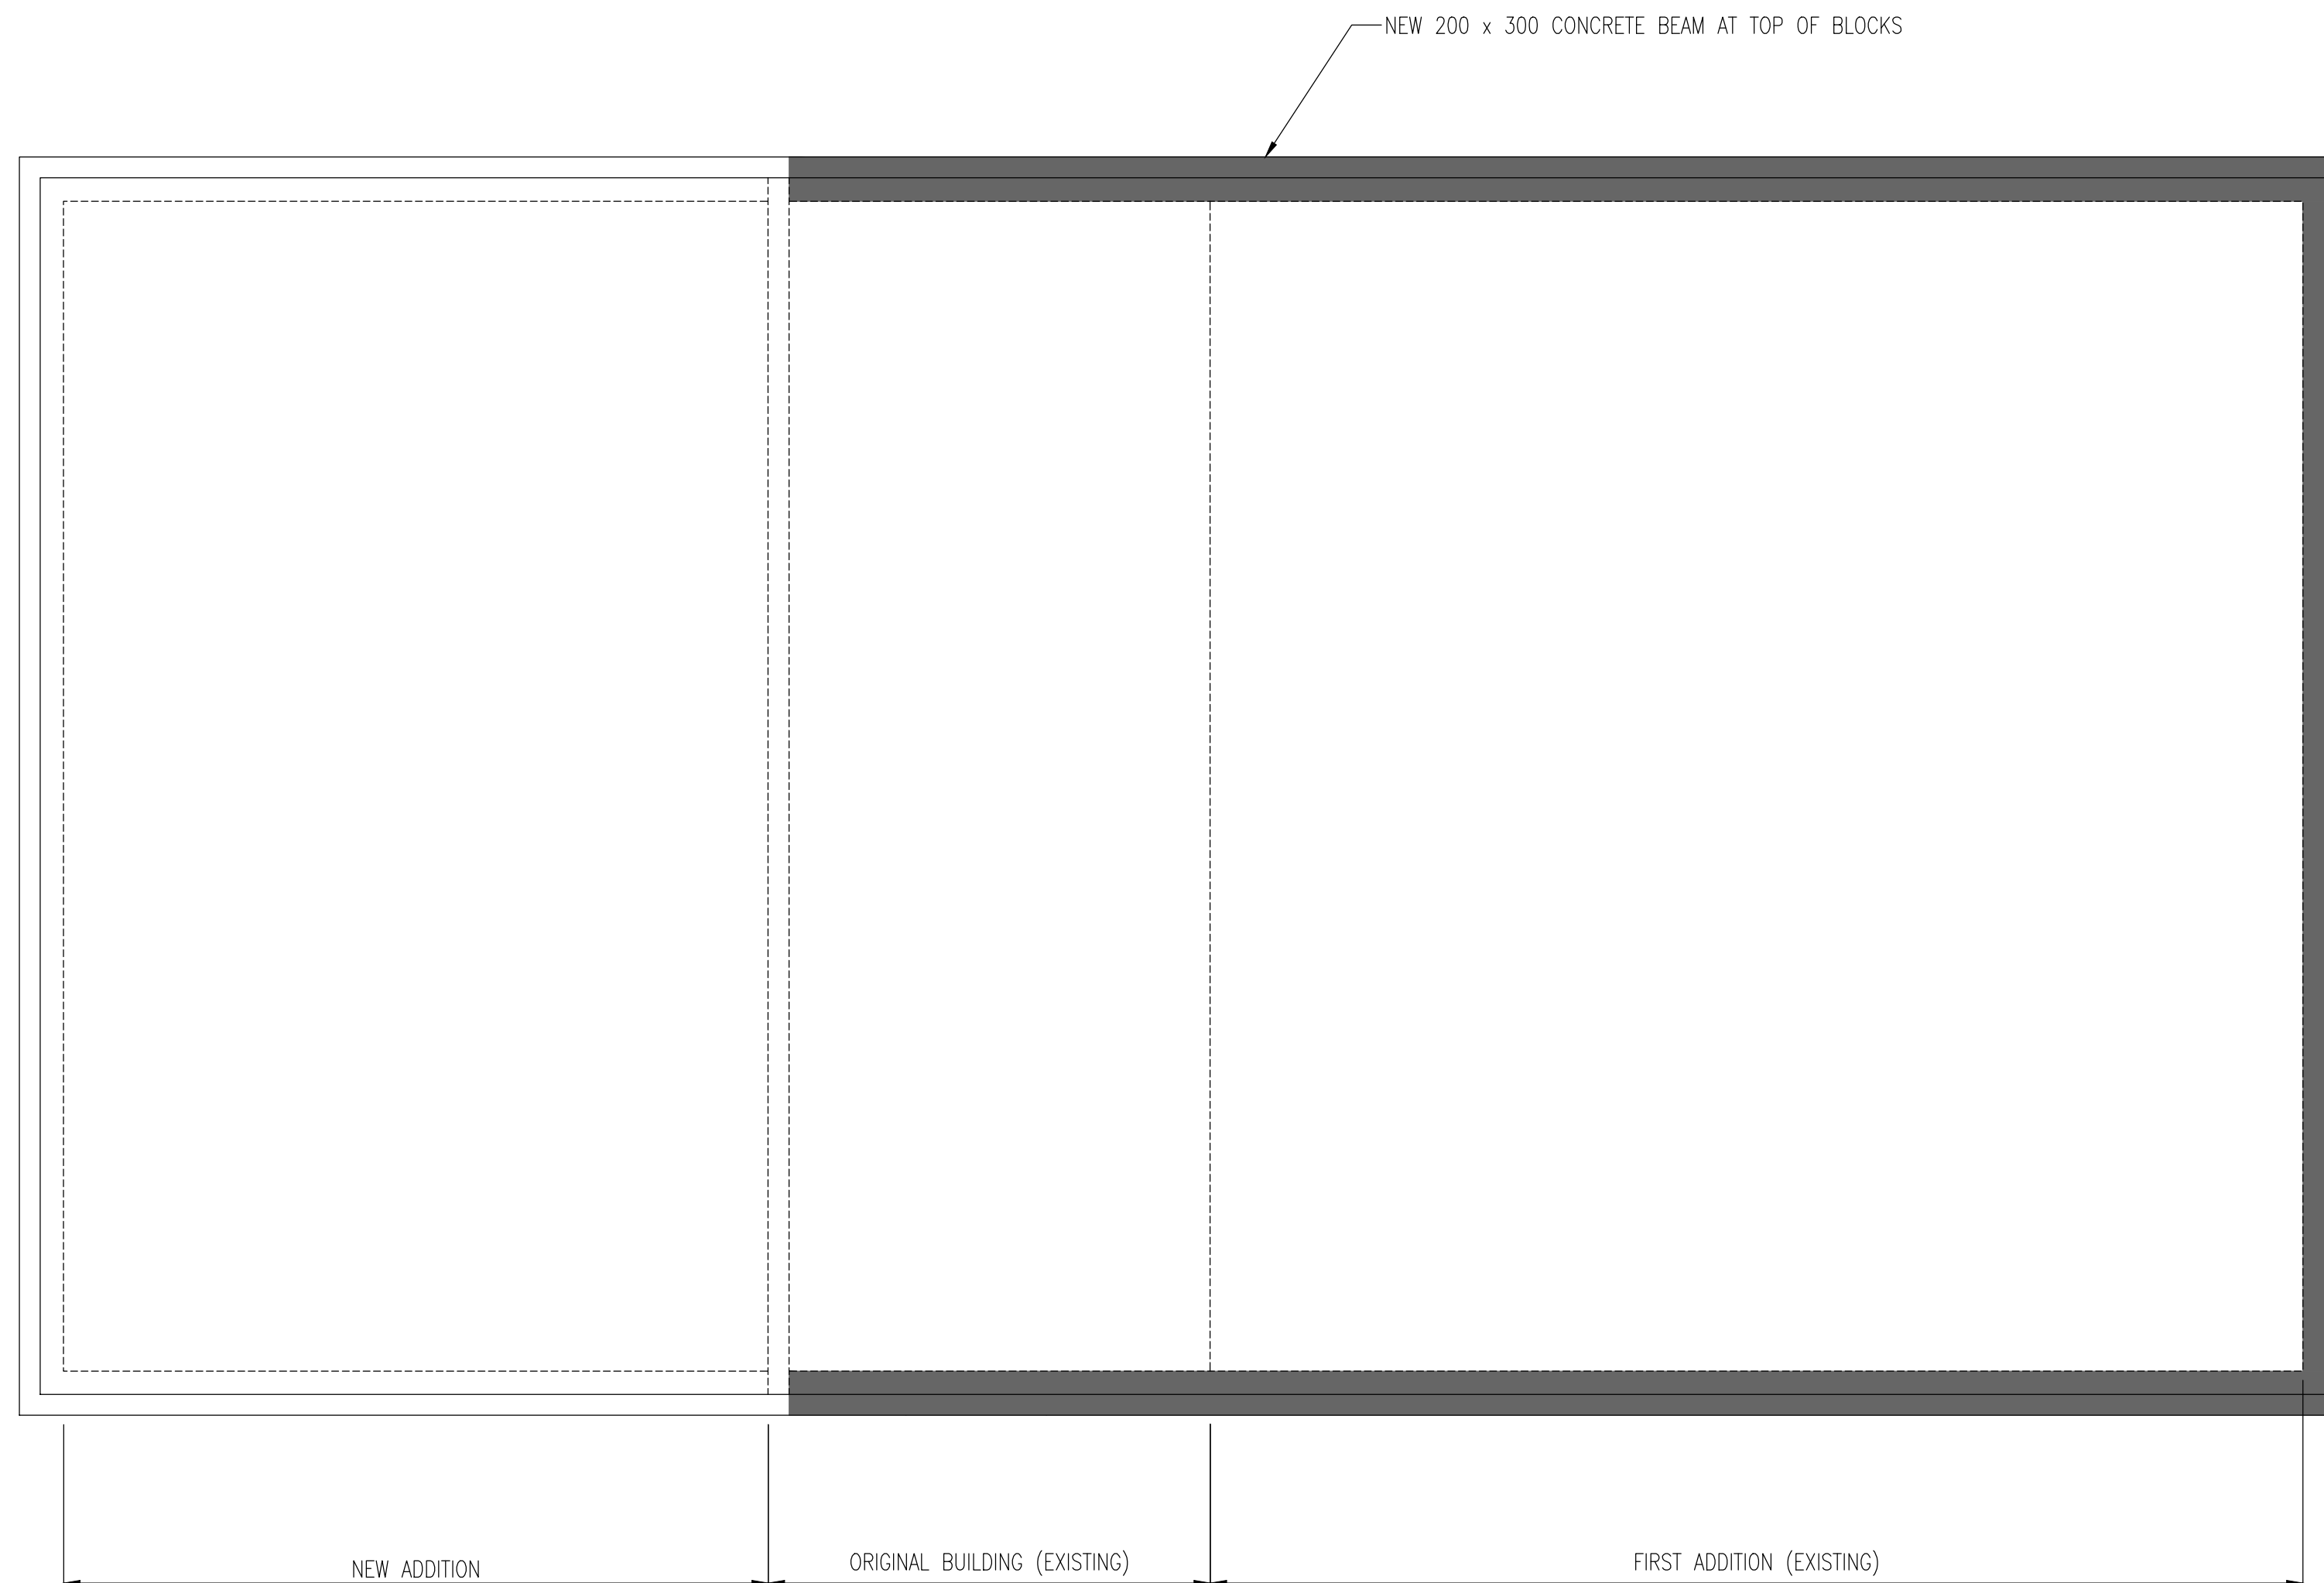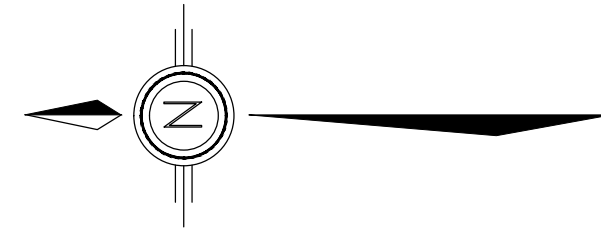

ROOF PLAN
1:25

" This Record Drawing has been prepared by Opus DaytonKnight ("Opus DK") for the exclusive use of "Sunshine Coast Regional District" (the "Client"). Any use which a third party makes of this drawing, or any reliance or decisions or actions taken by any such third party based upon this drawing, are the sole responsibility of any such third party and Opus DK accepts no responsibility, liability or risk for any damages, loss, or claims, if any, suffered by any such third party or any related party of such third party as a result of any reliance, or decisions made or actions taken, based upon this drawing. It is the user's sole responsibility to check the accuracy of this digital drawing."

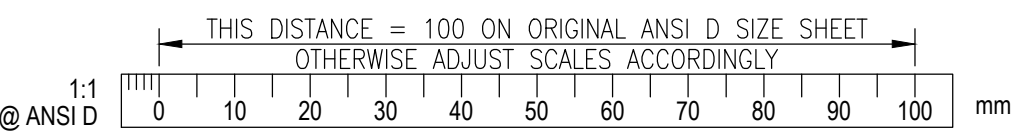

FILE: G:\DKK CAD Drawings\DKKSERVER P - Shire\Records\SUNSHINE COAST\28-206-A2.dwg Tab: A2 13-06-07 .xgs3D

AutoCAD
DRAWING

ISSUE	DATE	DRAWN	CHK'D	APP'D	DESCRIPTION
A	JAN27/12	AIS	MR	MR	ISSUED FOR TENDER
B	APR25/12	AIS	MR	MR	ISSUED FOR CONSTRUCTION
C	MAY14/13	MMc	WB	WB	RECORD DRAWING

ISSUE	DATE	DRAWN	CHK'D	APP'D	DESCRIPTION

DESIGNED MR
DRAWN AIS
CHECKED MR

OPUS DAYTONKNIGHT
North Vancouver Office
604-990-4800
210-889 Harbourside Drive
North Vancouver BC
V7P 3S1, Canada

SUNSHINE COAST REGIONAL DISTRICT
GARDEN BAY UV BUILDING
ARCHITECTURAL – ROOF PLAN

SCALE: AS SHOWN		
DRAWING No. 028.206		
SHEET No.	A2	ISSUE C

GENERAL CONSTRUCTION NOTES

GENERAL NOTES

- SCOPE :** THE NOTES AND DETAILS ON THIS SHEET ARE GENERAL AND APPLY TO THE ENTIRE PROJECT EXCEPT WHERE THERE ARE SPECIFIC INDICATIONS TO THE CONTRARY.
- APPLICABLE SPECIFICATIONS AND CODES :** CONSTRUCTION SHALL BE IN ACCORDANCE WITH THE LATEST EDITION OF THE NATIONAL BUILDING CODE EXCEPT WHERE OTHER APPLICABLE CODES OR THE FOLLOWING NOTES ARE MORE RESTRICTIVE.
- DIMENSIONS :** STRUCTURAL DIMENSIONS CONTROLLED BY OR RELATED TO MECHANICAL OR ELECTRICAL EQUIPMENT SHALL BE VERIFIED BY THE CONTRACTOR PRIOR TO CONSTRUCTION.
- PROVISIONS FOR EQUIPMENT :** MECHANICAL AND ELECTRICAL EQUIPMENT SUPPORTS, ANCHORAGES, OPENINGS, RECESSES AND REVEALS NOT SHOWN ON THE STRUCTURAL DRAWINGS BUT REQUIRED BY OTHER CONTRACT DRAWINGS SHALL BE PROVIDED FOR PRIOR TO CASTING CONCRETE.
- CONSTRUCTION LOADS :** STRUCTURES HAVE BEEN DESIGNED FOR OPERATION LOADS ON THE COMPLETED STRUCTURES. DURING CONSTRUCTION, THE STRUCTURES SHALL BE PROTECTED BY BRACING AND BALANCING WHEREVER EXCESSIVE CONSTRUCTION LOADS MAY OCCUR. ALL TEMPORARY AND PERMANENT SURCHARGE LOADS SHALL BE CONSIDERED.
- THE CONTRACTOR IS RESPONSIBLE FOR SHORING AND UNDERPINNING. DOCUMENTS RELATING TO THIS WORK SHALL BE SEALED AND SIGNED BY A BRITISH COLUMBIA PROFESSIONAL ENGINEER.
- DRAINAGE SURFACES :** FLOOR ELEVATIONS SHOWN ON CONCRETE OUTLINE DRAWINGS ARE PERIMETER ELEVATIONS FOR STRUCTURAL SLABS AND MAY NOT INDICATE FLOOR SLOPES, TOPPING OR FLOOR ELEVATIONS. FOR AREAS REQUIRING FLOOR SLOPES, TOPPING AND FLOOR DRAIN (ELEVATIONS AND LOCATIONS), SEE ARCHITECTURAL AND MECHANICAL DRAWINGS.

f _c = 30 MPa f _y = 400 MPa	BAR SIZE	MINIMUM STRAIGHT EMBEDMENT DEVELOPMENT LENGTHS (mm)		MINIMUM TENSION EMBEDMENT WITH STANDARD END HOOKS E
		COMPRESSION	TENSION	
	10M	200	300	200
15M	280	450	200	
20M	340	600	220	
25M	440	1000	450	
30M	530	1200	630	

f _c = 30 MPa f _y = 400 MPa	BAR SIZE	LAP SPLICE LENGTHS (mm)	
		TENSION	COMPRESSION
	10M	400	300
15M	600	450	
20M	800	600	
25M	1200	750	
30M	1600	900	

STEEL

- APPLICABLE SPECIFICATIONS AND CODES :** STEEL CONSTRUCTION SHALL CONFORM TO CSA S16 "STEEL STRUCTURES FOR BUILDINGS" AS CONTAINED IN THE NATIONAL BUILDING CODE.
- BOLTED JOINTS :** EXCEPT FOR BOLTS ANCHORED IN CONCRETE, BOLTED JOINTS SHALL CONFORM TO THE SPECIFICATIONS OF THE CANADIAN INSTITUTE OF STEEL CONSTRUCTION. BOLTS SHALL BE AS SPECIFIED ON THE DRAWINGS, OR, AT LEAST 13mm DIAMETER IF NOT SPECIFIED ON THE DRAWINGS.
- ANCHOR BOLTS :** BOLTS ANCHORED IN CONCRETE, IF NOT SPECIFIED ON THE DRAWINGS, SHALL BE 13mm DIAMETER WITH 225mm EMBEDDED AND SHALL CONFORM TO ASTM A-36.
- ENCASED STEEL :** STEEL COMPLETELY ENCASED IN CONCRETE SHALL NOT BE PAINTED AND SHALL HAVE A CLEAN SURFACE FOR BONDING TO CONCRETE.

ALUMINUM

- APPLICABLE SPECIFICATIONS AND CODES :** ALUMINUM CONSTRUCTION SHALL CONFORM TO CAN3-S157 "STRENGTH DESIGN IN ALUMINUM" AS SPECIFIED IN THE NATIONAL BUILDING CODE.
- ALUMINUM PLACED IN CONTACT WITH CONCRETE, MORTAR, PLASTER OR DISSIMILAR METALS SHALL BE GIVEN A PROTECTIVE SEALING COAT OF ZINC CHROMATE EPOXY OR ALKALI-RESISTANT BITUMINOUS PAINT.

MASONRY

- APPLICABLE SPECIFICATIONS AND CODES :** MASONRY CONSTRUCTION SHALL CONFORM TO CAN3-S157 AS SPECIFIED IN THE NATIONAL BUILDING CODE.
- VERTICAL REINFORCING SHALL BE 1 - 15M BARS FOR FULL HEIGHT OF WALL IN A CAVITY AT MAXIMUM 0.60 METRE SPACING C/C AND AT ALL CORNERS, AND 1-15M ADJACENT TO OPENINGS LARGER THAN 600mm.
- HORIZONTAL REINFORCING SHALL BE "DURWALL" OR "WAL-LOK" STANDARD WT BRIGHT FINISH AT 400mm SPACING AND 2-15M HORIZONTAL REINFORCING CONTINUOUS IN BOND BEAMS SPACED 1200 C/C AND IN LINTELS FOR OPENINGS OF LESS THAN 1200 WITH 400 BEARINGS ON BOTH SIDES OF OPENINGS.
- FOR MORE INFORMATION SEE S3 DRAWING.

CONCRETE

- APPLICABLE SPECIFICATIONS AND CODES :** CONCRETE CONSTRUCTION SHALL CONFORM TO CSA 23.3-04 "DESIGN OF CONCRETE STRUCTURES FOR BUILDING" AS SPECIFIED IN THE NATIONAL BUILDING CODE OF CANADA 2005.
- REINFORCING STEEL DETAILS :** ALL DETAILING, FABRICATING AND ERECTION OF STEEL REINFORCING BARS, UNLESS OTHERWISE NOTED, SHALL BE IN ACCORDANCE WITH THE "METRIC SUPPLEMENT" IN CONJUNCTION WITH THE "REINFORCING STEEL MANUAL OF STANDARD PRACTICE", AS AVAILABLE FROM THE WESTERN REINFORCING CONTRACTORS ASSOCIATION.
- MINIMUM REINFORCING :** CONCRETE CONSTRUCTION SHALL BE REINFORCED CONCRETE EXCEPT WHERE PLAIN CONCRETE (P/C) IS SPECIFIED ON THE DRAWINGS, IN WHICH CASE NO REINFORCEMENT SHALL BE USED. CONCRETE THAT IS NOT DESIGNATED P/C AND HAS NO REINFORCEMENT INDICATED SHALL BE REINFORCED ACCORDING TO THE FOLLOWING SCHEDULES :
 - STEEL FOR WALLS AND SLABS REINFORCEMENT EACH WAY

THICKNESS	SIZE	SPACING	POSITION
150	10M	300 C/C	ON ϕ
200	15M	300 C/C	ON ϕ
250	15M	300 C/C	EF
300	15M	300 C/C	EF
350	15M	250 C/C	EF
400	20M	300 C/C	EF
450	20M	250 C/C	EF

MASS CONCRETE SHALL BE REINFORCED WITH 15M BARS AT 300 MINIMUM IN ALL FACES.

B) 10M @ 450 SHALL BE USED AS TRANSVERSE TIES IF NO OTHER REINFORCING IS NOTED.

- CONCRETE COVER :** CONCRETE COVER OF REINFORCING BARS, IF NOT SPECIFIED ON THE DRAWINGS, SHALL BE AS FOLLOWS OR SHALL BE EQUAL TO THE DIAMETER OF THE MAIN REINFORCING BAR IT COVERS, WHICHEVER IS LARGER :

CONDITION	SPECIFIED COVER (mm)
A) CONCRETE CAST AGAINST GROUND	75
B) CONCRETE EXPOSED TO EARTH, LIQUIDS OR WEATHER <ol style="list-style-type: none"> 20M BARS OR LARGER 10M AND 15M BARS 	50 40
C) CONCRETE SLABS OR WALLS NOT EXPOSED TO EARTH, LIQUIDS OR WEATHER	20
D) CONCRETE BEAMS OR COLUMNS	50

- REINFORCING BAR DEVELOPMENT AND LAP LENGTHS REINFORCING BAR DEVELOPMENT LENGTH AND LAP SPLICE LENGTHS SHALL BE AS SPECIFIED ON THE DRAWINGS OR IN ACCORDANCE WITH THE FOLLOWING SCHEDULES, WHICHEVER IS THE LONGER LENGTH :

i) DOWELS SHALL BE THE SAME SIZE AND SPACING AS BARS WITH WHICH THEY ARE LAPPED, UNLESS OTHERWISE NOTED.

ii) THE LENGTH OF LAP SPLICE OF BARS OF DIFFERENT DIAMETERS SHALL BE BASED ON THE BAR WITH THE SMALLER DIAMETER.

- STANDARD HOOK :** BARS ENDING IN RIGHT ANGLE BENDS OR HOOKS SHALL CONFORM TO THE REQUIREMENTS OF CSA CAN3-A23.1


- ANCHORAGE :** IF THE EMBEDMENT LENGTH IS LIMITED DUE TO THE LIMITED EXTENT OF THE CONCRETE STRUCTURE, THE BARS SHALL EXTEND AS FAR AS POSSIBLE AND END IN STANDARD HOOKS.

WOOD

- ALL LUMBER AND WOOD PRODUCTS SHALL CONFORM TO B.C.B.C. 2006 PART 9 SECTION 9.3.2 "GRADES", 9.4.1 "GENERAL DESIGN", 9.4.2 "SNOWLOADS" AND 9.4.3 "DEFLECTIONS".
- BUILDINGS AND THEIR STRUCTURAL MEMBERS MADE OF WOOD SHALL CONFORM TO CAN3-086 "ENGINEERING DESIGN IN WOOD, (WORKING STRESS DESIGN)", OR CAN/CSA 086.1 "ENGINEERING DESIGN IN WOOD, (LIMIT STATE DESIGN)".
- WOOD FRAME CONSTRUCTION SHALL CONFORM TO B.C.B.C. 2006 PART 9 SECTION 9.23
- WOOD TRUSSES SHALL BE DESIGNED, BUILT AND INSTALLED IN CONFORMANCE WITH B.C.B.C. 2006 PART 9 SECTION 9.23.13.11 "ROOF TRUSSES".

NOTE :
WHERE DETAIL(S) SHOWN ON THE DRAWINGS DIFFER FROM THE DETAILS SHOWN ON THIS SHEET (S1), THEN THE DRAWING HAS PRIORITY.


STRUCTURAL LEGEND

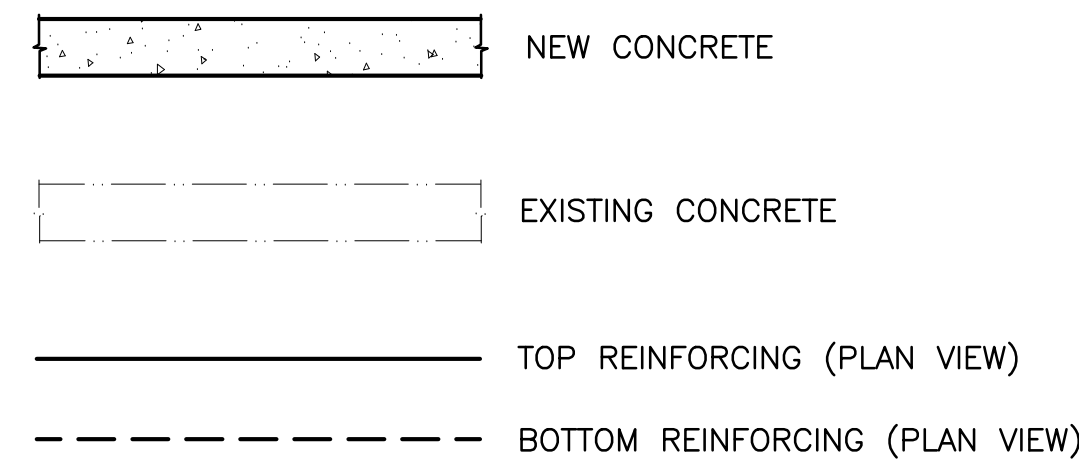


" This Record Drawing has been prepared by Opus DaytonKnight ("Opus DK") for the exclusive use of "Sunshine Coast Regional District" (the "Client"). Any use which a third party makes of this drawing, or any reliance or decisions or actions taken by any such third party based upon this drawing, are the sole responsibility of any such third party and Opus DK accepts no responsibility, liability or risk for any damages, loss, or claims, if any, suffered by any such third party or any related party of such third party as a result of any reliance, or decisions made or actions taken, based upon this drawing. It is the user's sole responsibility to check the accuracy of this digital drawing."

NOTES :

- FOR LOCATION OF PIPING, FLOOR DRAINS, ELECTRICAL / INSTRUMENTATION CONDUIT, VENTILATION DUCTS WHICH PASS THROUGH CONCRETE SLABS, WALLS AND/OR ROOFS, REFER TO THE MECHANICAL, VENTILATION, ELECTRICAL AND INSTRUMENTATION DRAWINGS TO COORDINATE THIS PART OF THE WORK.
- FOR DETAILS OF NEW FOUNDATION DRAINS, WHICH PASS UNDERNEATH NEW CONCRETE SLABS REFER TO GENERAL DRAWINGS, UNLESS NOTED OTHERWISE IN SPECIFICATIONS.

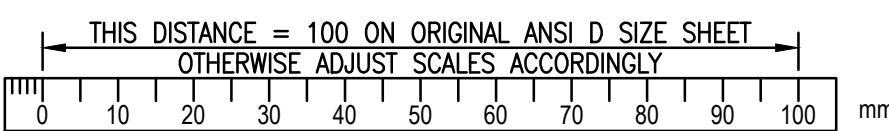


<p>PLT: FULL 1:25 HALF 1:50 @ ANS1D</p>	<table border="1"> <thead> <tr> <th>ISSUE</th> <th>DATE</th> <th>DRAWN</th> <th>CHK'D</th> <th>APP'D</th> <th>DESCRIPTION</th> <th>ISSUE</th> <th>DATE</th> <th>DRAWN</th> <th>CHK'D</th> <th>APP'D</th> <th>DESCRIPTION</th> </tr> </thead> <tbody> <tr> <td>A</td> <td>JAN27/12</td> <td>AIS</td> <td>MR</td> <td>MR</td> <td>ISSUED FOR TENDER</td> <td></td> <td></td> <td></td> <td></td> <td></td> <td></td> </tr> <tr> <td>B</td> <td>APR25/12</td> <td>AIS</td> <td>MR</td> <td>MR</td> <td>ISSUED FOR CONSTRUCTION</td> <td></td> <td></td> <td></td> <td></td> <td></td> <td></td> </tr> <tr> <td>C</td> <td>MAY08/13</td> <td>RB</td> <td></td> <td></td> <td>RECORD DRAWING</td> <td></td> <td></td> <td></td> <td></td> <td></td> <td></td> </tr> </tbody> </table>	ISSUE	DATE	DRAWN	CHK'D	APP'D	DESCRIPTION	ISSUE	DATE	DRAWN	CHK'D	APP'D	DESCRIPTION	A	JAN27/12	AIS	MR	MR	ISSUED FOR TENDER							B	APR25/12	AIS	MR	MR	ISSUED FOR CONSTRUCTION							C	MAY08/13	RB			RECORD DRAWING							<p>DESIGNED <u>MR</u></p> <p>DRAWN <u>AIS</u></p> <p>CHECKED <u>MR</u></p>	<p>OPUS DAYTONKNIGHT</p> <p>North Vancouver Office 604-990-4800</p> <p>210-889 Harbourside Drive North Vancouver BC V7P 3S1, Canada</p>	<p>SUNSHINE COAST REGIONAL DISTRICT GARDEN BAY UV BUILDING GENERAL CONSTRUCTION NOTES</p>	<p>SCALE: AS SHOWN</p> <p>DRAWING No. 028.206</p> <p>SHEET No. S1 ISSUE C</p>
ISSUE	DATE	DRAWN	CHK'D	APP'D	DESCRIPTION	ISSUE	DATE	DRAWN	CHK'D	APP'D	DESCRIPTION																																										
A	JAN27/12	AIS	MR	MR	ISSUED FOR TENDER																																																
B	APR25/12	AIS	MR	MR	ISSUED FOR CONSTRUCTION																																																
C	MAY08/13	RB			RECORD DRAWING																																																

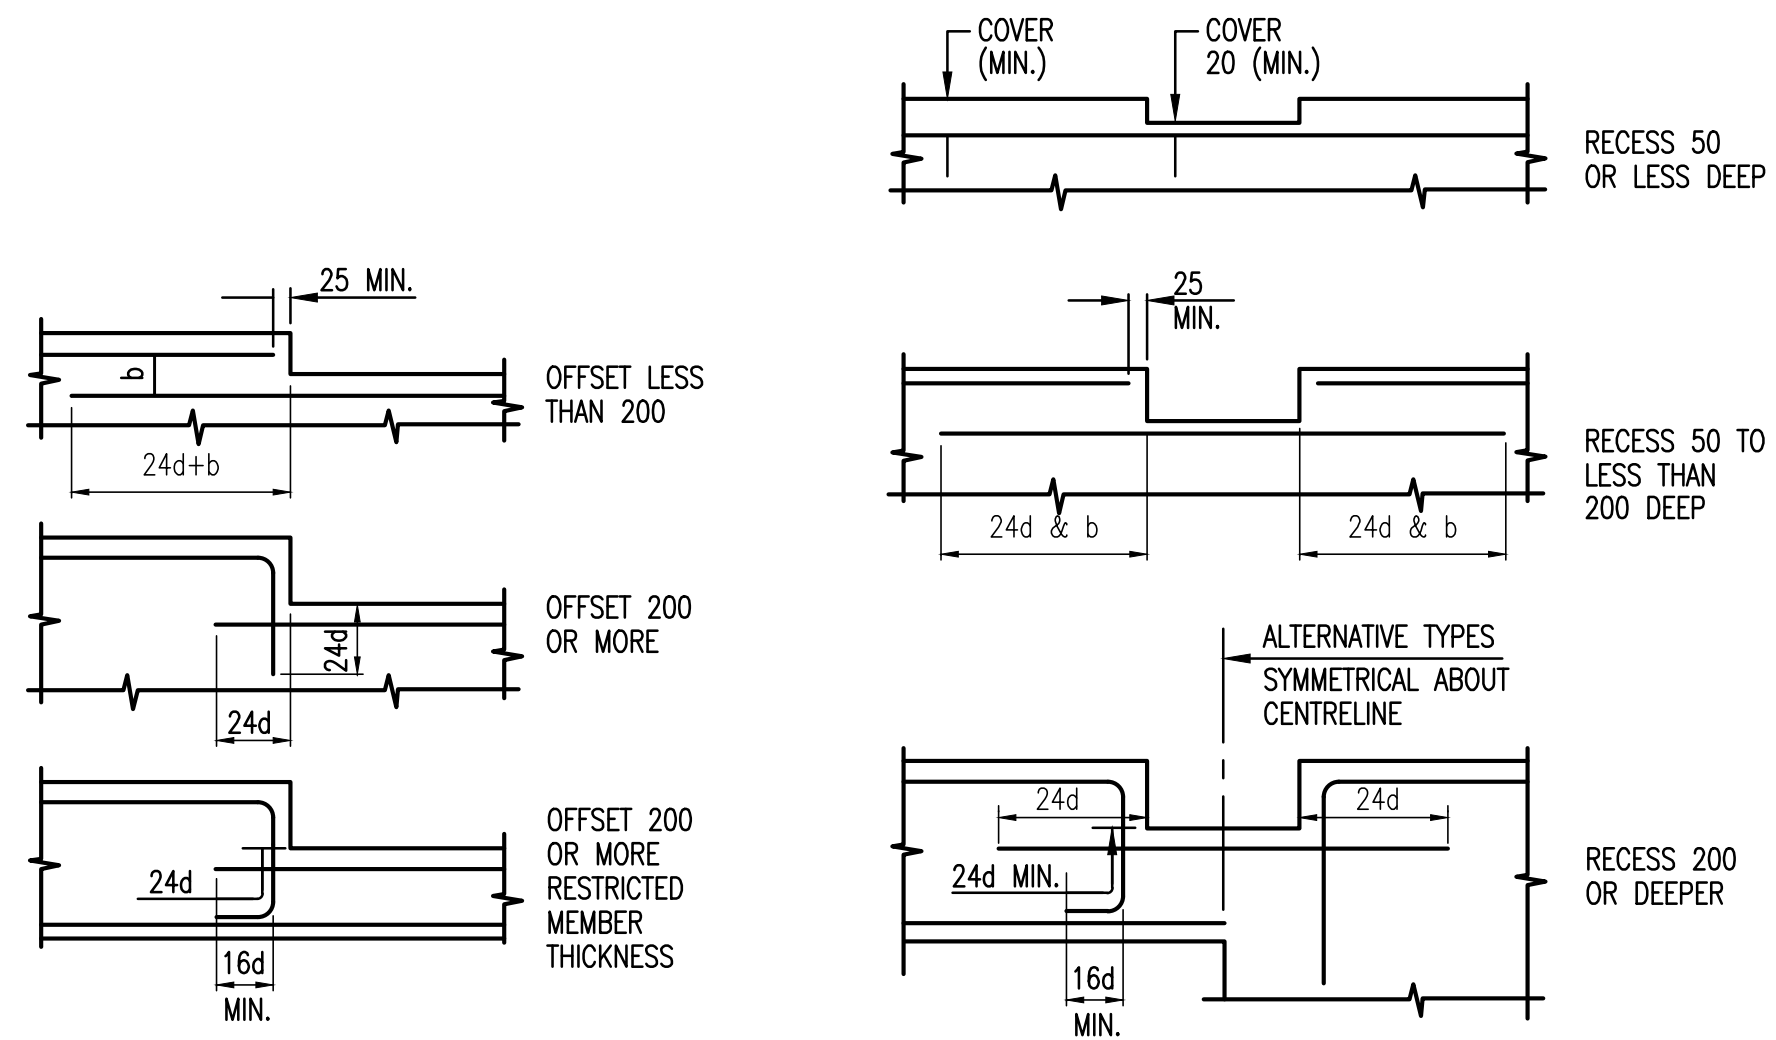

TYPICAL RIGHT ANGLE OFFSET DETAILS

TYPICAL RECESS DETAILS

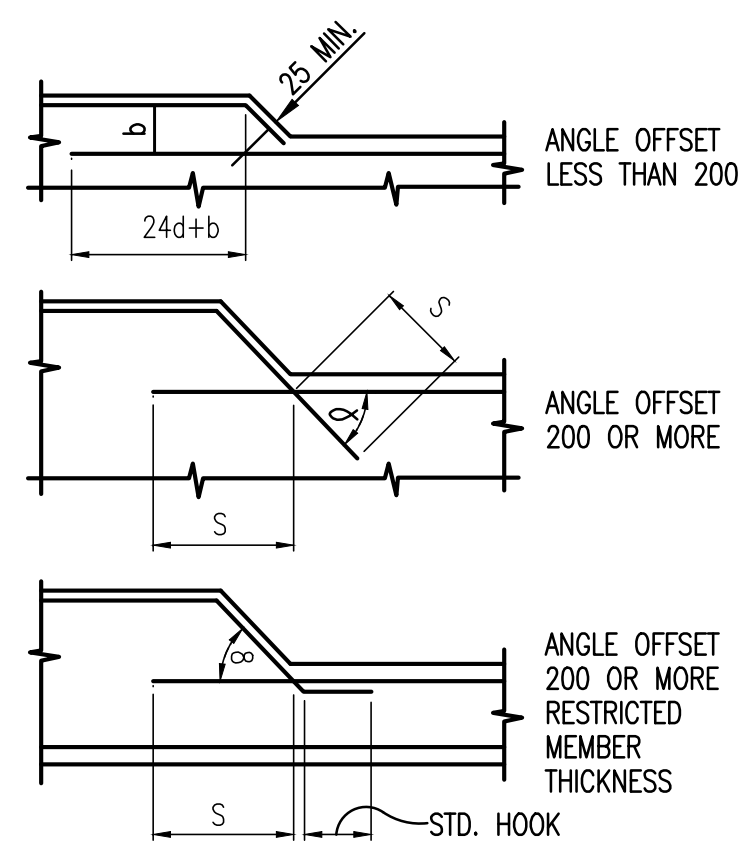

TYPICAL ANGLE OFFSET DETAILS


ANGLE	∞	LENGTH	S
0° - 15°		12d	
15° - 30°		15d	
30° - 60°		19d	
60° - 75°		21d	
75° - 90°		24d	

" This Record Drawing has been prepared by Opus DaytonKnight ("Opus DK") for the exclusive use of "Sunshine Coast Regional District" (the "Client"). Any use which a third party makes of this drawing, or any reliance or decisions or actions taken by any such third party based upon this drawing, are the sole responsibility of any such third party and Opus DK accepts no responsibility, liability or risk for any damages, loss, or claims, if any, suffered by any such third party or any related party of such third party as a result of any reliance, or decisions made or actions taken, based upon this drawing. It is the user's sole responsibility to check the accuracy of this digital drawing."

NOTE :
WHERE DETAIL(S) SHOWN ON THE DRAWINGS DIFFER FROM THE DETAILS SHOWN ON THIS SHEET , THEN THE DRAWING HAS PRIORITY.


THIS DISTANCE = 100 ON ORIGINAL ANSI D SIZE SHEET
OTHERWISE ADJUST SCALES ACCORDINGLY

1:1 @ ANS I D 0 10 20 30 40 50 60 70 80 90 100 mm

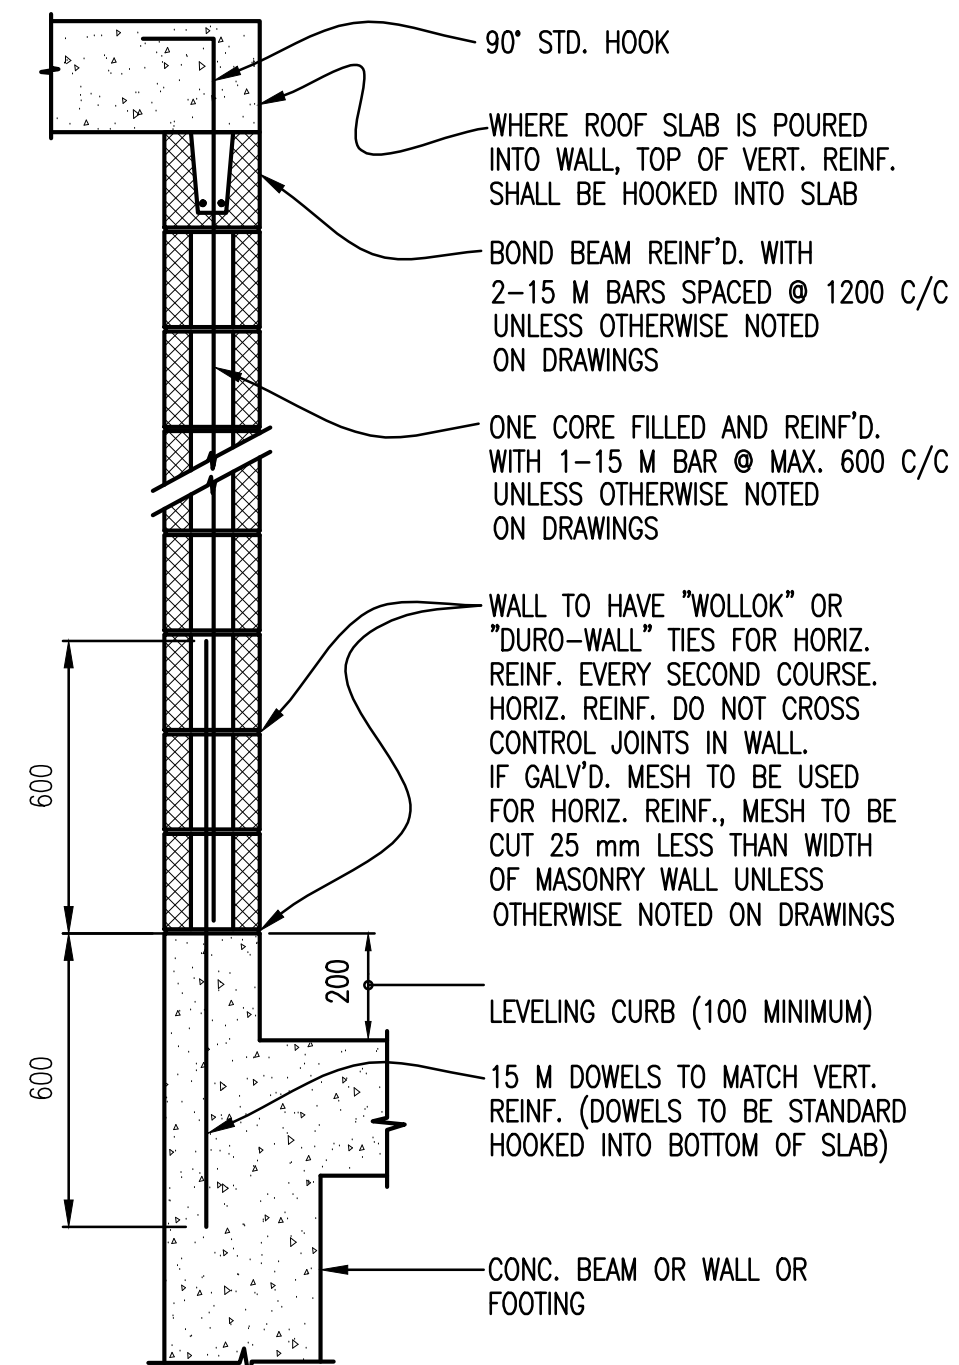

TYPICAL MASONRY WALL ANCHORING TO CONCRETE AT BASE STANDARD MASONRY BLOCKS


- NOTES :
1. LINTEL IS REQUIRED FOR TOP OF OPENING. SEE LINTEL DETAILS.
 2. PROVIDE VERTICAL REINFORCING FOR BOTH SIDES OF OPENING IN WALL AND EACH CORNER OF WALLS.
 3. PROVIDE BOND BEAM ABOVE AND BELOW OPENINGS IN WALL AND EXTEND BOND BEAM 800 mm BEYOND EDGES.
 4. FILL FOR BLOCKS AND BOND BEAMS TO BE 30 MPa CONCRETE.
 5. TYPE S MORTAR TO BE USED FOR ALL JOINTS.

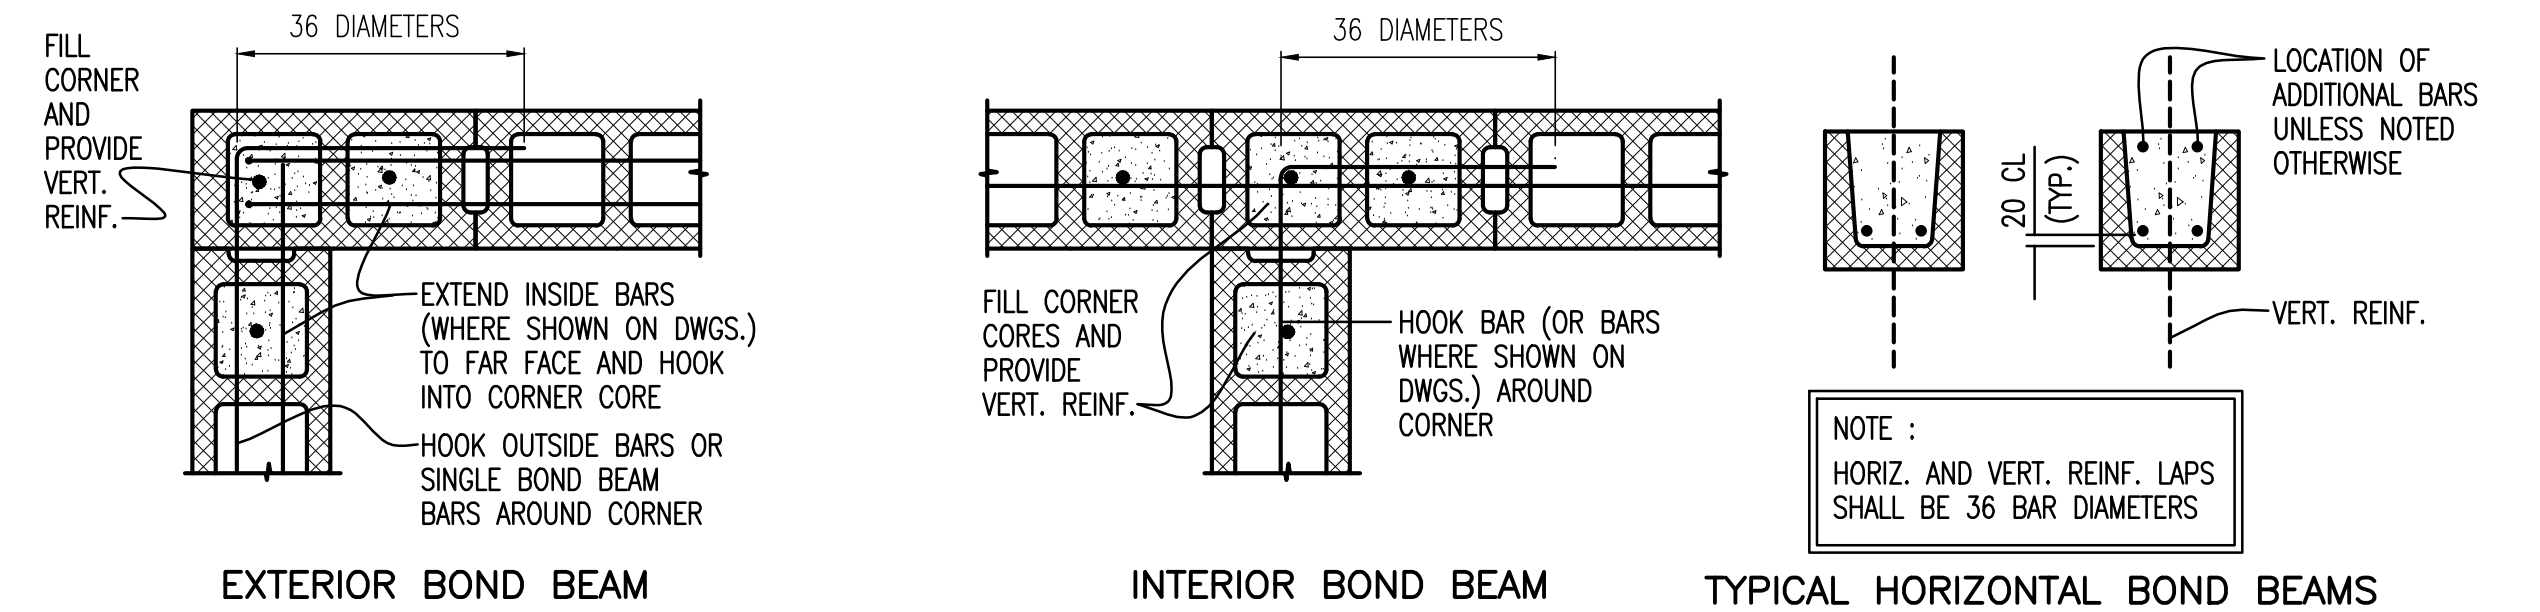

EXTERIOR BOND BEAM


INTERIOR BOND BEAM

TYPICAL HORIZONTAL BOND BEAMS

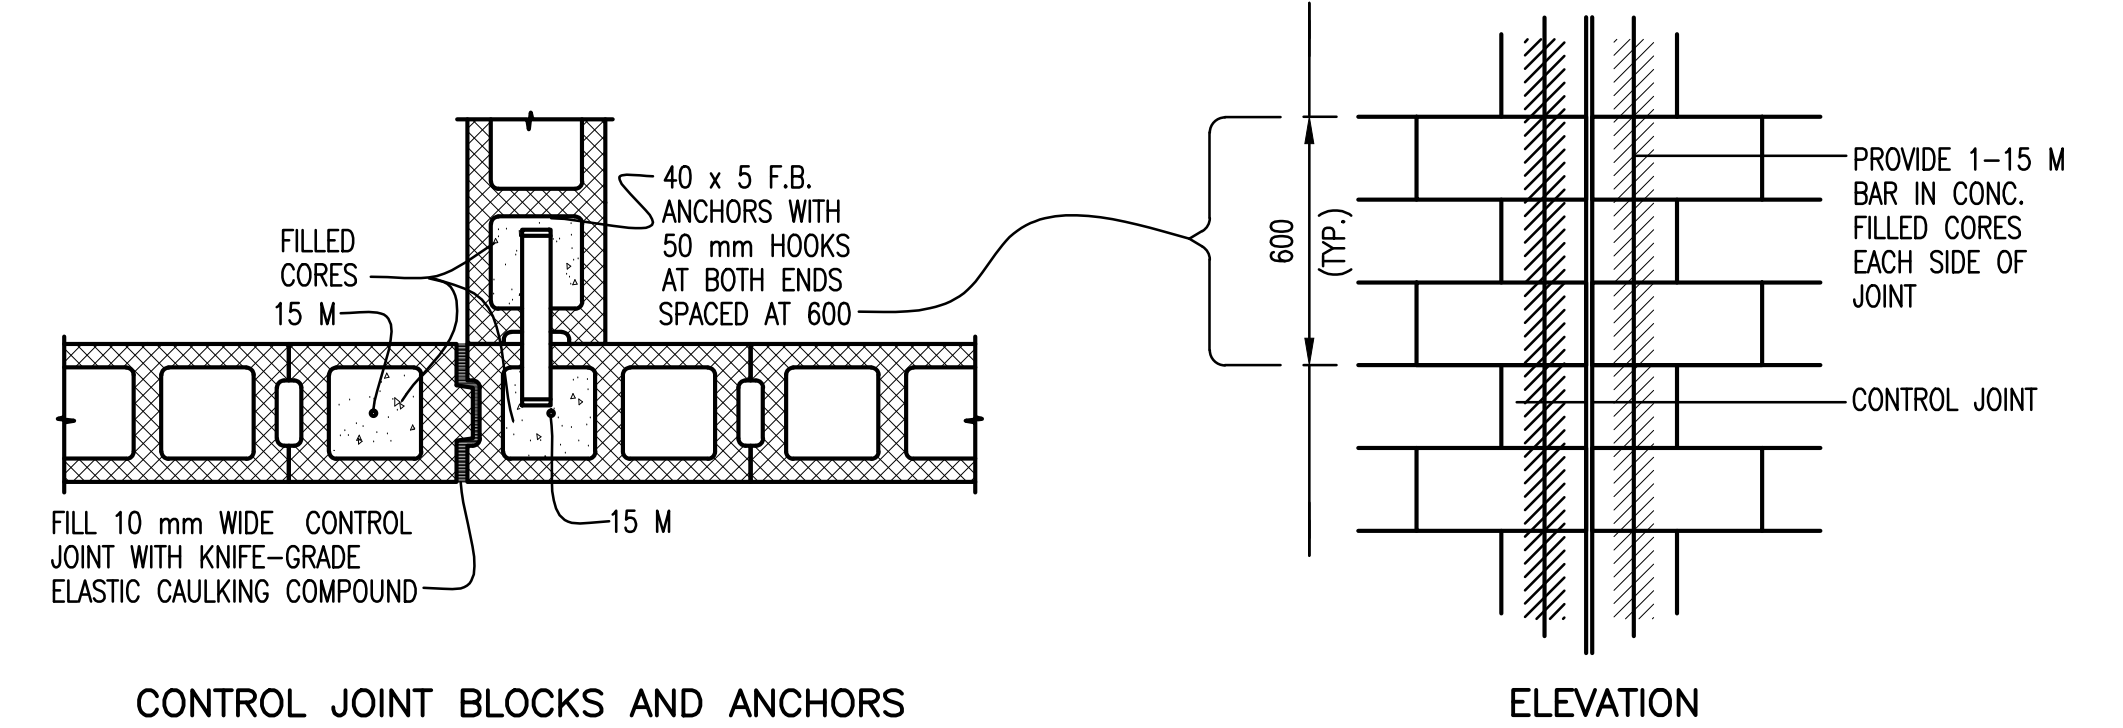


CONTROL JOINT BLOCKS AND ANCHORS

CONNECTION AND CONTROL JOINTS STANDARD MASONRY BLOCKS

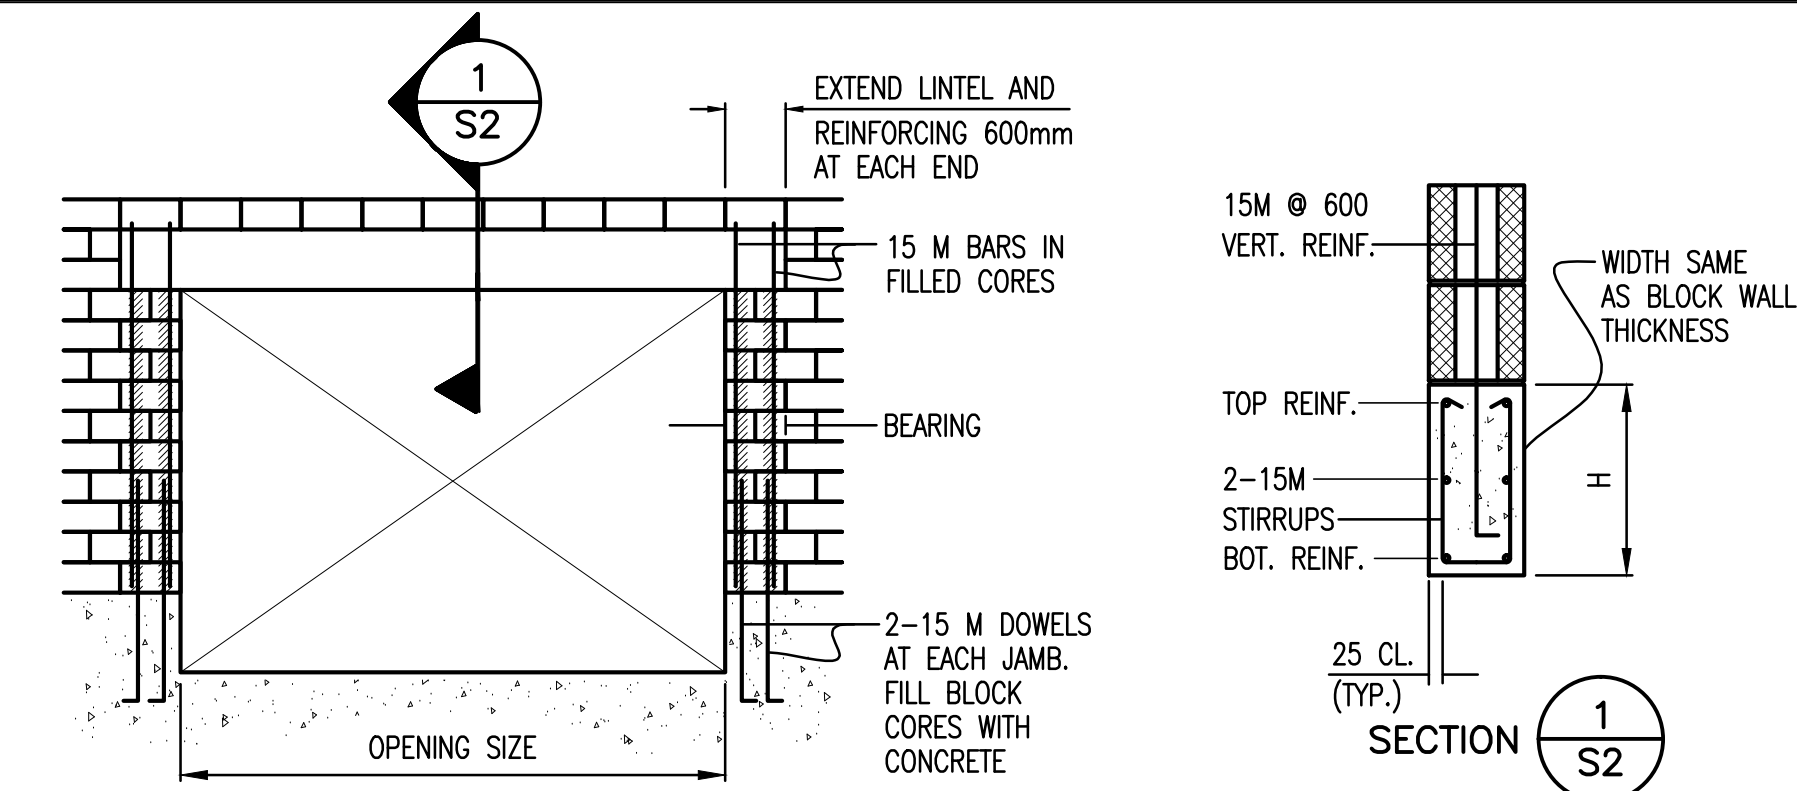

POURED CONCRETE LINTEL IN BLOCK WALL

OPENING SIZE	H	BOTTOM REINF.	TOP REINF.	STIRRUPS	BEARING
2400 TO 3000	400	3-20 M	2-15 M	10 M @ 300 C/C	400
3000 TO 3600	400	2-25 M	2-15 M	10 M @ 300 C/C	400
3600 TO 4200	600	2-25 M + 1-20 M	2-15 M	10 M @ 250 C/C	400
4200 TO 4800	600	2-25 M + 2-20 M	2-20 M	10 M @ 200 C/C	400

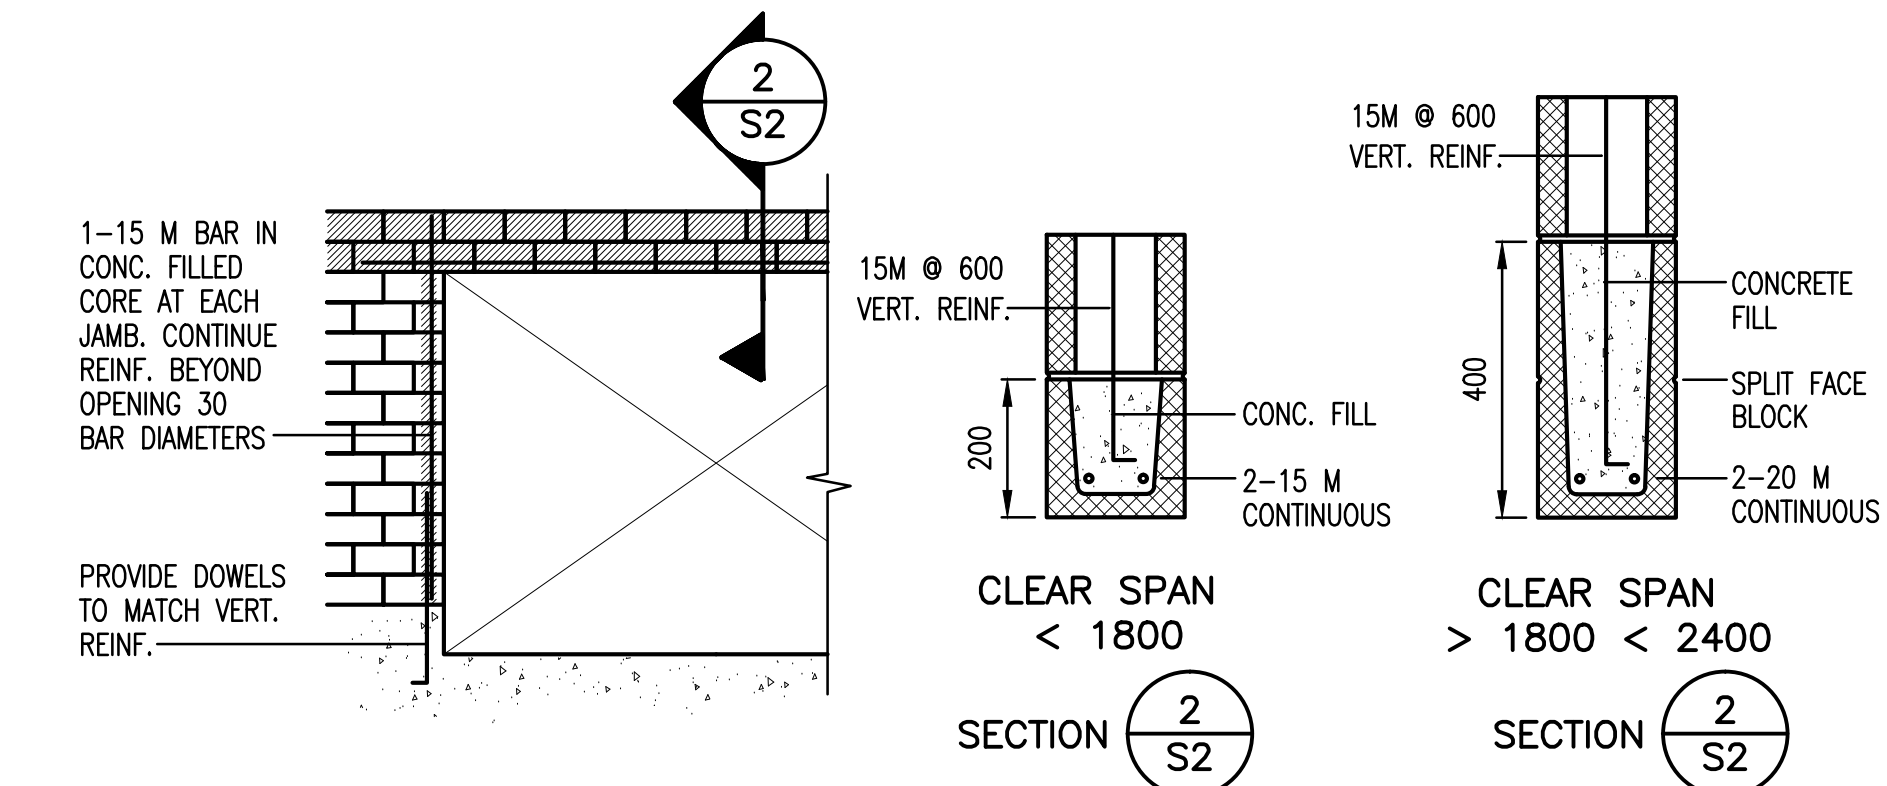

LINTEL DETAILS - STANDARD MASONRY BLOCKS

NOTE : FOR GIANT BRICK, USE SAME MASONRY DETAILS




REVISIONS	ISSUE	DATE	DRAWN	CHK'D	APP'D	DESCRIPTION	ISSUE	DATE	DRAWN	CHK'D	APP'D	DESCRIPTION
A	JAN27/12	MR	MR			ISSUED FOR TENDER						
B	APR25/12	MR	MR			ISSUED FOR CONSTRUCTION						
C	MAY08/13	RB				RECORD DRAWING						

DESIGNED	MR
DRAWN	MR
CHECKED	MR

OPUS DAYTONKNIGHT
North Vancouver Office
604-990-4800
210-889 Harbourside Drive
North Vancouver BC
V7P 3S1, Canada


SUNSHINE COAST REGIONAL DISTRICT
GARDEN BAY UV BUILDING
GENERAL STRUCTURAL & MASONRY DETAILS

SCALE: AS SHOWN
DRAWING No. 028.206
SHEET No. S2 ISSUE C

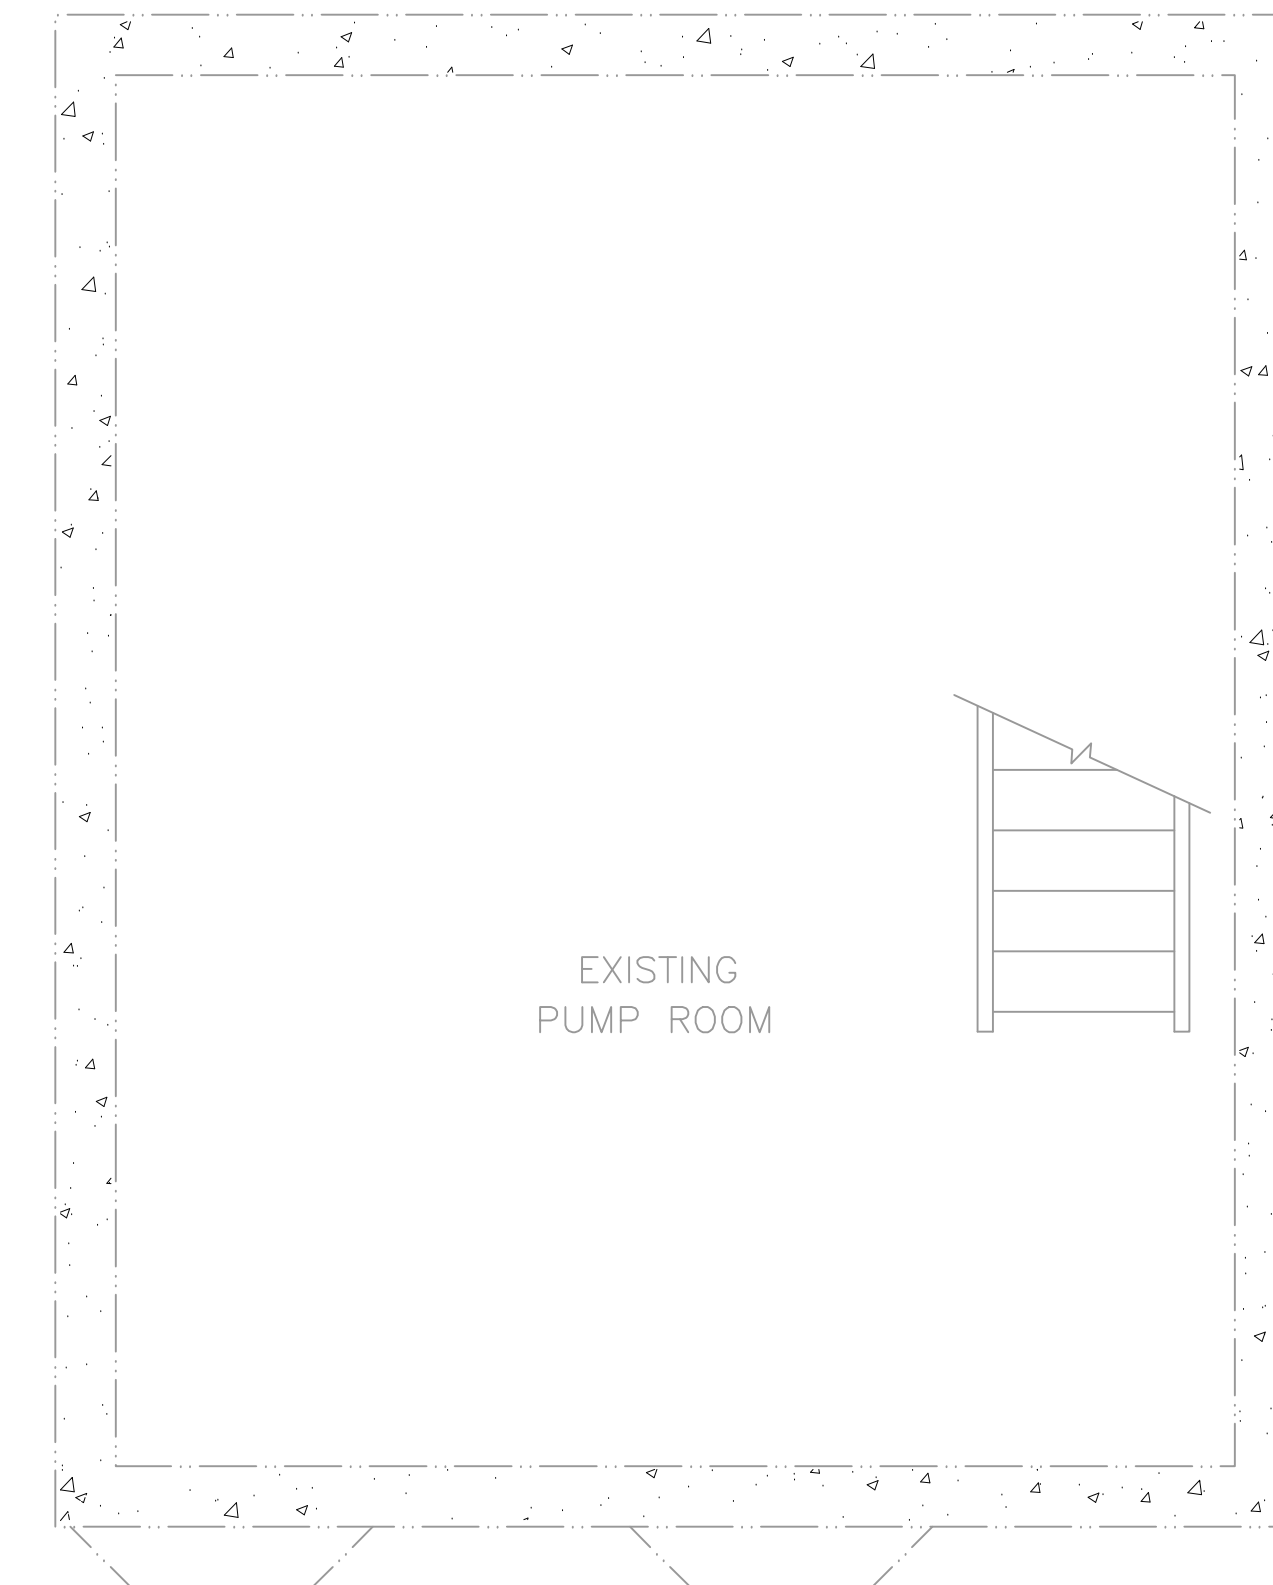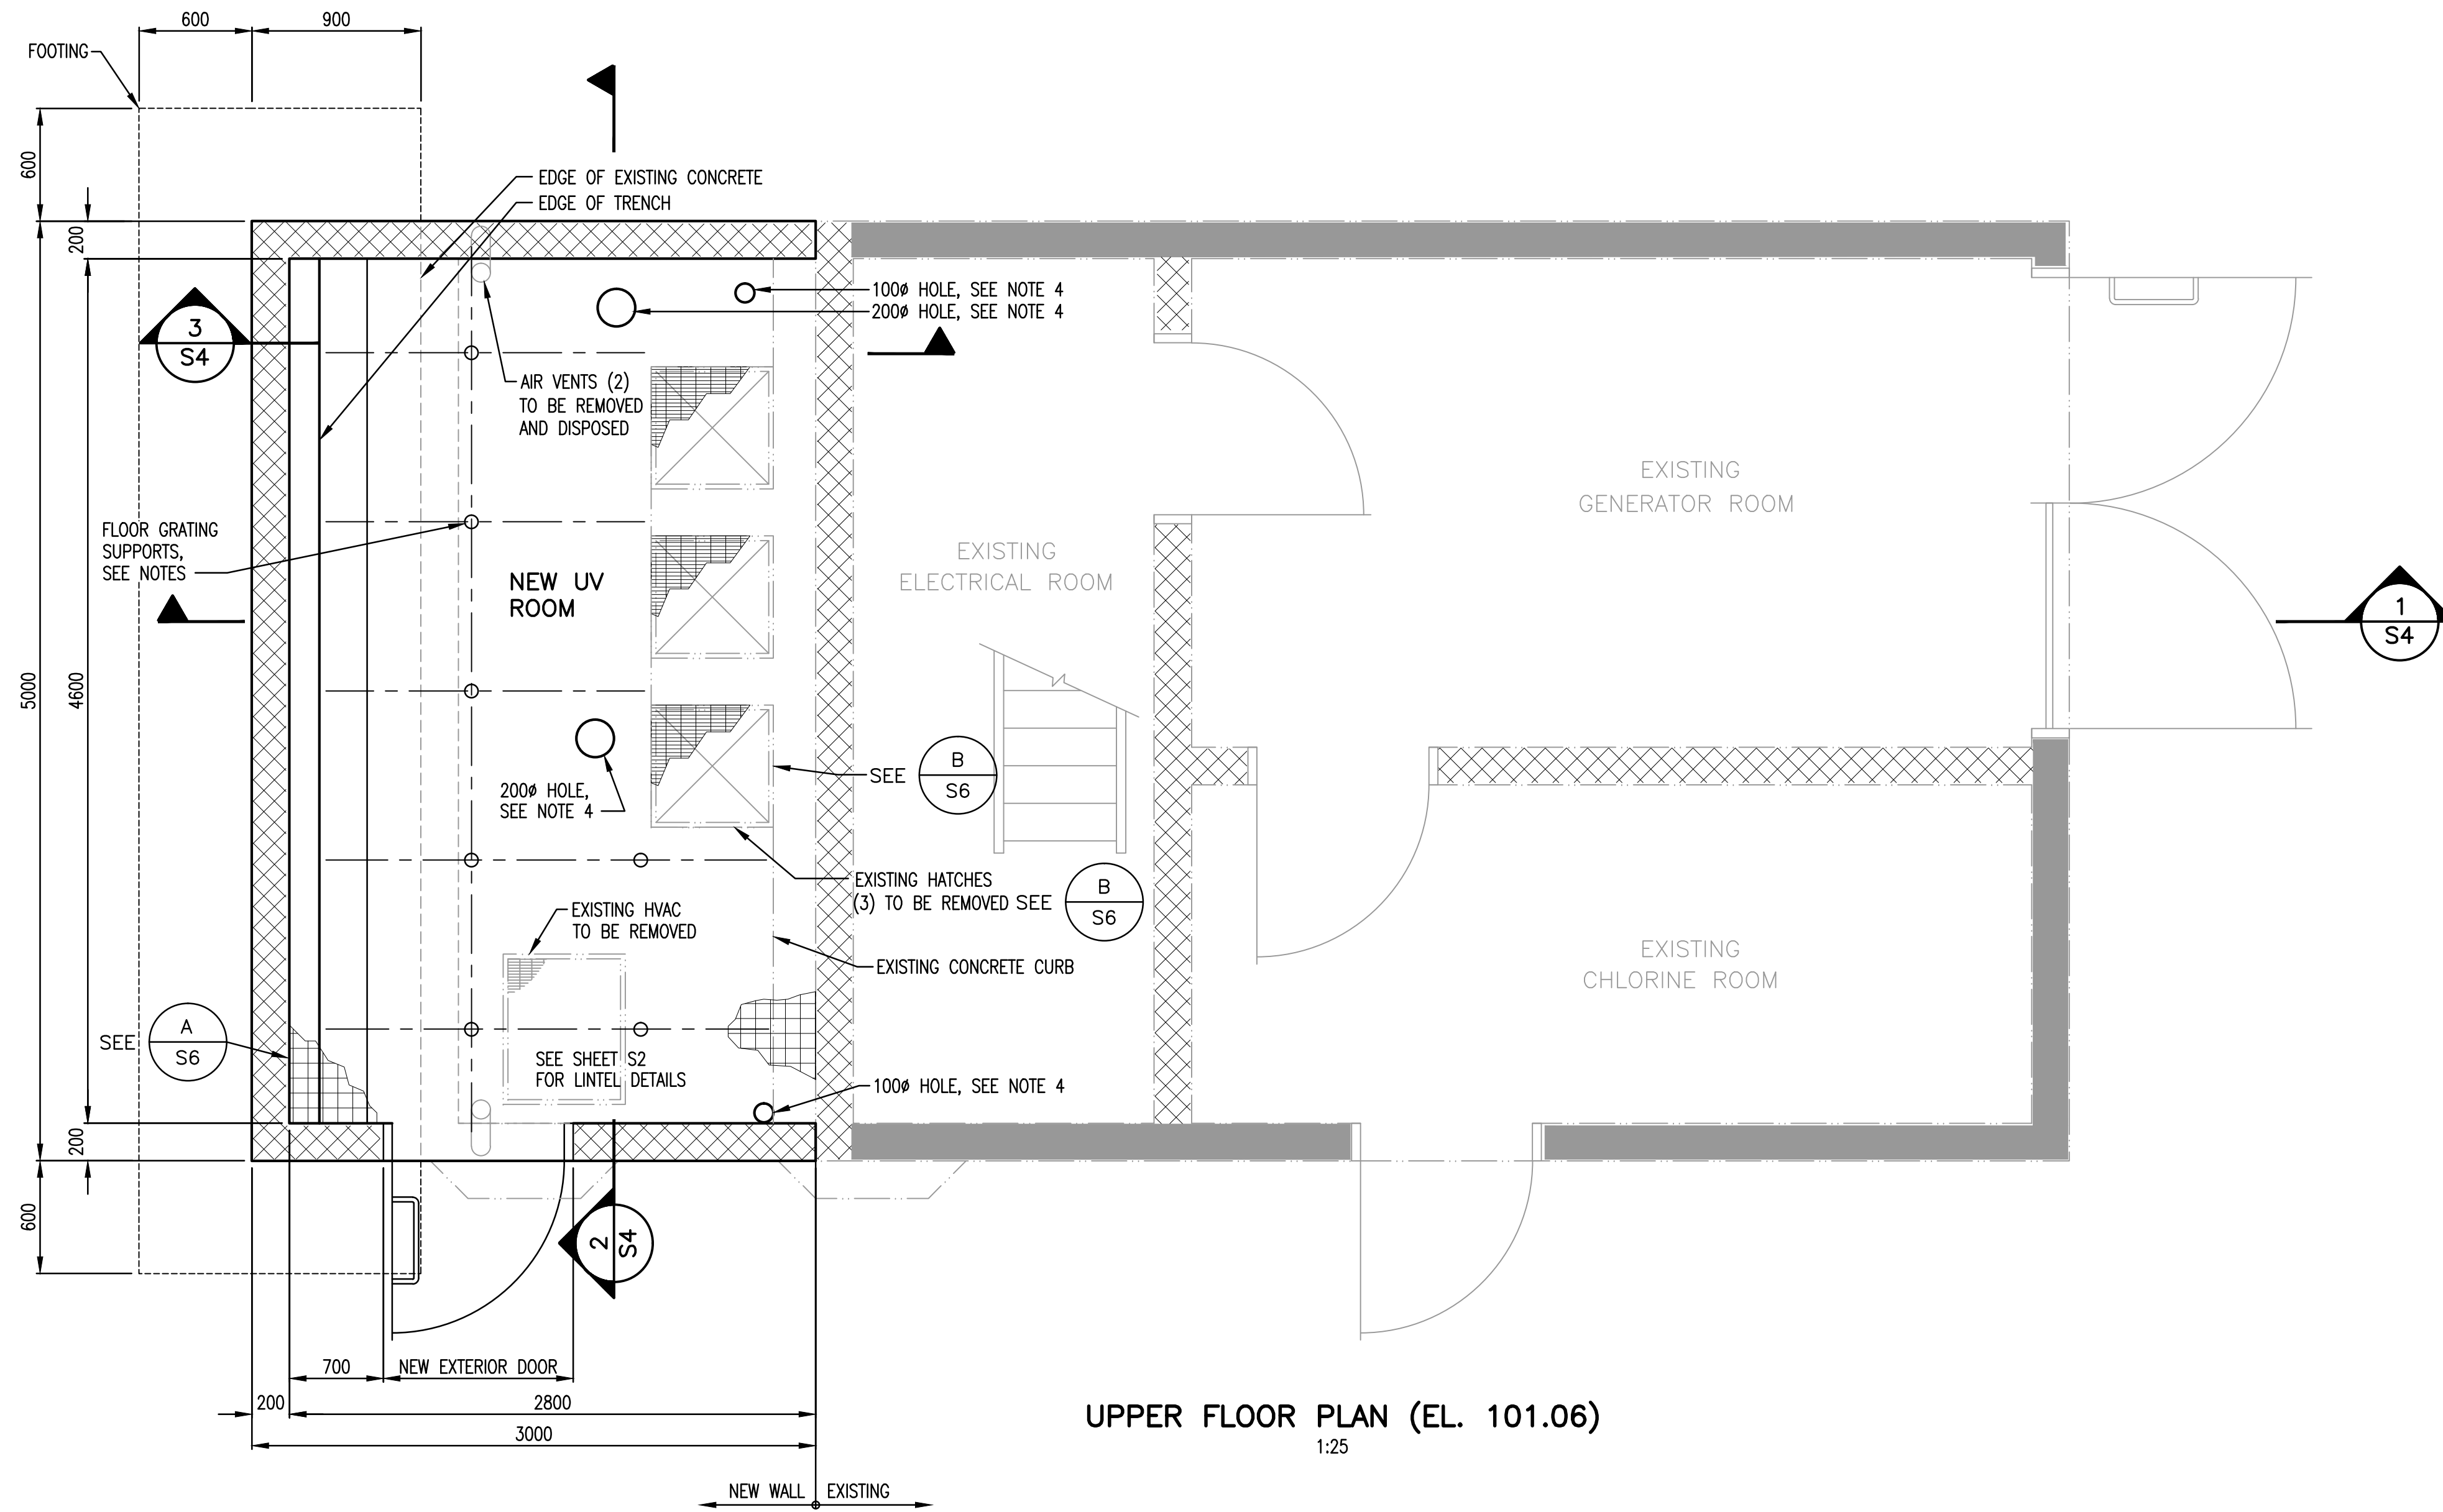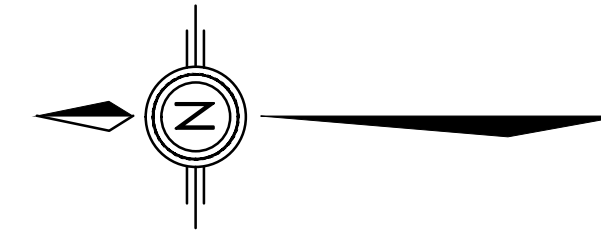

- NOTES :
- GROUND ELEVATION ASSUMED FROM AS-BUILT DRAWINGS.
 - MAXIMUM SPAN OF FLOOR GRATING BETWEEN SUPPORTS NOT TO EXCEED 900mm.
 - FLOOR GRATING TO BE ALUMINUM OR FRP.
 - CONTRACTOR TO CORE HOLES THROUGH SLAB. APPROXIMATE LOCATION TO BE FINALIZED IN THE FIELD.

" This Record Drawing has been prepared by Opus DaytonKnight ("Opus DK") for the exclusive use of "Sunshine Coast Regional District" (the "Client"). Any use which a third party makes of this drawing, or any reliance or decisions or actions taken by any such third party based upon this drawing, are the sole responsibility of any such third party and Opus DK accepts no responsibility, liability or risk for any damages, loss, or claims, if any, suffered by any such third party or any related party of such third party as a result of any reliance, or decisions made or actions taken, based upon this drawing. It is the user's sole responsibility to check the accuracy of this digital drawing."

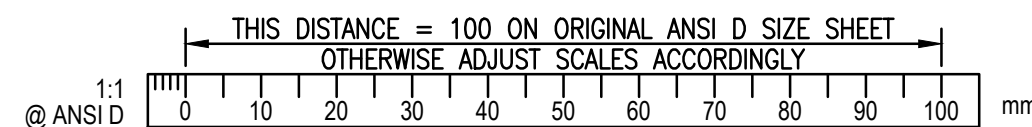

ISSUE	DATE	DRAWN	CHK'D	APP'D	DESCRIPTION	ISSUE	DATE	DRAWN	CHK'D	APP'D	DESCRIPTION
A	JAN27/12	AIS	MR	MR	ISSUED FOR TENDER						
B	APR25/12	AIS	MR	MR	ISSUED FOR CONSTRUCTION						
C	MAY08/13	RB			RECORD DRAWING						






DESIGNED	MR
DRAWN	DC/KS/AIS/RB
CHECKED	MR

OPUS DAYTONKNIGHT
 North Vancouver Office
 604-990-4800
 210-889 Harbourside Drive
 North Vancouver BC
 V7P 3S1, Canada

SUNSHINE COAST REGIONAL DISTRICT
 GARDEN BAY UV BUILDING
 STRUCTURAL - PLANS


SCALE: AS SHOWN
DRAWING No. 028.206
SHEET No. S3 ISSUE C

FILE: G:\D&K CAD Drawings\DKSERVER P - Shore\Records\SUNSHINE COAST\28-206\STRUCTURAL\28-206-S3.dwg Tab: S3, 13-06-07 vcsjz0

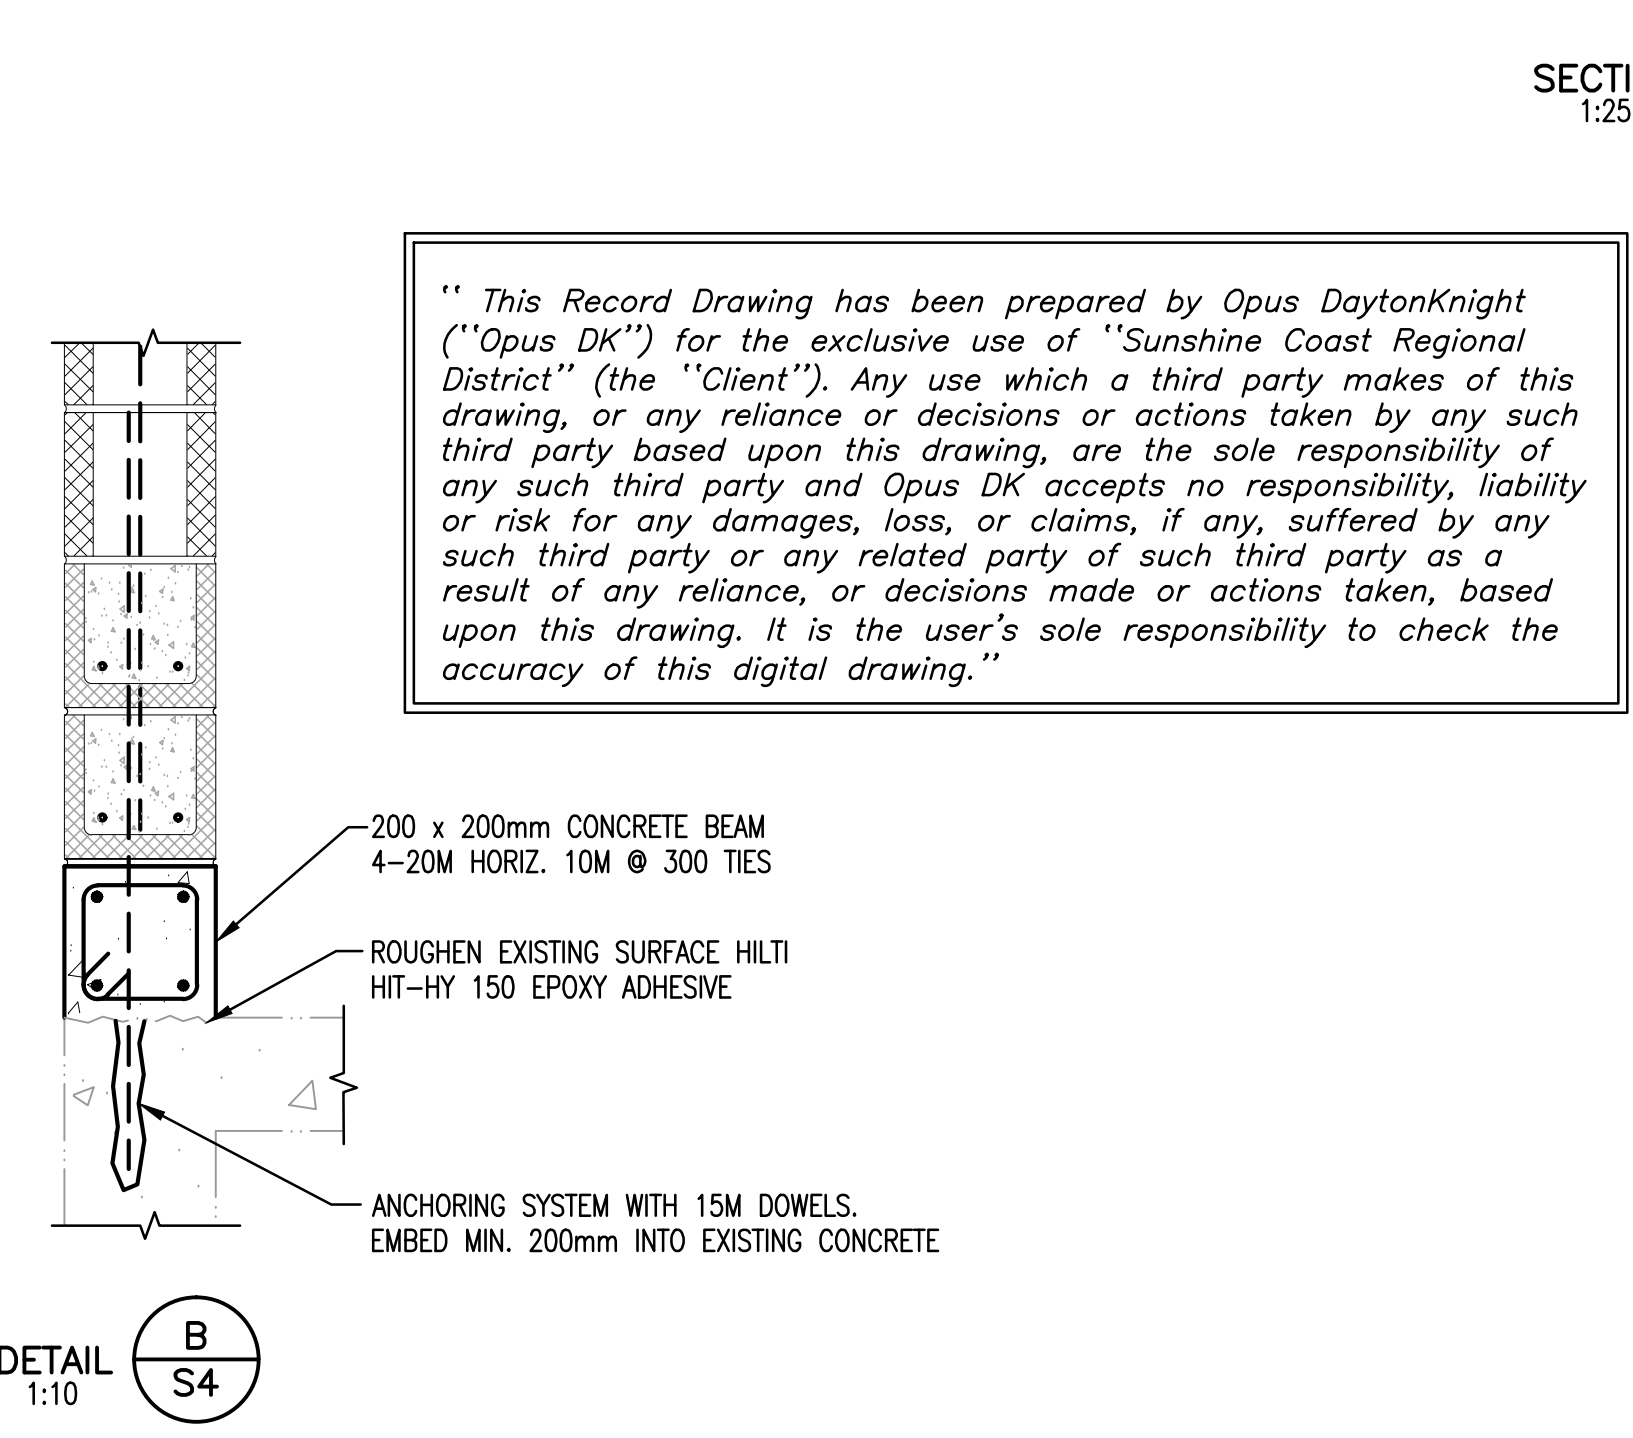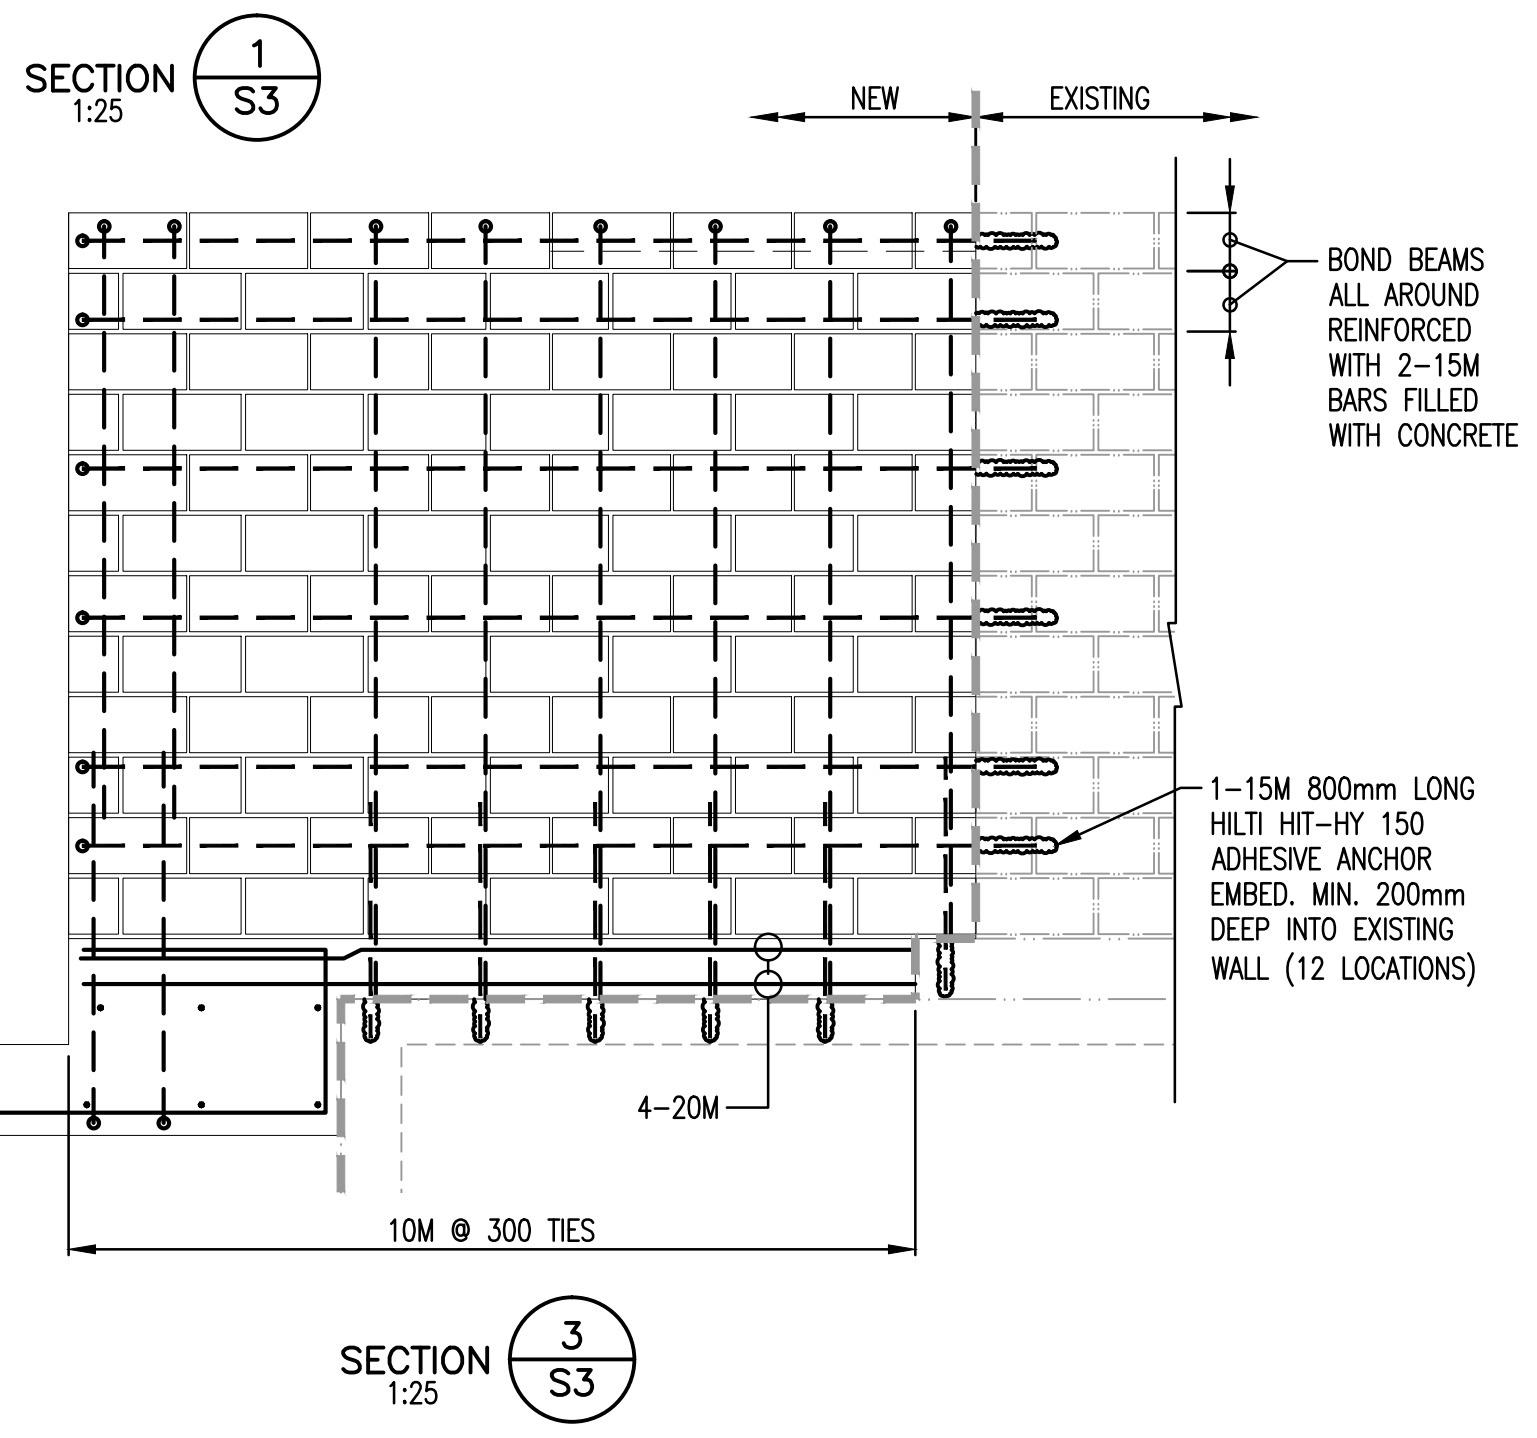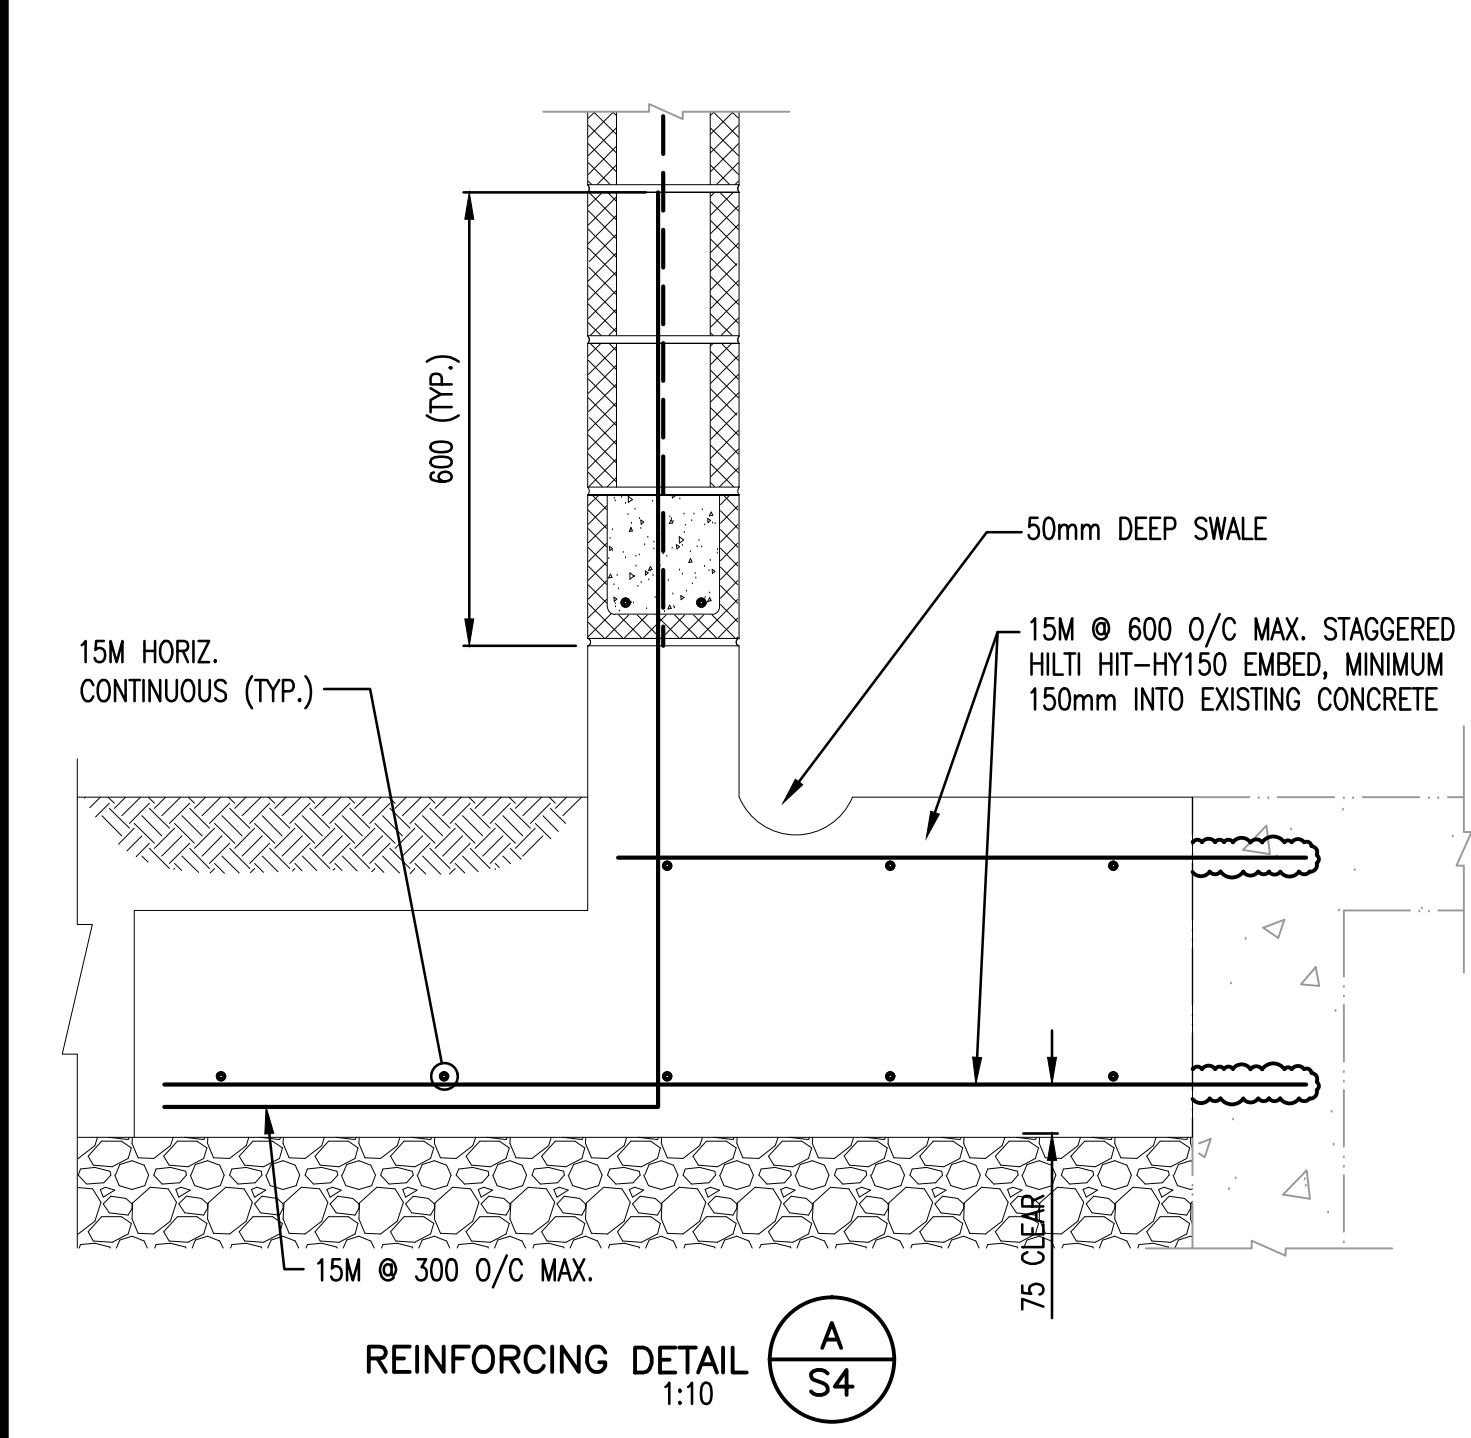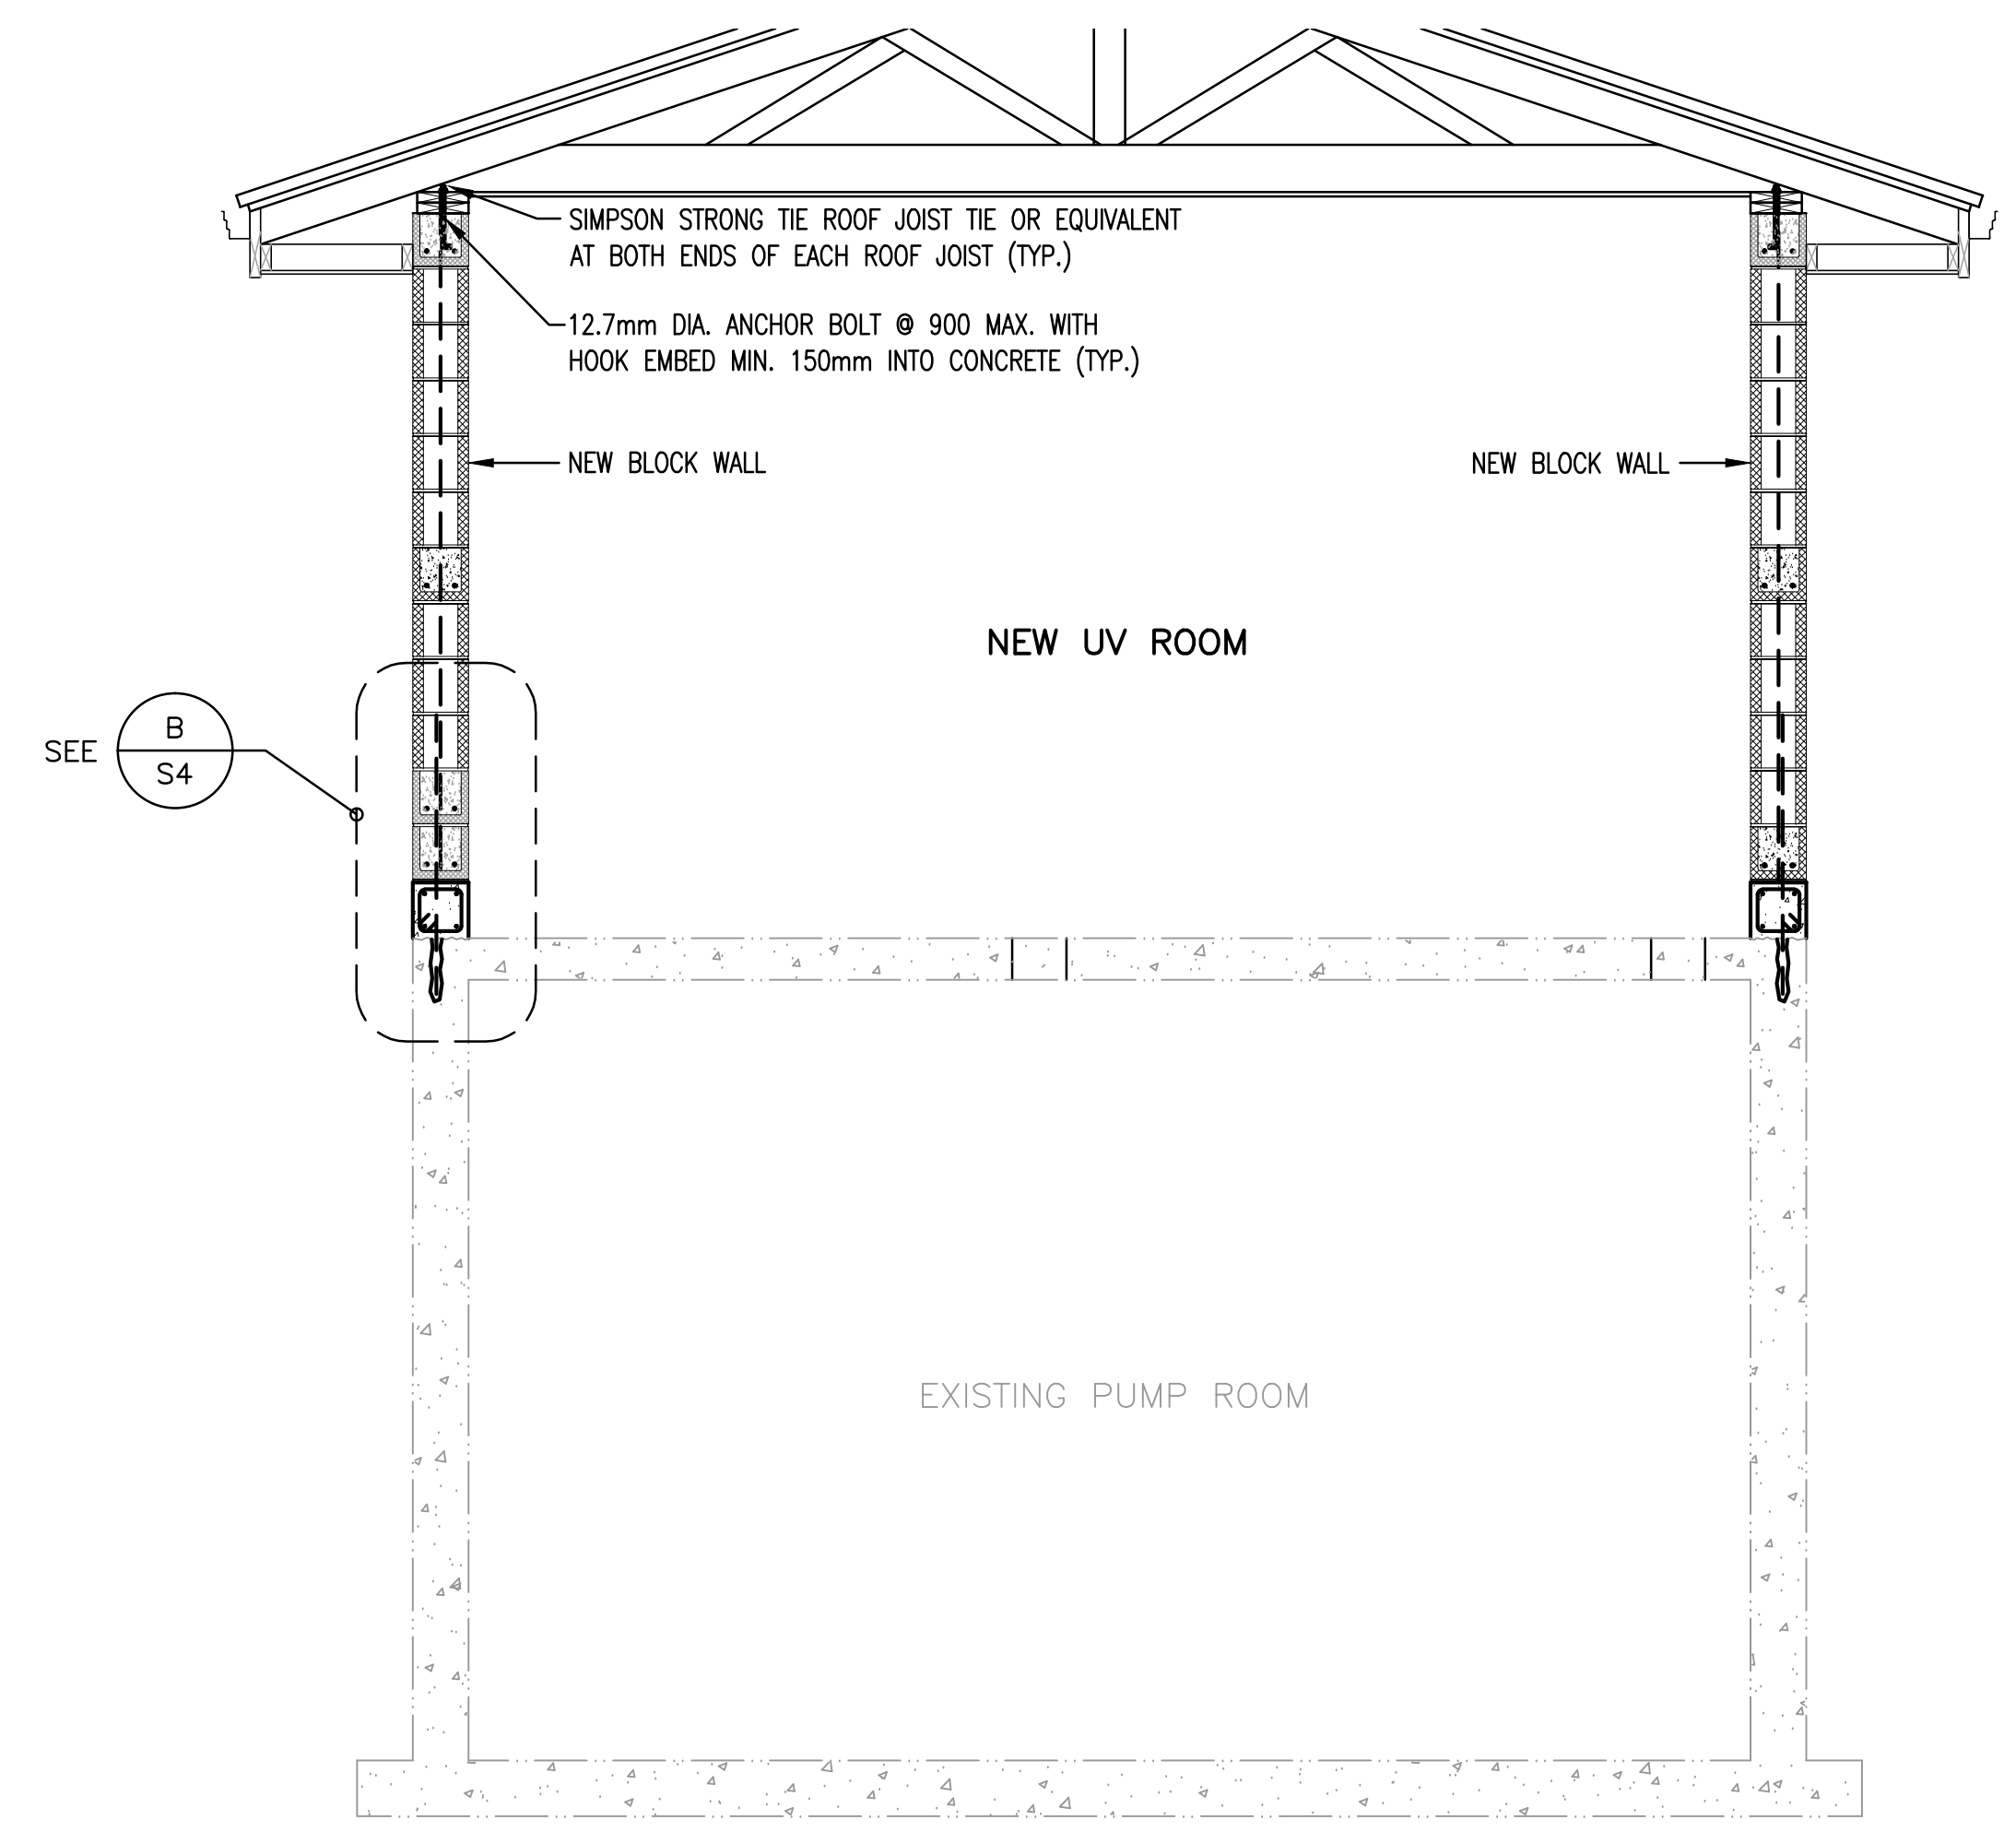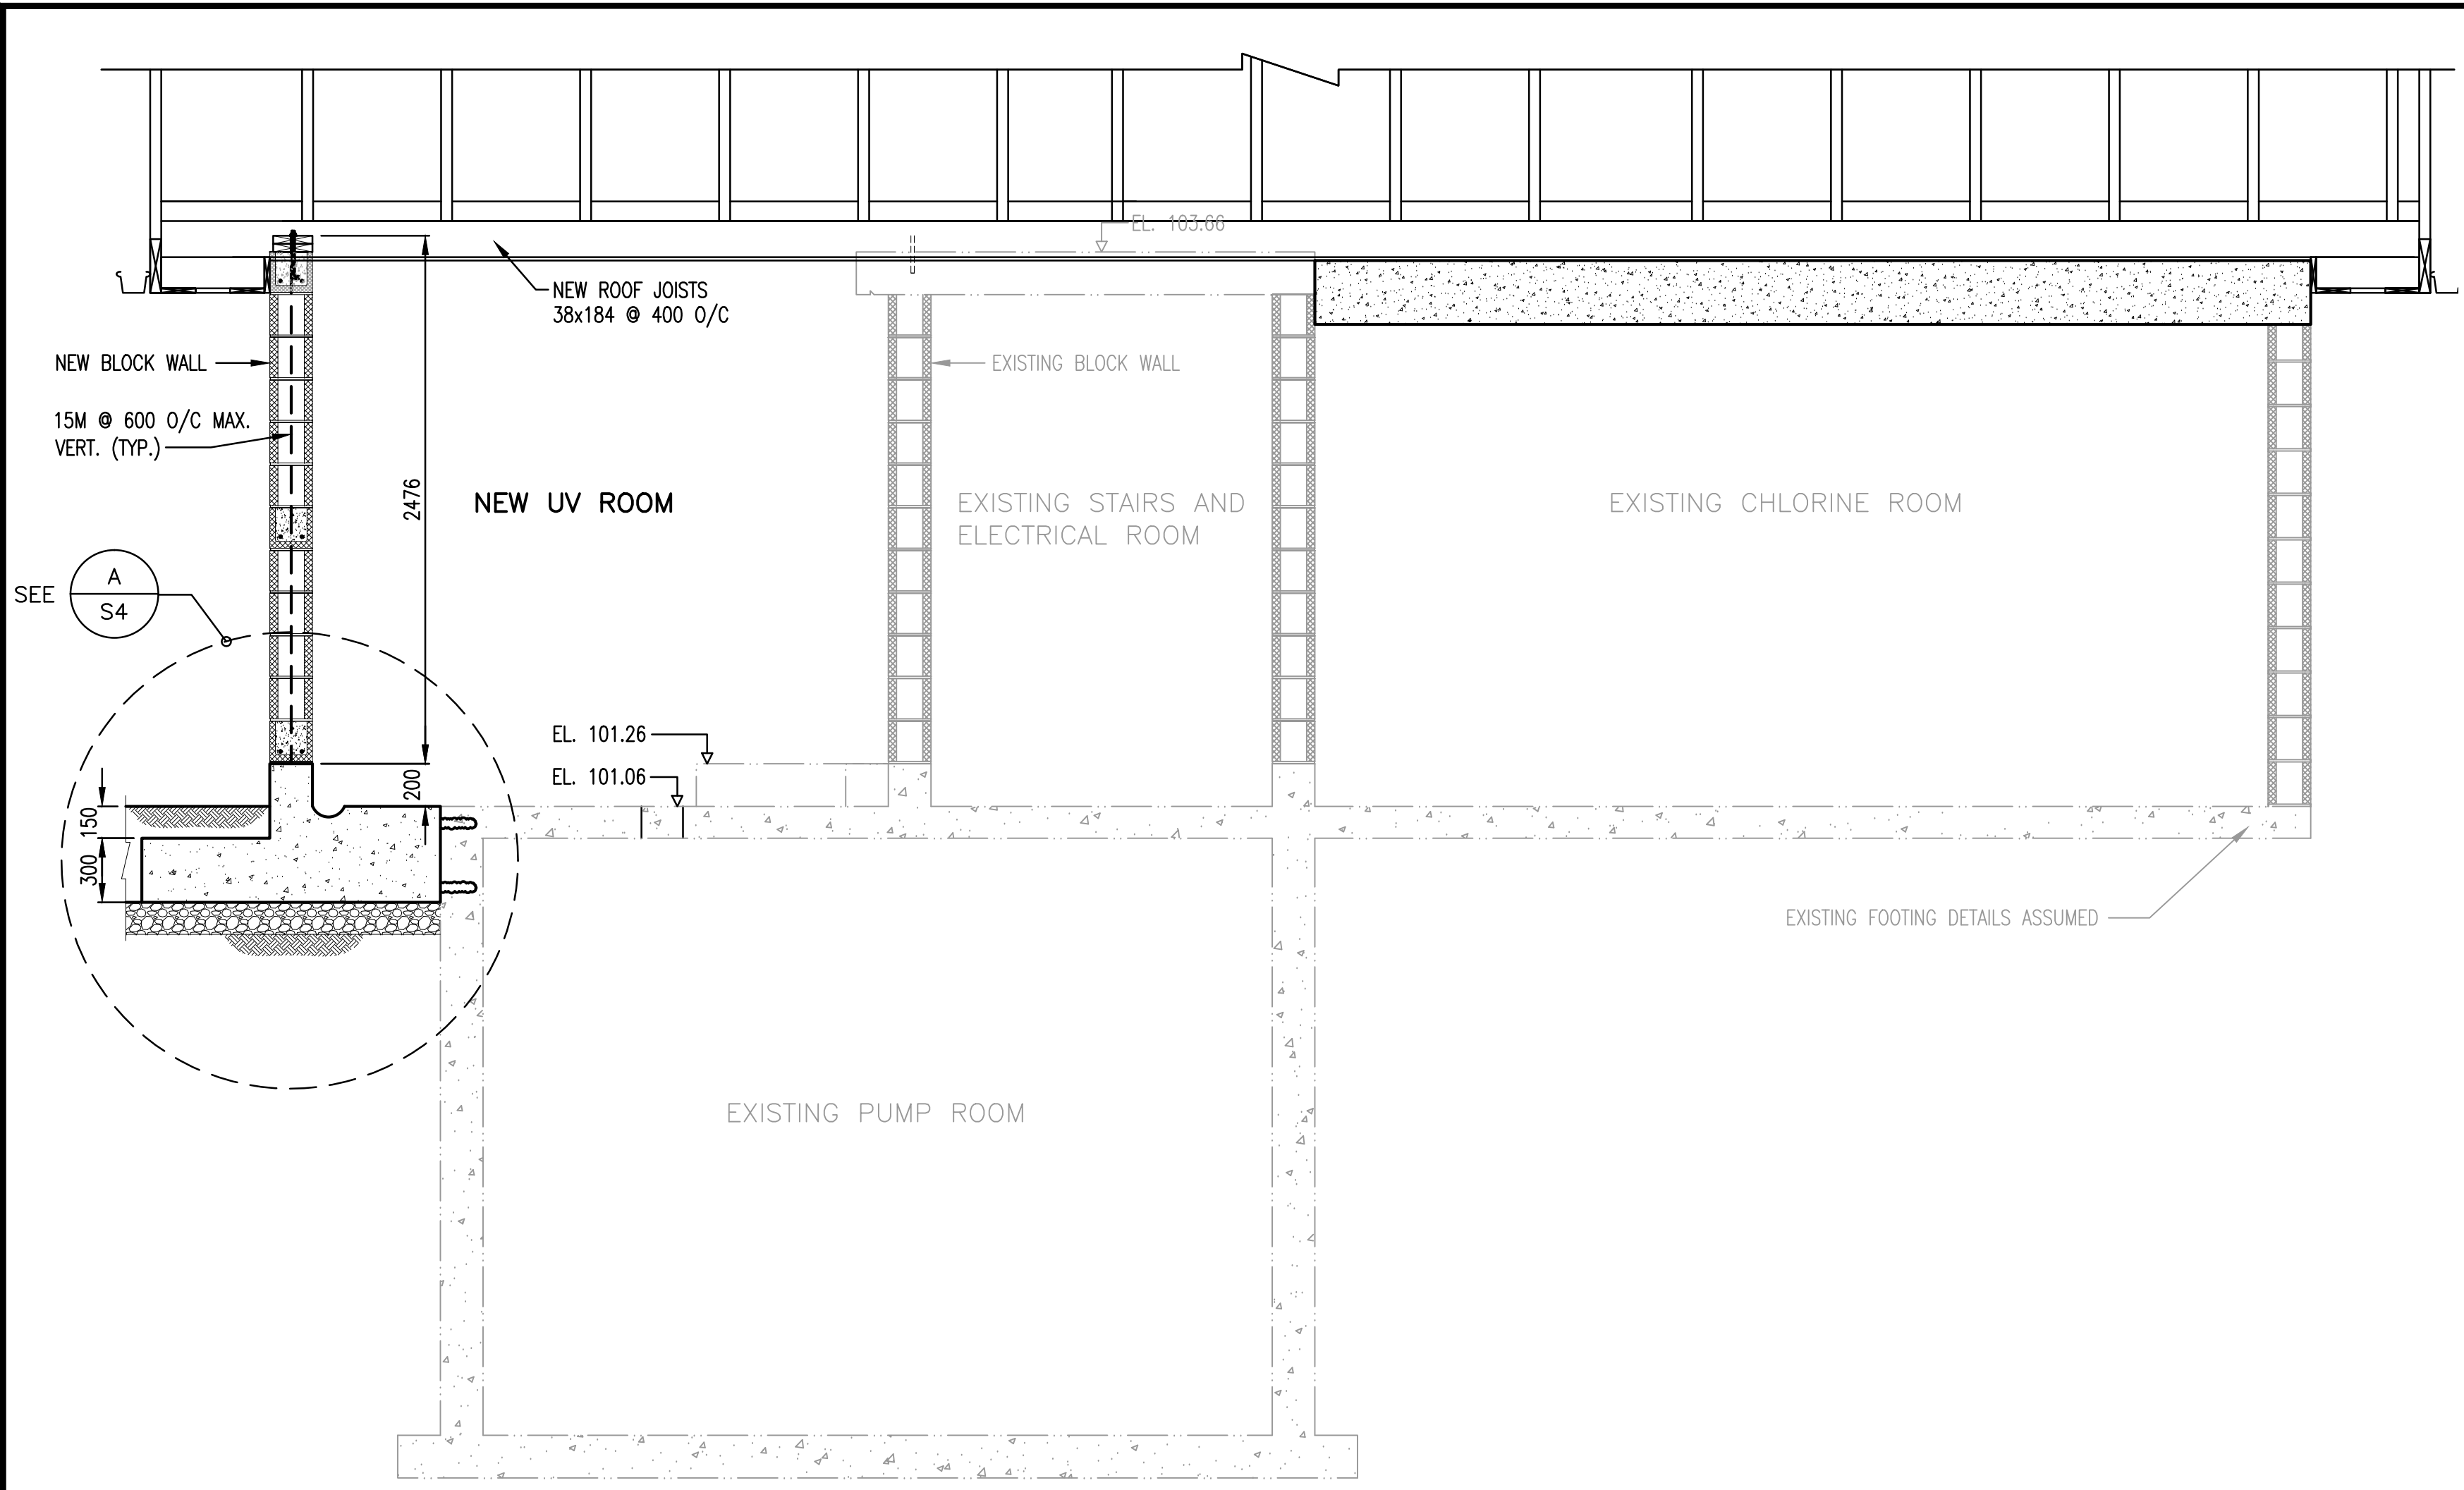

" This Record Drawing has been prepared by Opus DaytonKnight ("Opus DK") for the exclusive use of "Sunshine Coast Regional District" (the "Client"). Any use which a third party makes of this drawing, or any reliance or decisions or actions taken by any such third party based upon this drawing, are the sole responsibility of any such third party and Opus DK accepts no responsibility, liability or risk for any damages, loss, or claims, if any, suffered by any such third party or any related party of such third party as a result of any reliance, or decisions made or actions taken, based upon this drawing. It is the user's sole responsibility to check the accuracy of this digital drawing."

- NOTES:
- CONCRETE COMPOSITION AND CLASS:
 - CONCRETE STRENGTH AT 28 DAYS = 30MPa
 - SLUMP = 60mm
 - WATER / CEMENT RATIO = 0.45
 - TOTAL AIR CONTENT = 5%
 - MAXIMUM AGGREGATE SIZE: 40mm
 - THE CONCRETE SUPPLIER SHALL SUBMIT A LETTER OF ASSURANCE THAT THE CONCRETE SUPPLIED SHALL CONFORM TO THE COMPOSITION AND CLASS SPECIFIED. IN GENERAL, ALL CONCRETE WORK SHALL BE IN ACCORDANCE WITH CSA A23.1, AND ALL TESTING IN ACCORDANCE WITH CSA A23.2.
 - REINFORCING STEEL SHALL BE PLACED, SECURED AND SUPPORTED IN A SATISFACTORY MANNER BEFORE THE PLACING OF CONCRETE COMMENCES.
 - ALL CONCRETE SHALL BE PLACED WITHIN 60 MINUTES AFTER THE TIME THAT WATER WAS FIRST ADDED TO THE MIX. THE METHOD AND MANNER OF PLACING ALL CONCRETE SHALL BE SUCH AS TO AVOID THE POSSIBILITY OF SEGREGATION OR SEPARATION OF THE AGGREGATES OR DISPLACEMENT OF THE REINFORCEMENT.
 - ALL CONCRETE SHALL BE THOROUGHLY COMPACTED BY MEANS OF INTERNAL MECHANICAL VIBRATION. CONCRETE SHALL NOT BE PERMITTED TO FALL THROUGH A HEIGHT IN EXCESS OF 1½ METRES EXCEPT THROUGH AN ENCLOSING PIPE.
 - ALL EXPOSED SURFACES SHALL BE FINISHED WITH A WOODEN FLOAT TO A SMOOTH AND EVEN SURFACE.
 - CONCRETE SHALL ARRIVE AT THE FORMS HAVING A TEMPERATURE NOT LOWER THAN 10°C NOR HIGHER THAN 22°C UNLESS OTHERWISE DIRECTED BY THE CORPORATION. SUITABLE MEANS SHALL BE PROVIDED FOR MAINTAINING ALL PARTS OF CONCRETE AT TEMPERATURE OF AT LEAST 7°C FOR NOT LESS THAN NINETY-SIX HOURS. THE METHOD OF PROTECTING THE CONCRETE SHALL BE APPROVED BY THE CORPORATION AND SHALL BE SUCH THAT LOCAL DRYING WILL BE PREVENTED.
 - ALL EXPOSED CONCRETE SURFACES SHALL BE MOIST CURED BY BEING KEPT CONTINUOUSLY WET FOR AT LEAST 7 DAYS FOLLOWING PLACEMENT AT CONCRETE.

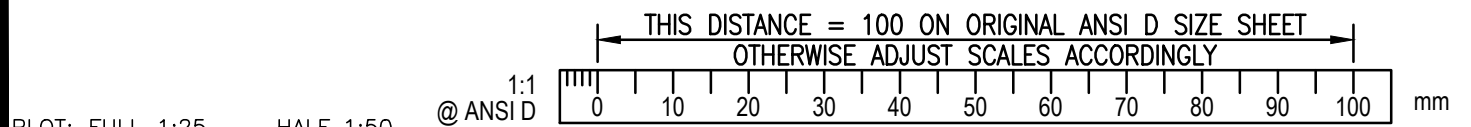

REVISIONS	ISSUE	DATE	DRAWN	CHK'D	APP'D	DESCRIPTION	ISSUE	DATE	DRAWN	CHK'D	APP'D	DESCRIPTION
A	JAN27/12	AI/S	MR	MR		ISSUED FOR TENDER						
B	APR25/12	AI/S	MR	MR		ISSUED FOR CONSTRUCTION						
C	MAY15/13	M/Mc	WB	WB		RECORD DRAWING						


DESIGNED: MR
 DRAWN: DC/KS/AIS/RB
 CHECKED: MR

OPUS DAYTONKNIGHT
 North Vancouver Office
 604-990-4800
 210-889 Harbourside Drive
 North Vancouver BC
 V7P 3S1, Canada


SUNSHINE COAST REGIONAL DISTRICT
 GARDEN BAY UV BUILDING
 STRUCTURAL - SECTIONS

SCALE: AS SHOWN
DRAWING No. 028.206
SHEET No. S4 ISSUE C

FILE: G:\D&K CAD Drawings\DKSERVER P - Shore\Records\SUNSHINE COAST\28-206\STRUCTURAL\28-206-S4.dwg Tab: S4 13-06-07 vcsjz0

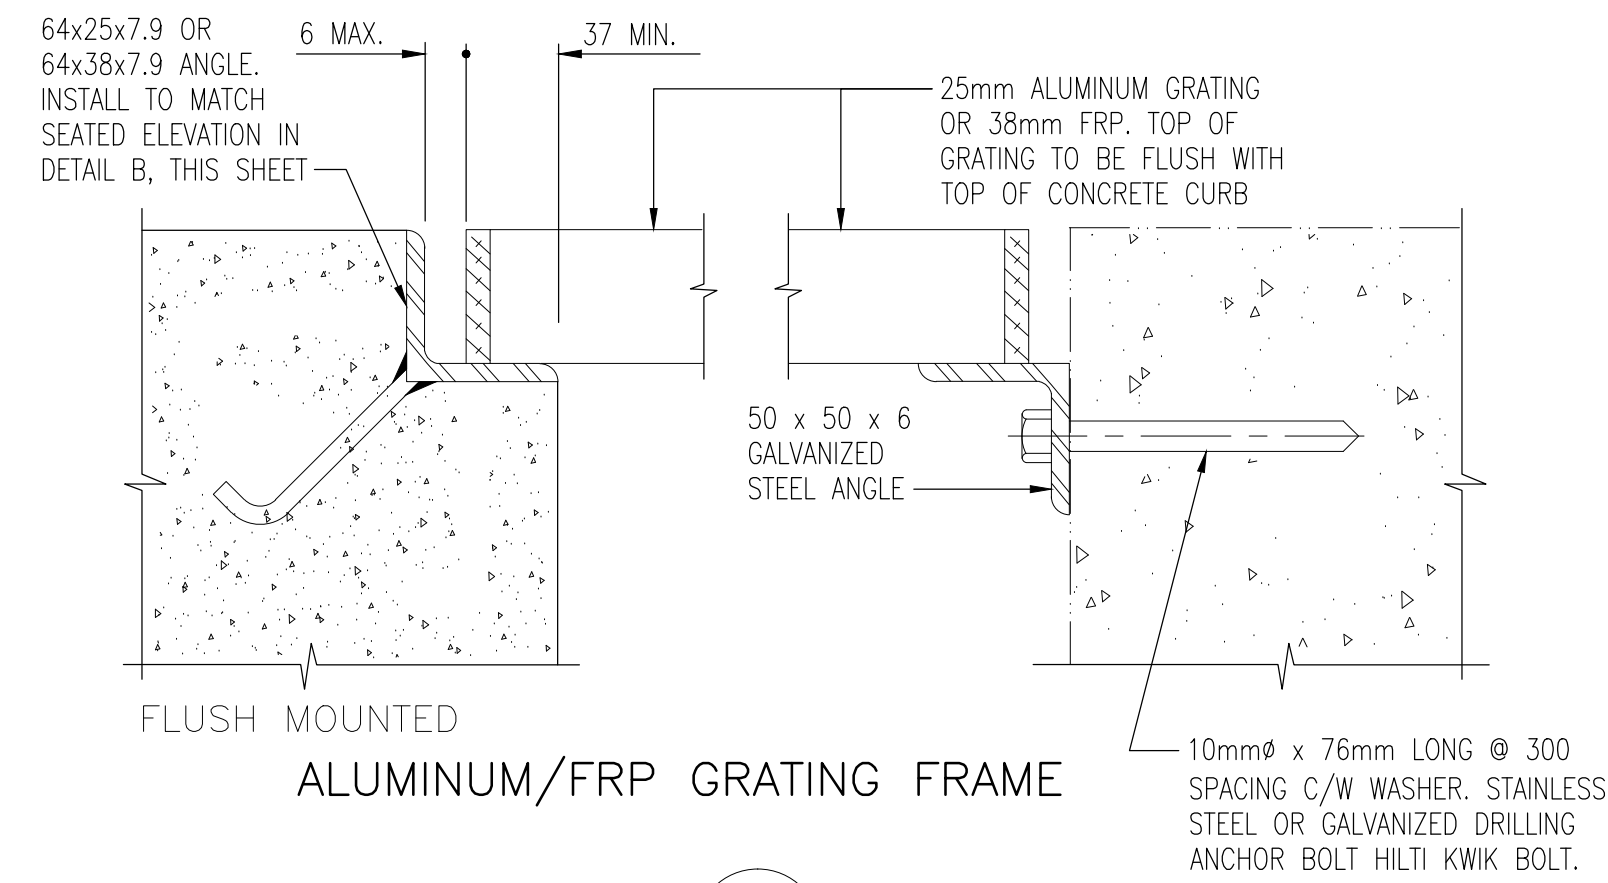


DETAIL A
NTS S3

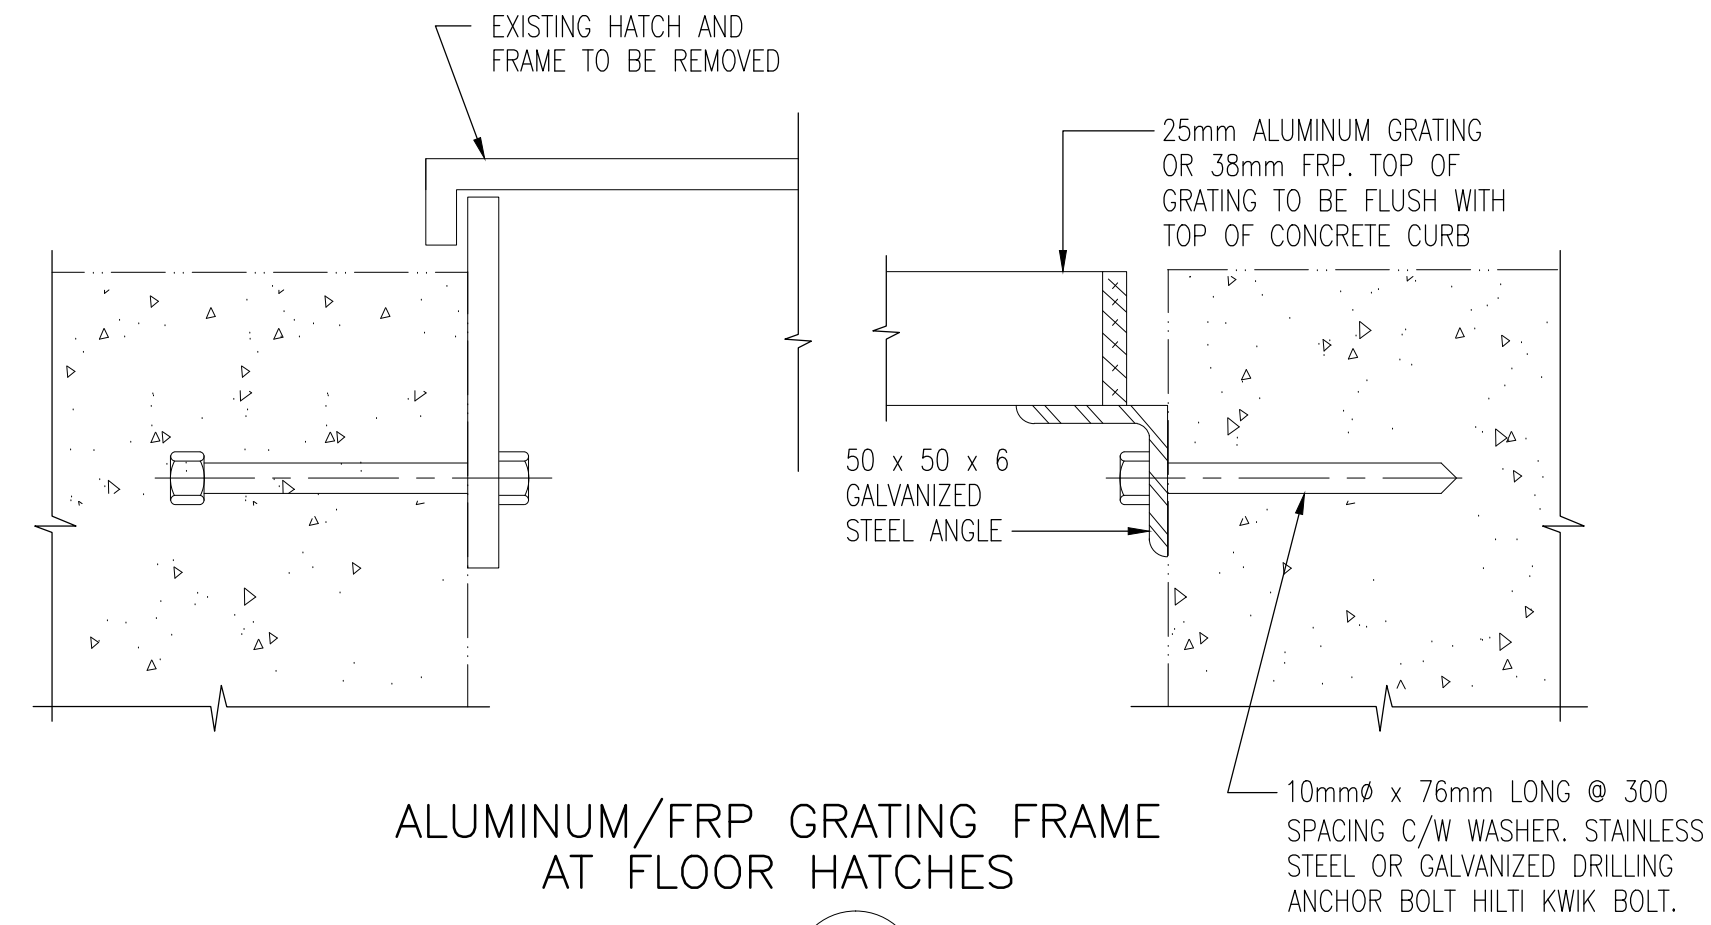

DETAIL B
NTS S3

" This Record Drawing has been prepared by Opus DaytonKnight ("Opus DK") for the exclusive use of "Sunshine Coast Regional District" (the "Client"). Any use which a third party makes of this drawing, or any reliance or decisions or actions taken by any such third party based upon this drawing, are the sole responsibility of any such third party and Opus DK accepts no responsibility, liability or risk for any damages, loss, or claims, if any, suffered by any such third party or any related party of such third party as a result of any reliance, or decisions made or actions taken, based upon this drawing. It is the user's sole responsibility to check the accuracy of this digital drawing."

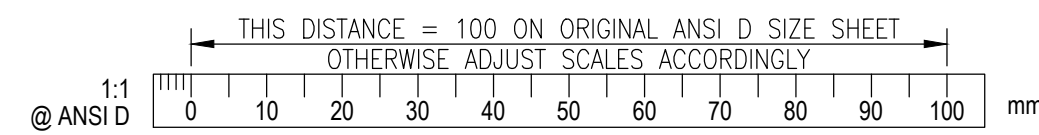

FILE: G:\DK\CAD Drawings\WORKSERVER_P_Share\Projects\SUNSHINE_COAST\28-206\STRUCTURAL\28-206-S5.dwg Tab: S5 13-06-07 vcs310




ISSUE	DATE	DRAWN	CHK'D	APP'D	DESCRIPTION	ISSUE	DATE	DRAWN	CHK'D	APP'D	DESCRIPTION
A	JAN27/12	AIS	MR	MR	ISSUED FOR TENDER						
B	APR25/12	AIS	MR	MR	ISSUED FOR CONSTRUCTION						
C	MAY15/13	MMc	WB	WB	RECORD DRAWING						

DESIGNED MR
DRAWN AIS
CHECKED MR




OPUS DAYTONKNIGHT
North Vancouver Office 210-889 Harbourside Drive
604-990-4800 North Vancouver BC
V7P 3S1, Canada

SUNSHINE COAST REGIONAL DISTRICT
GARDEN BAY UV BUILDING
STRUCTURAL - SECTIONS

SCALE: AS SHOWN		
DRAWING No. 028.206		
SHEET No.	S5	ISSUE C

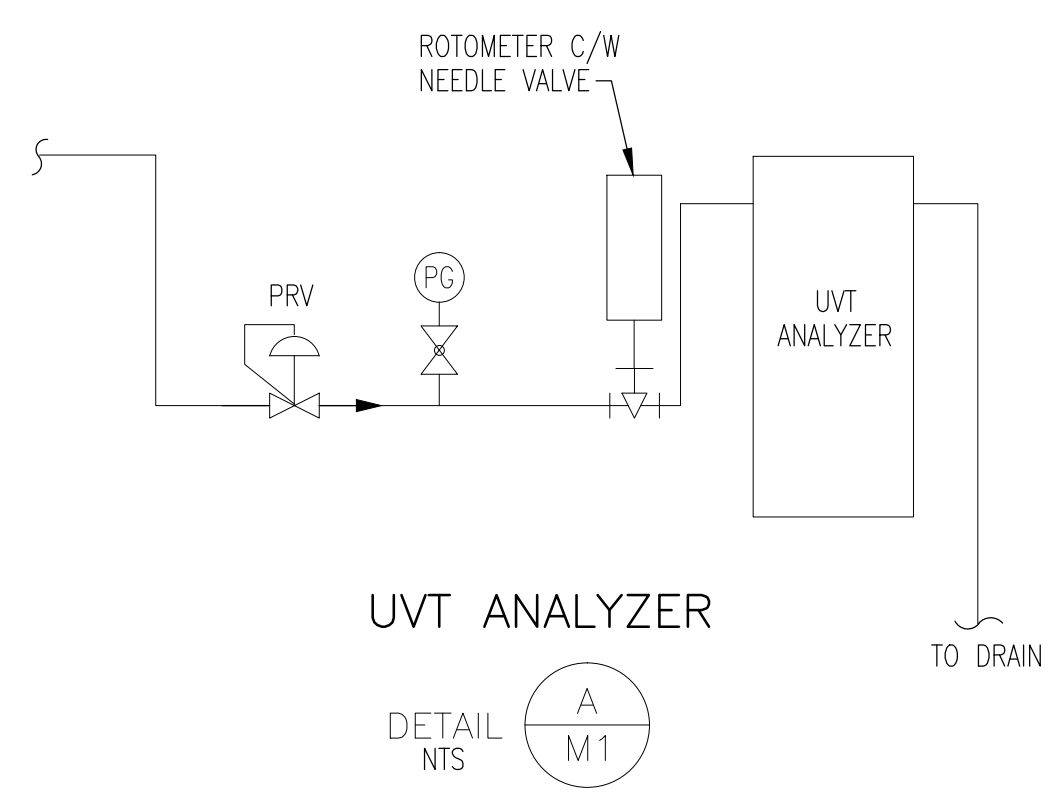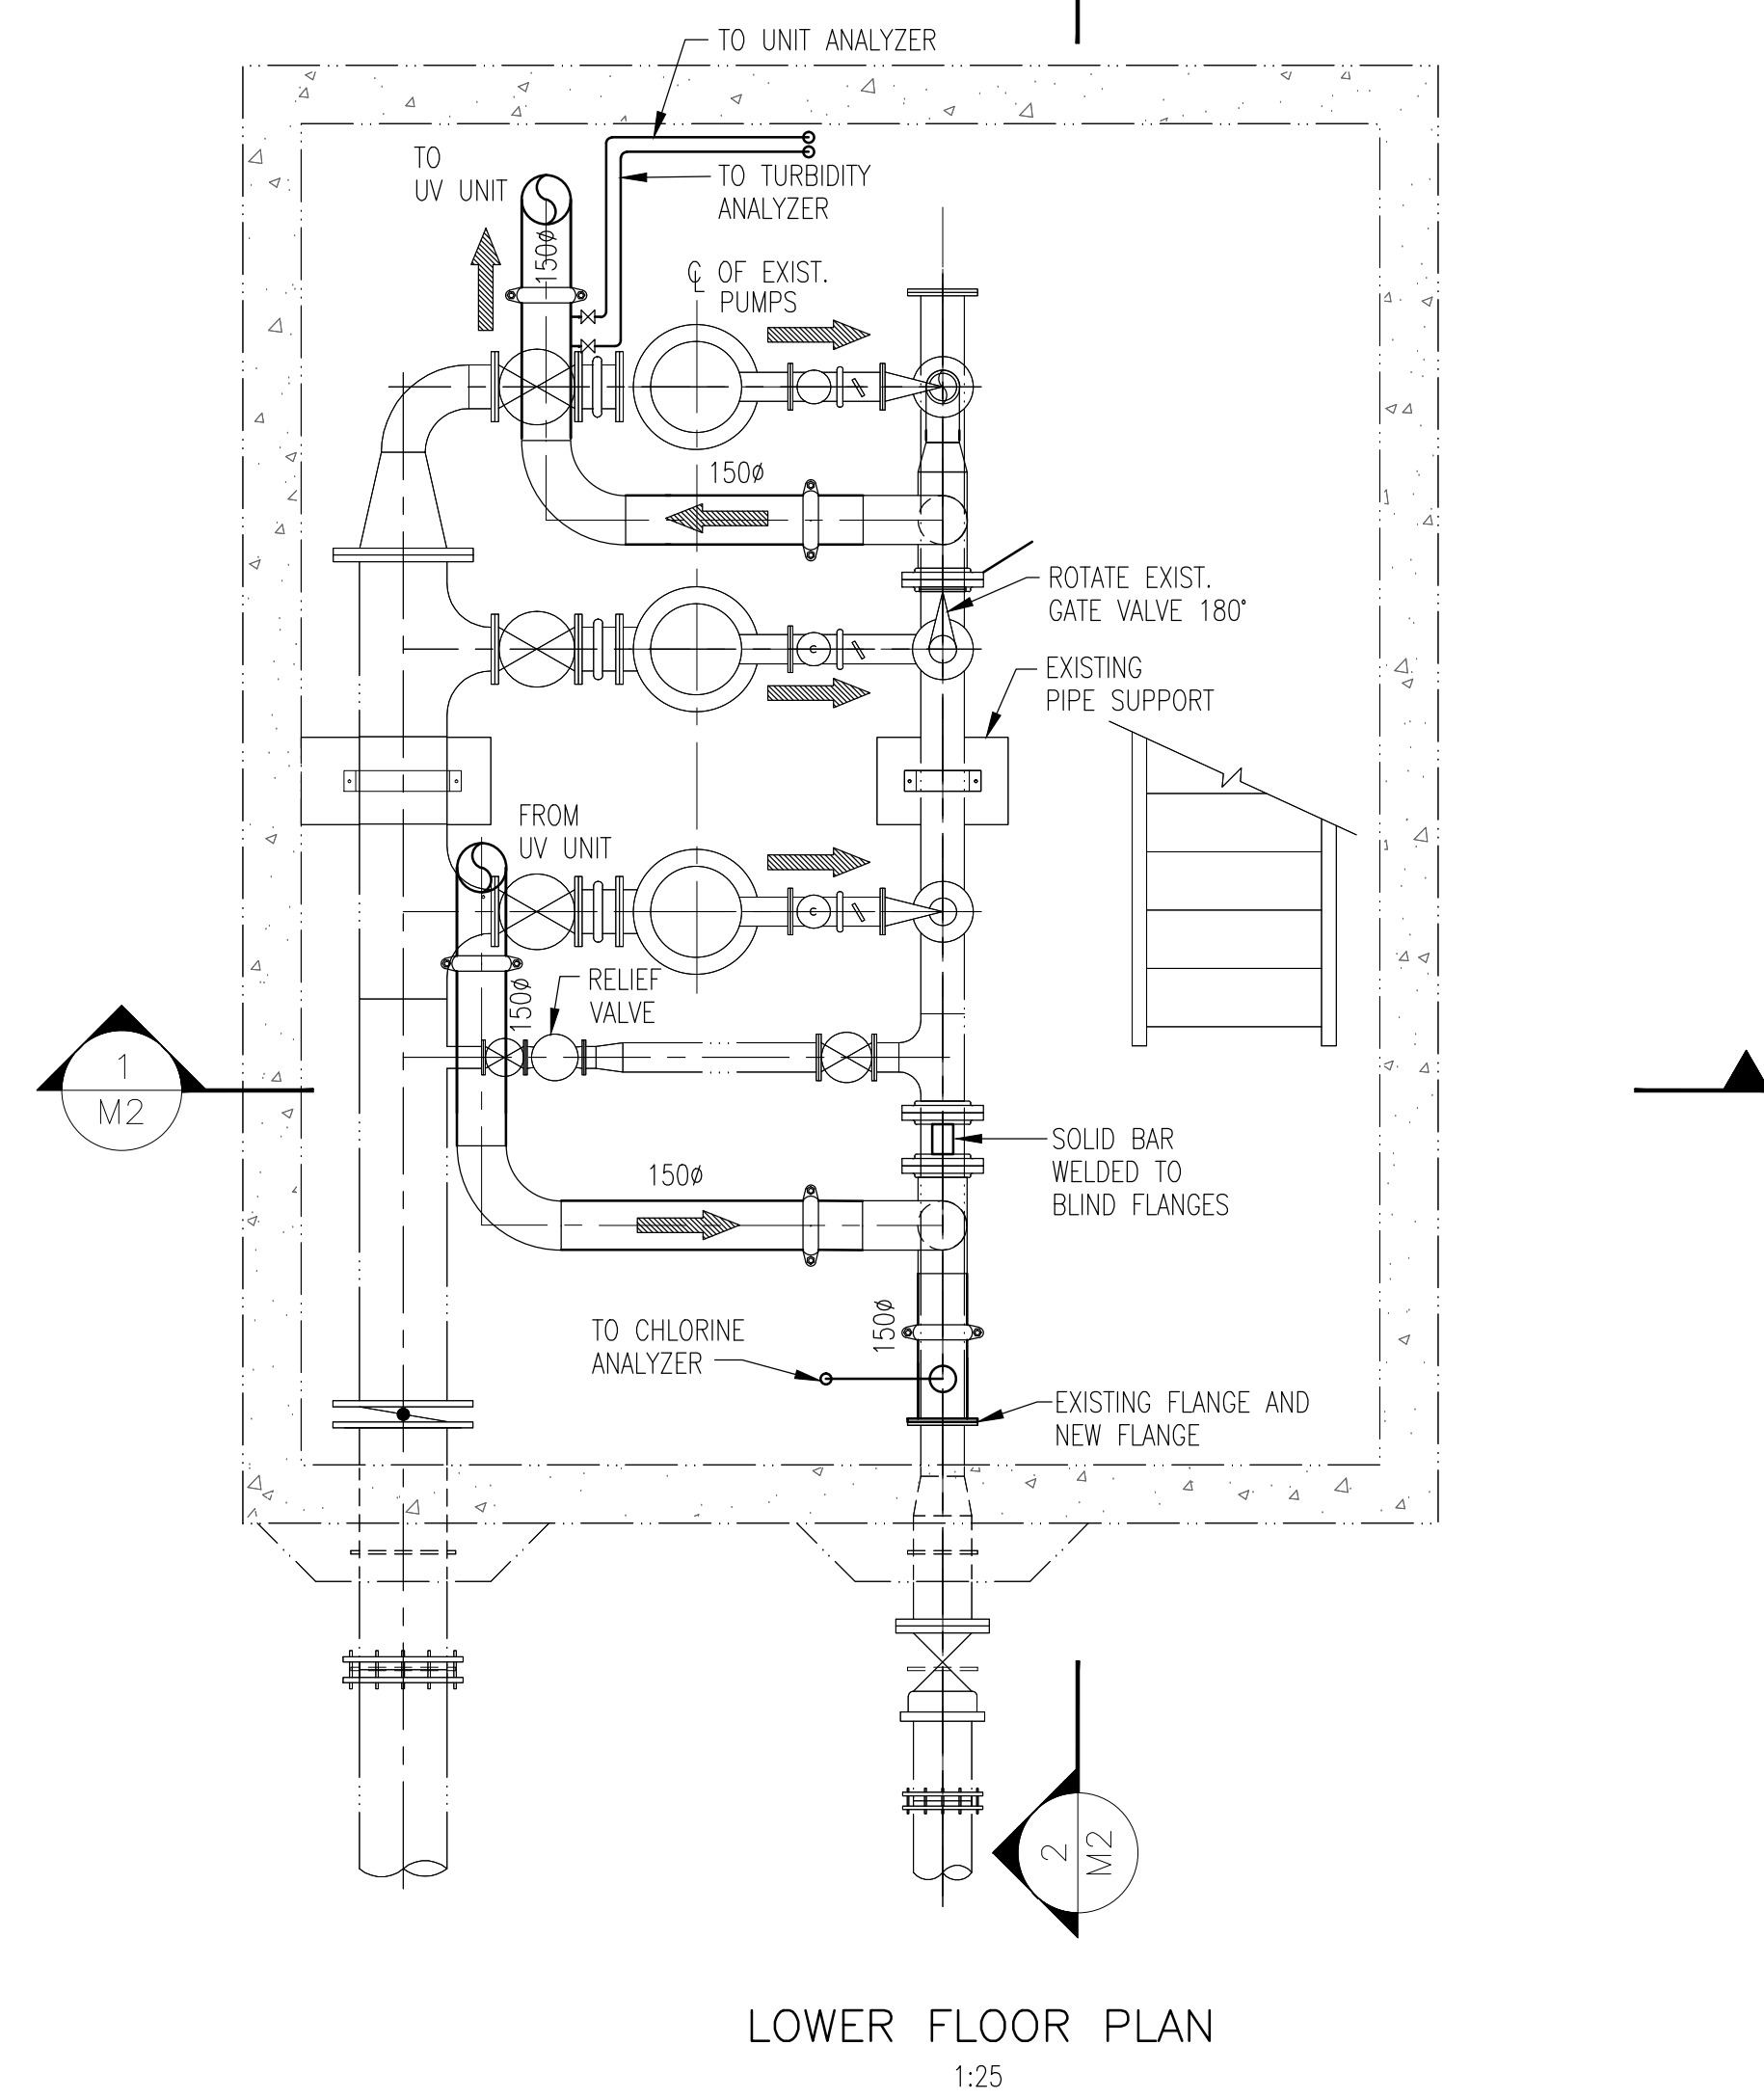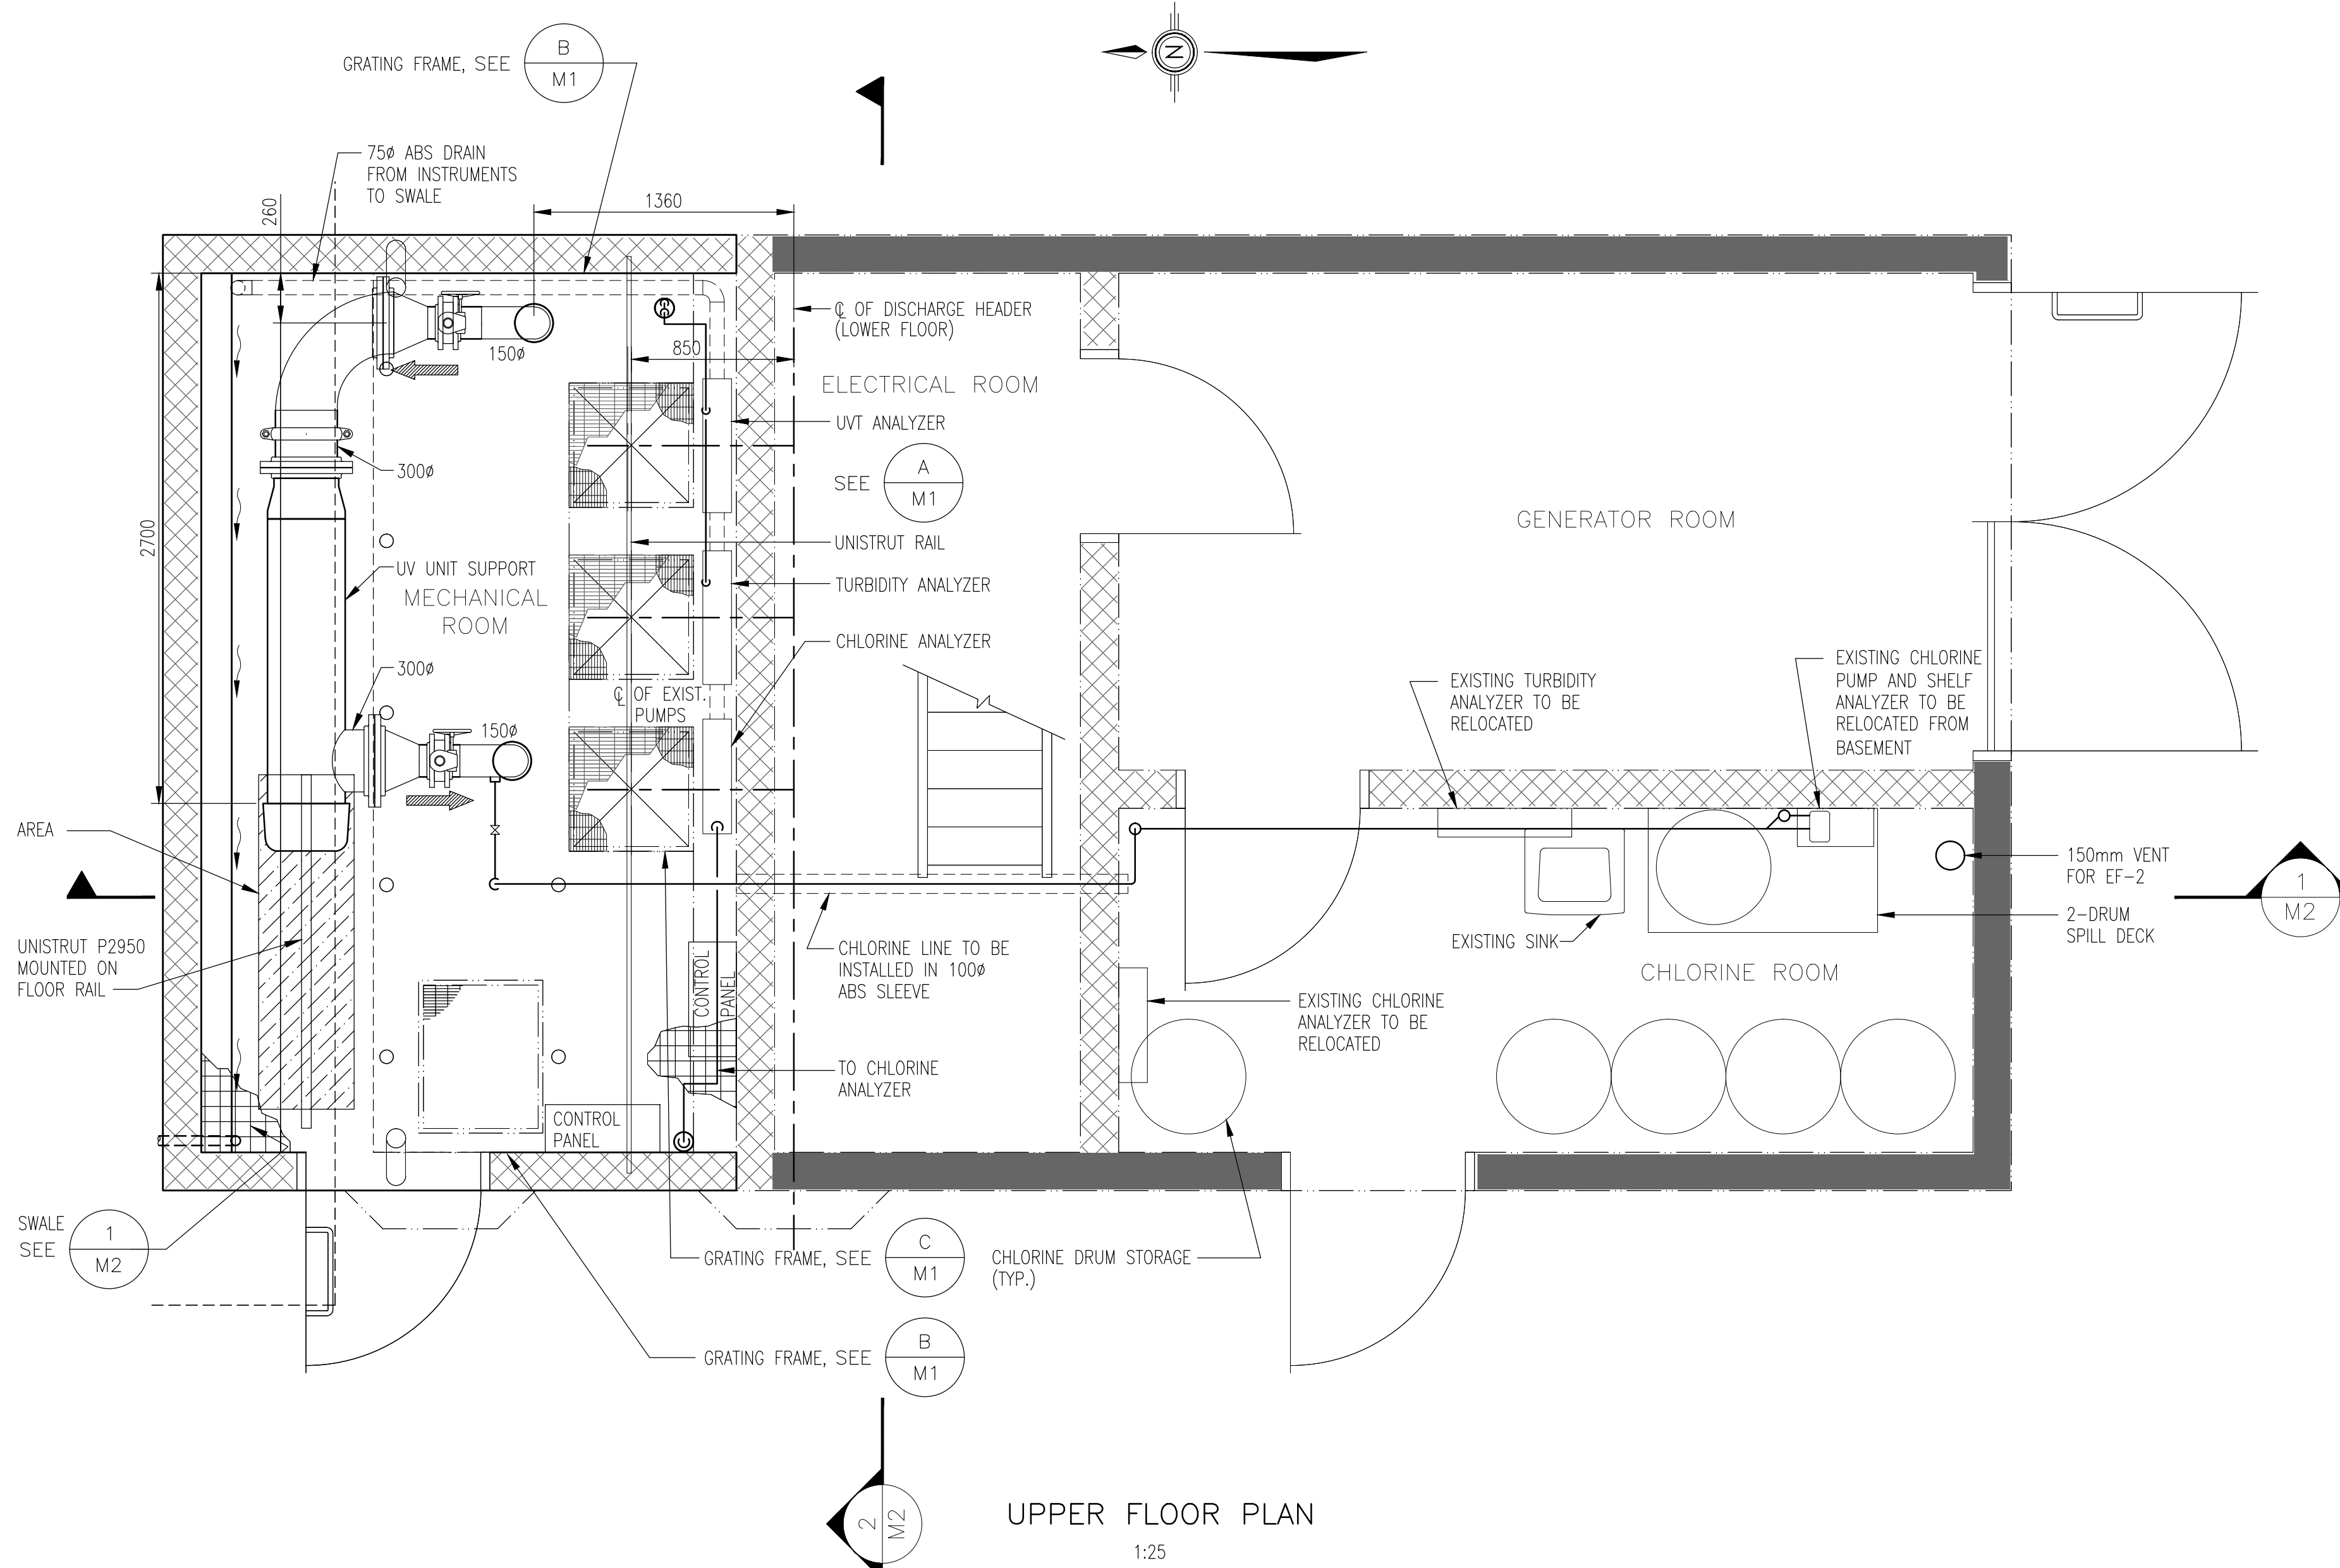

" This Record Drawing has been prepared by Opus DaytonKnight ("Opus DK") for the exclusive use of "Sunshine Coast Regional District" (the "Client"). Any use which a third party makes of this drawing, or any reliance or decisions or actions taken by any such third party based upon this drawing, are the sole responsibility of any such third party and Opus DK accepts no responsibility, liability or risk for any damages, loss, or claims, if any, suffered by any such third party or any related party of such third party as a result of any reliance, or decisions made or actions taken, based upon this drawing. It is the user's sole responsibility to check the accuracy of this digital drawing."

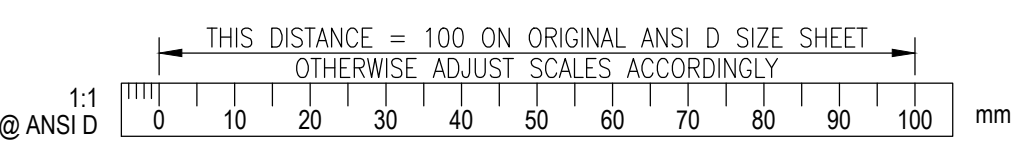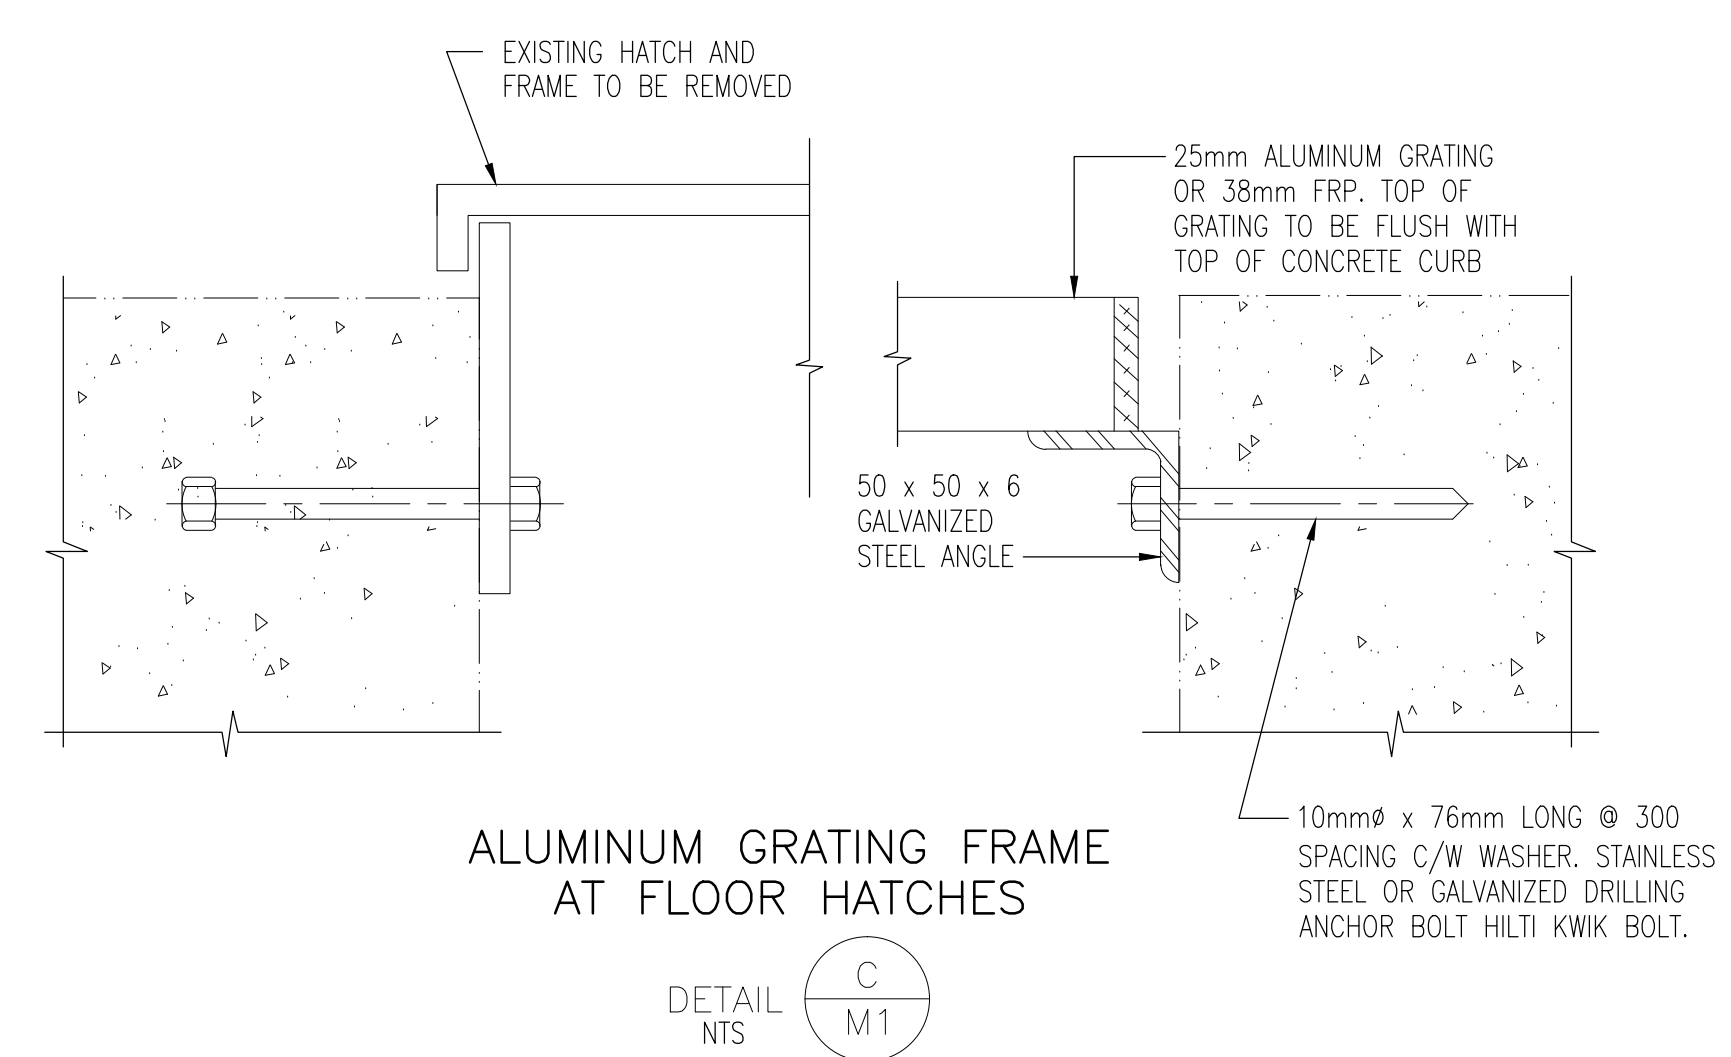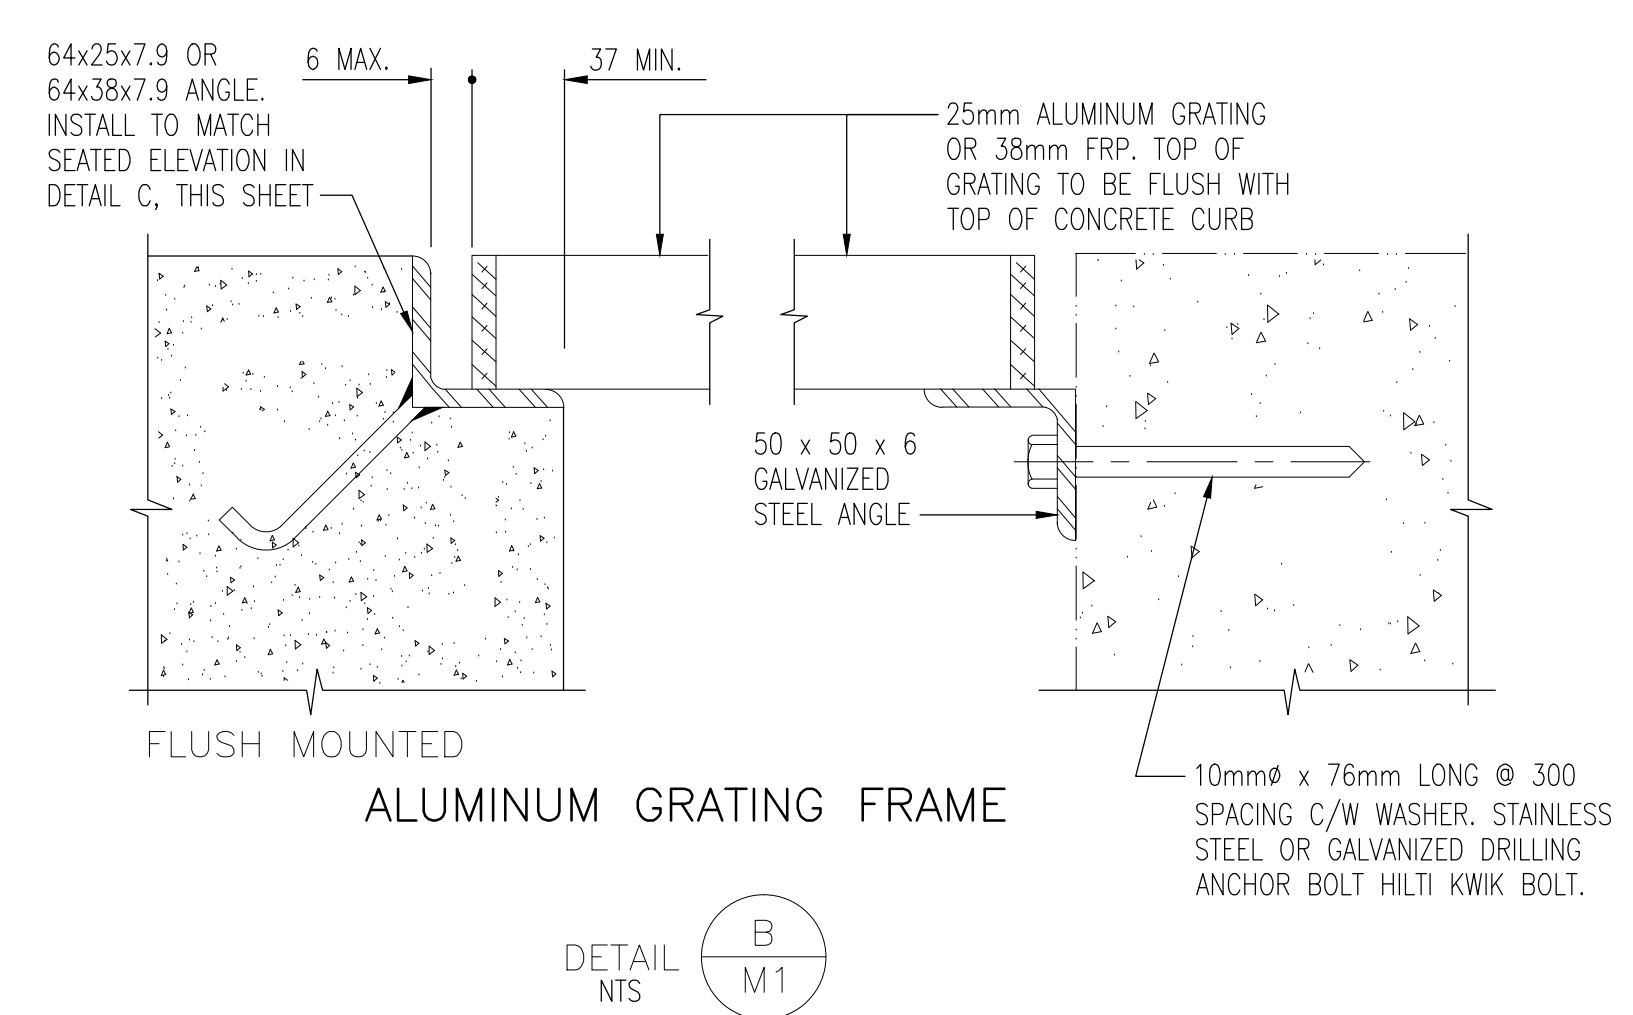

FILE: G:\DK\CAD\Drawings\KOSERVER\P_Share\Records\SUNSHINE COAST\28-206\MECHANICAL\28-206-M1.DWG Tab. M1_13-06-07 ucjzfo


ISSUE	DATE	DRAWN	CHK'D	APP'D	DESCRIPTION	ISSUE	DATE	DRAWN	CHK'D	APP'D	DESCRIPTION
A	JAN27/12	AIS	EP	EP	ISSUED FOR TENDER	D	MAY15/13	MMc	WB	WB	RECORD DRAWING
B	FEB16/12	RB	ZA	WB	ADDENDUM NO. 2 - AS SHOWN						
C	APR25/12	RB	ZA	WB	ISSUED FOR CONSTRUCTION						

DESIGNED EP
 DRAWN DC/KS/RB
 CHECKED EP

OPUS DAYTONKNIGHT
 North Vancouver Office 604-990-4800
 210-889 Harbourside Drive North Vancouver BC V7P 3S1, Canada


SUNSHINE COAST REGIONAL DISTRICT
 GARDEN BAY UV BUILDING
 MECHANICAL - PLANS

SCALE: AS SHOWN
DRAWING No. 028.206
SHEET No. M1 ISSUE D

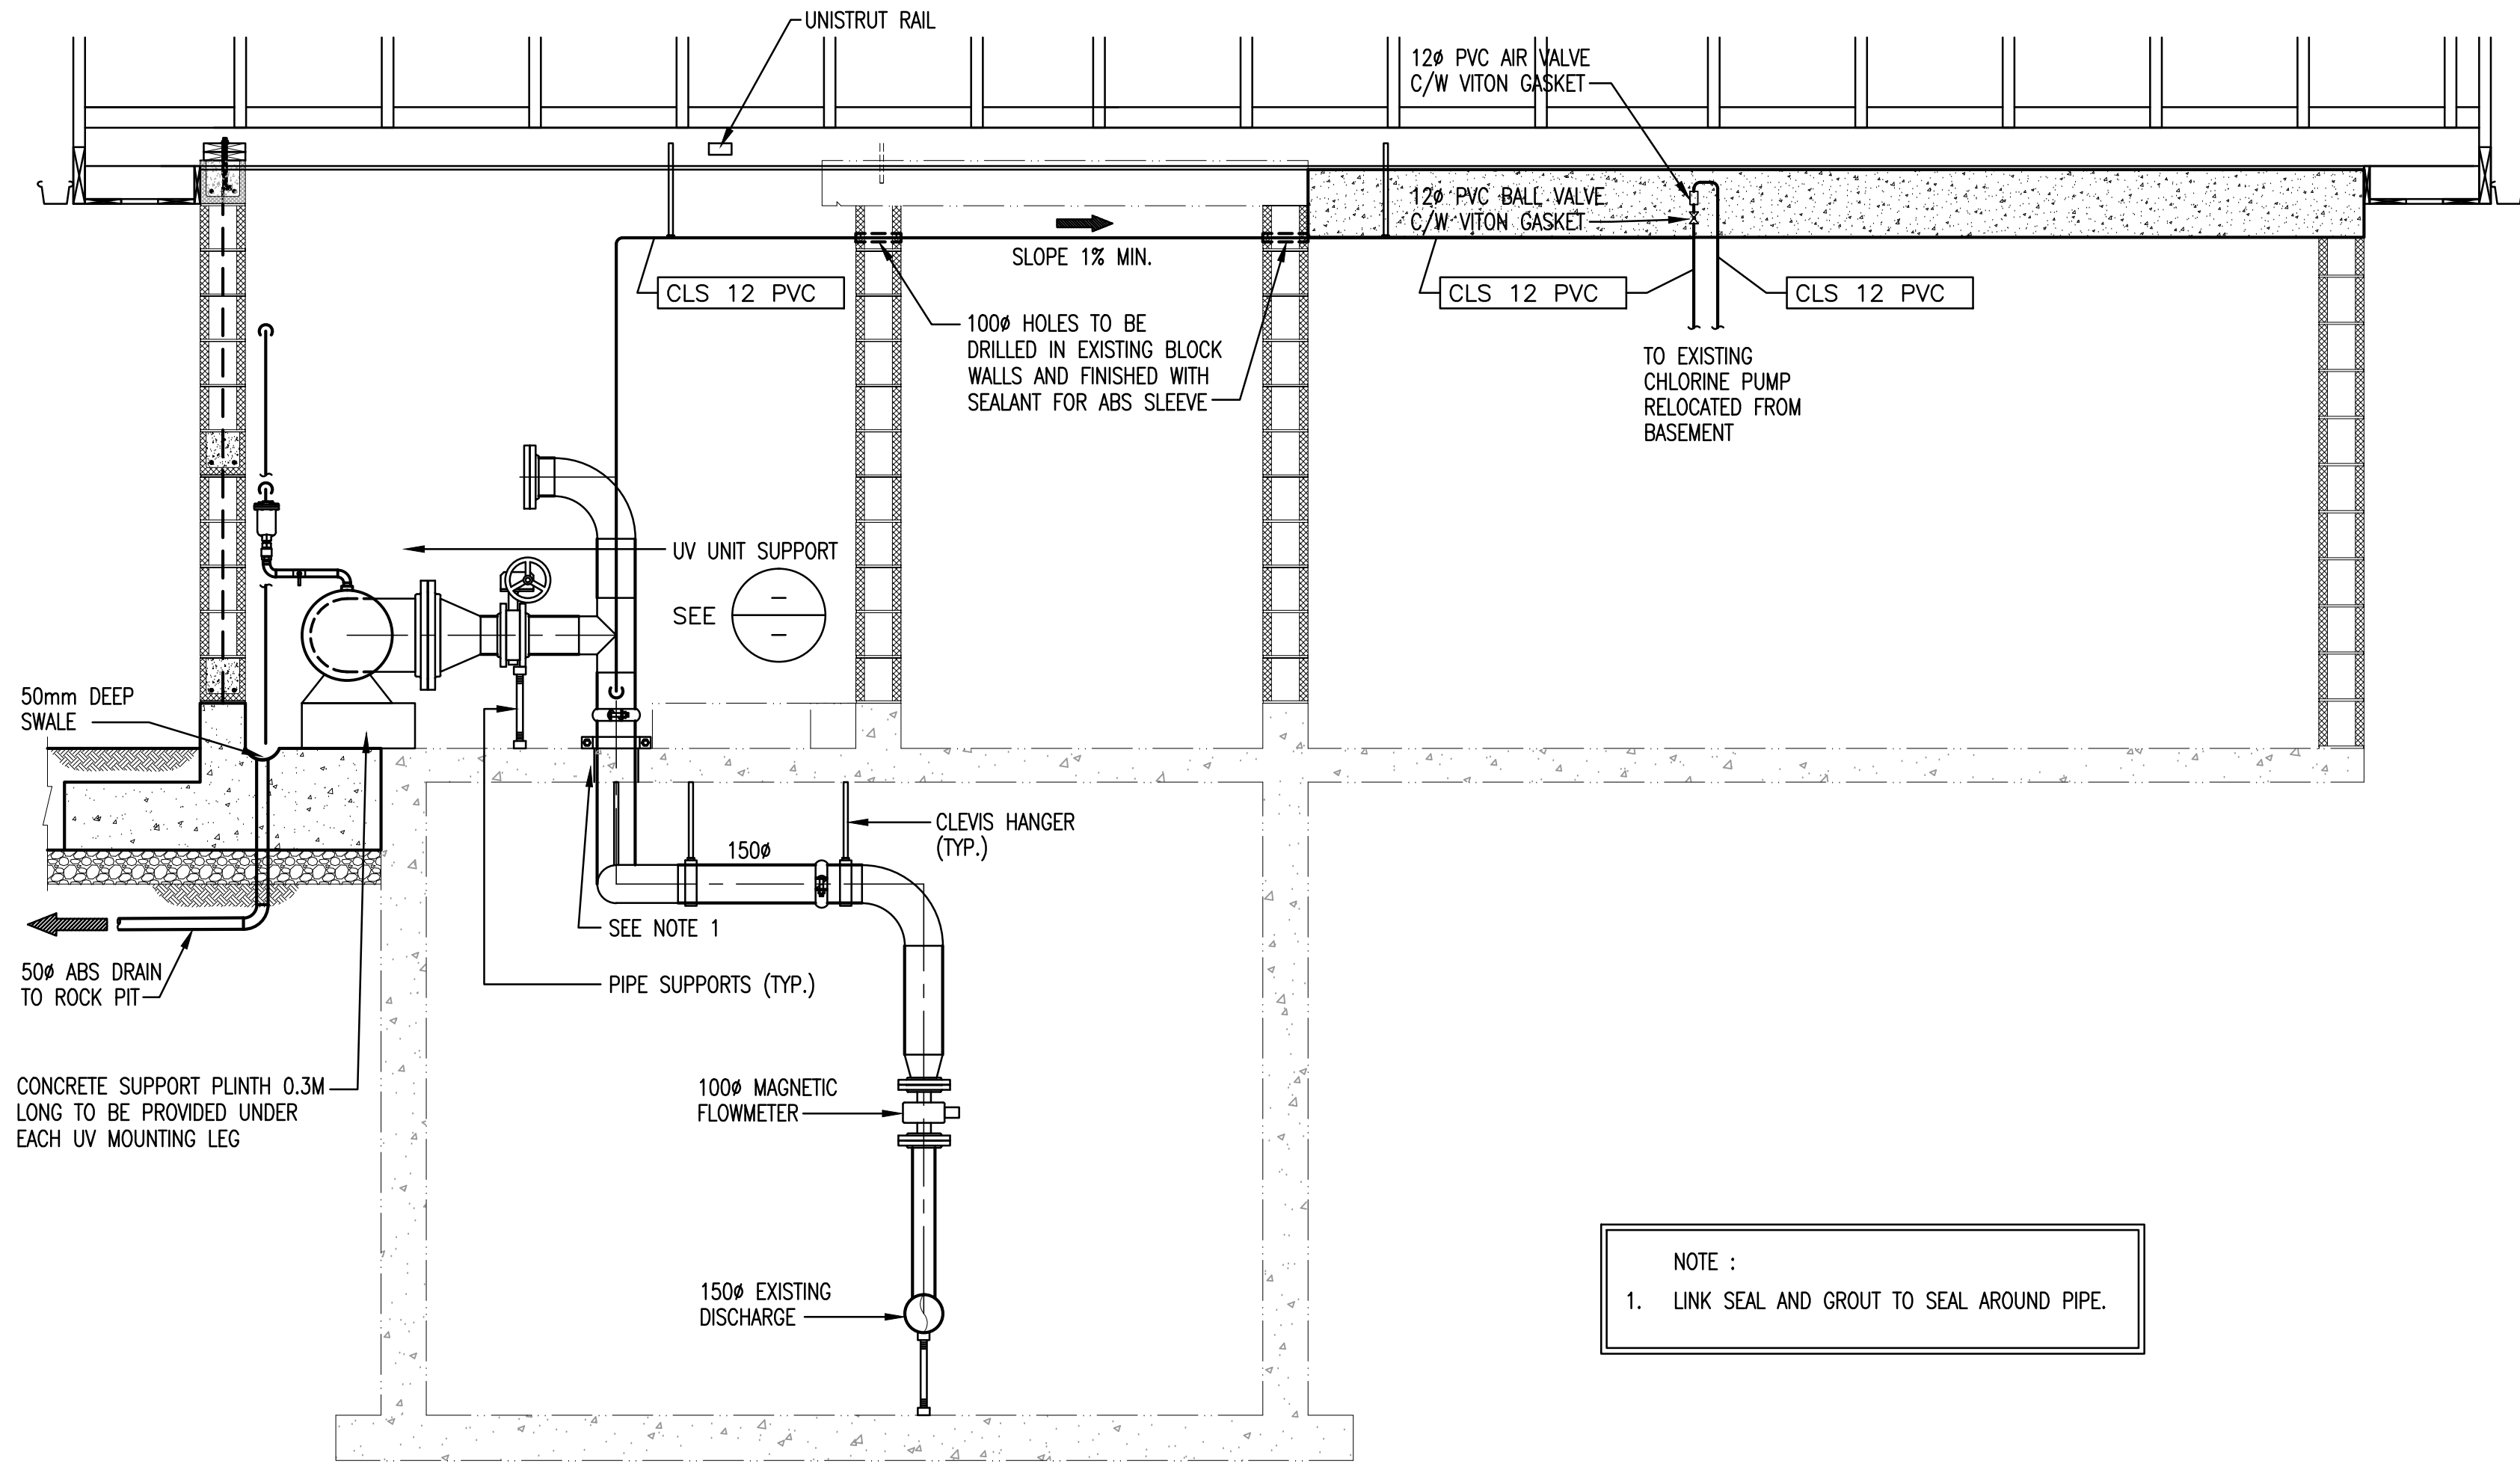


SECTION 1
1:25

NOTE :
1. LINK SEAL AND GROUT TO SEAL AROUND PIPE.

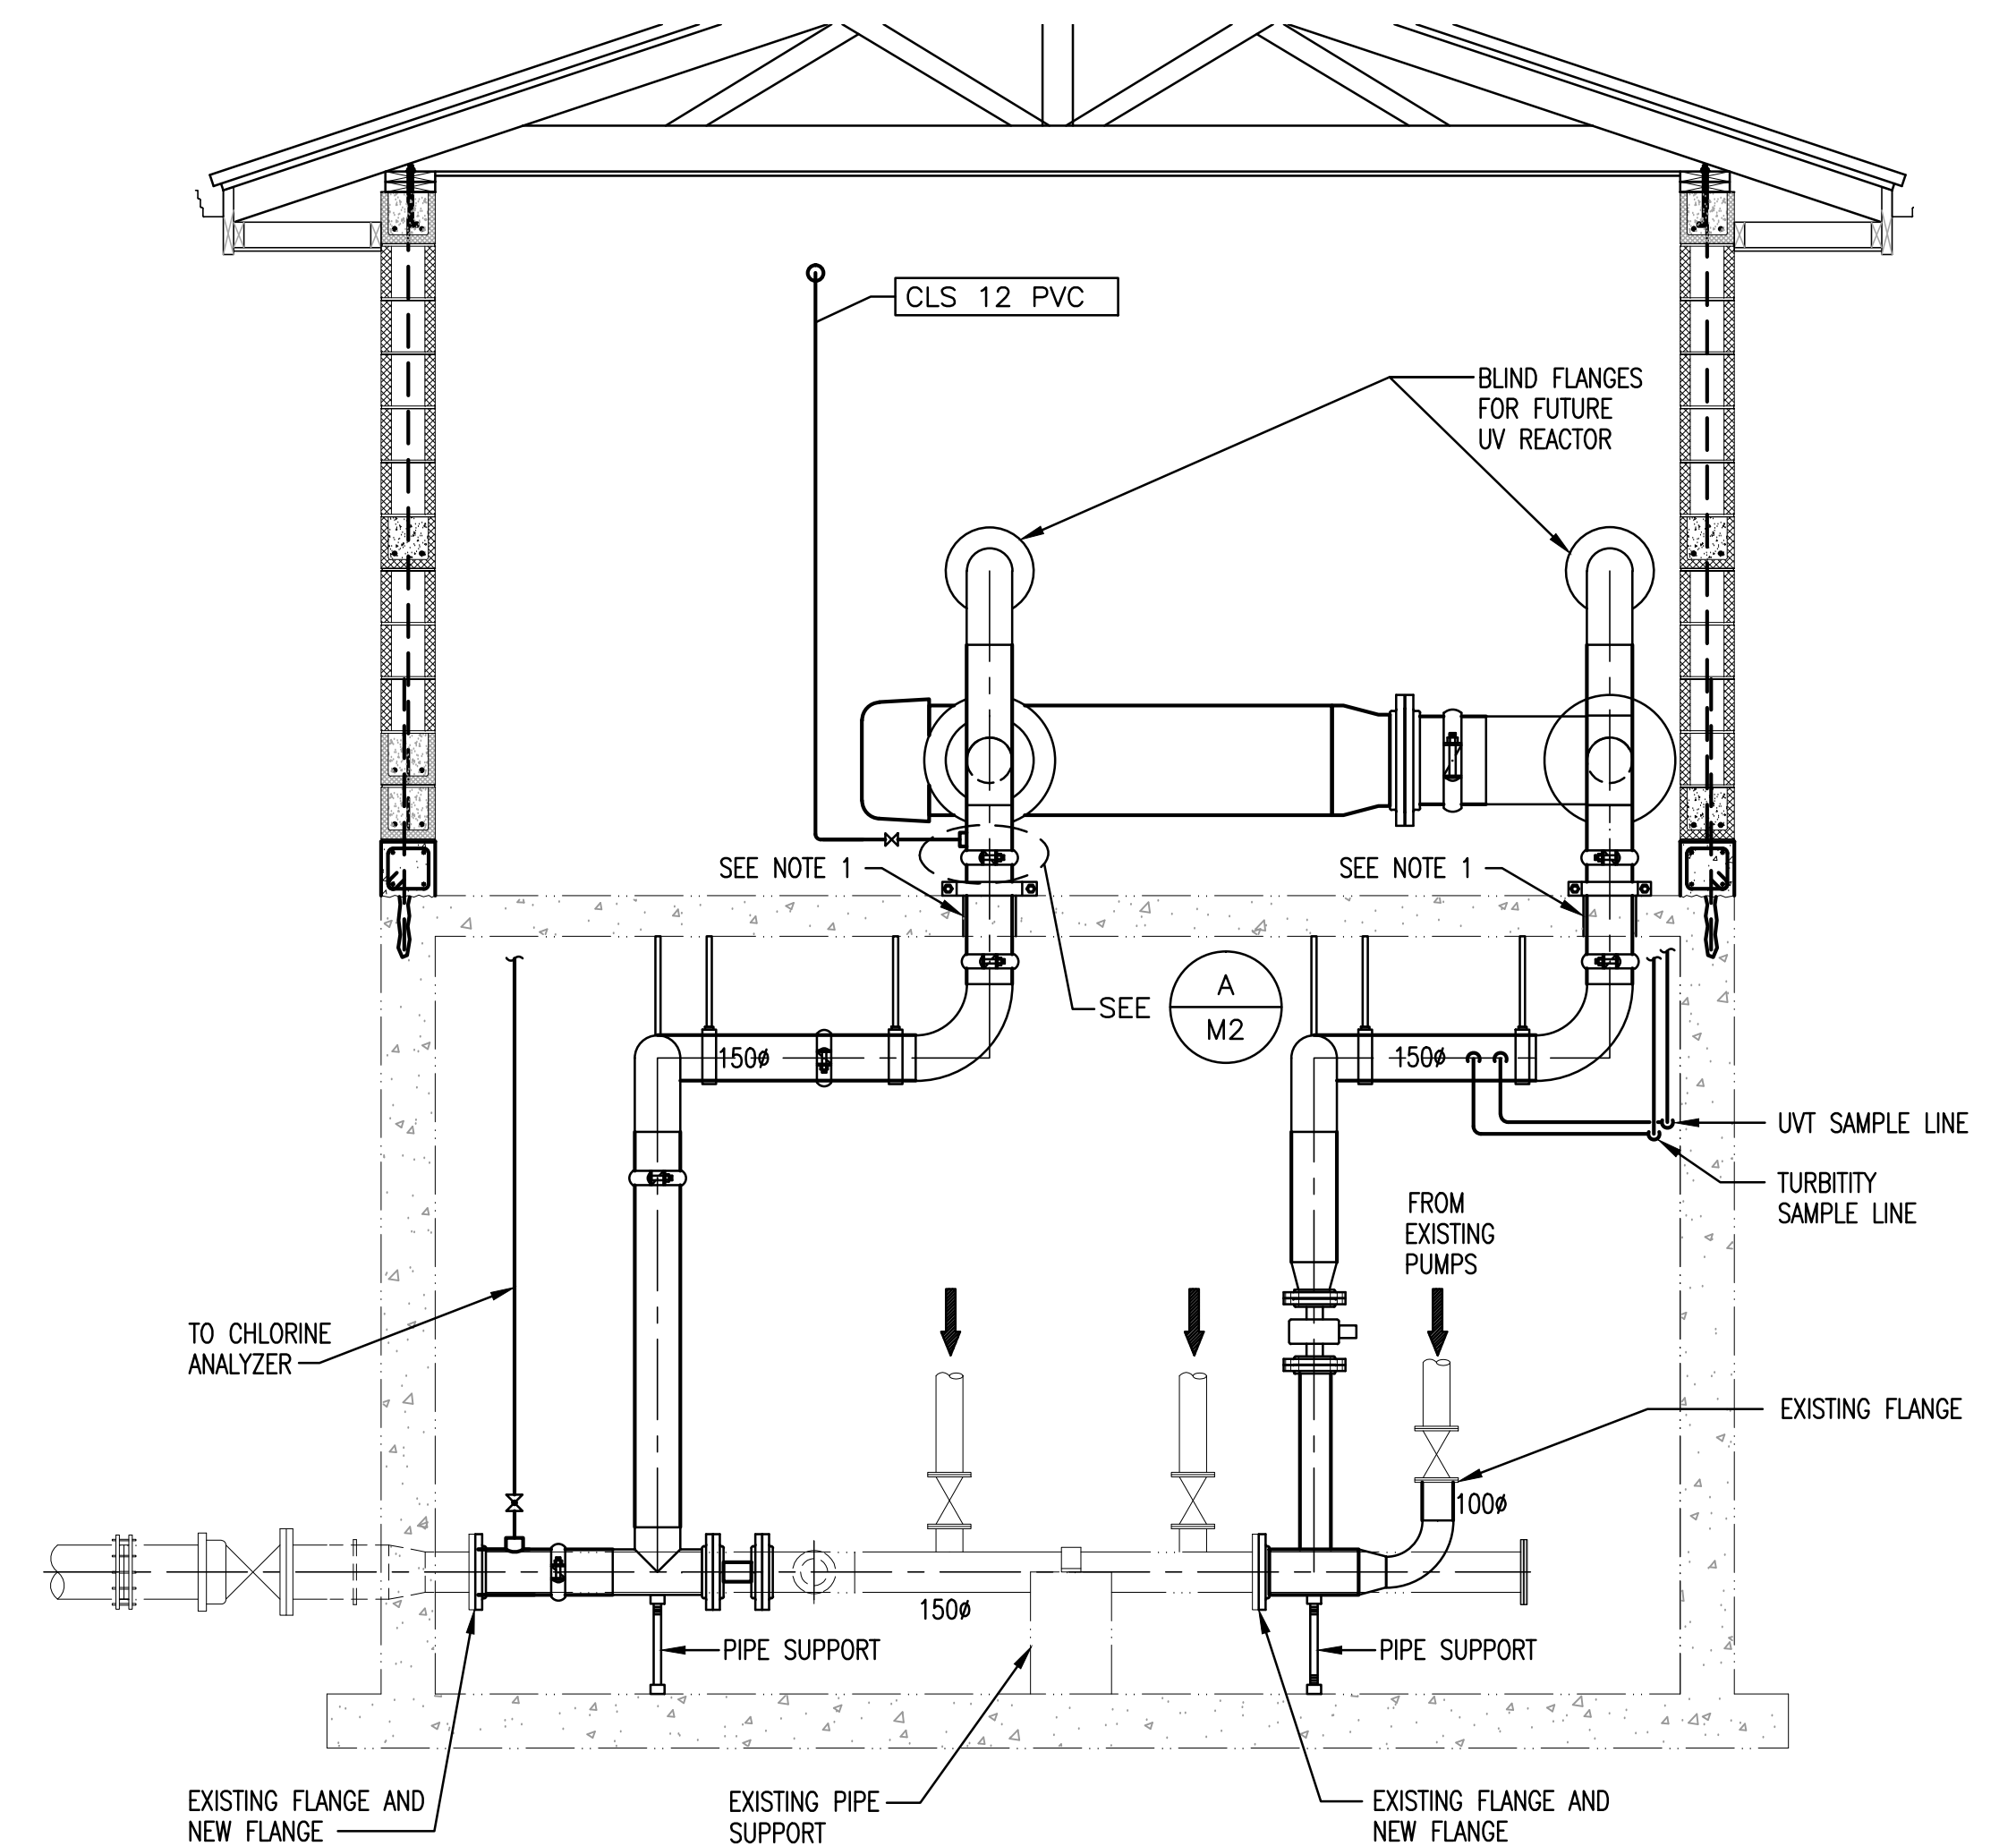


SECTION 2
1:25

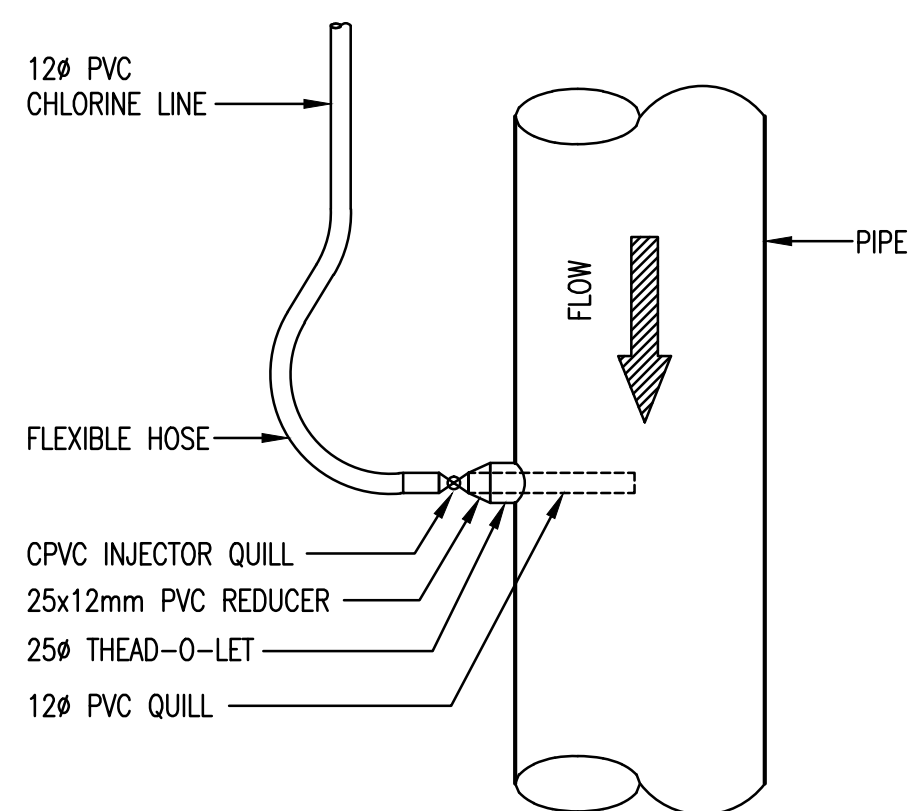

CHLORINE INJECTOR

DETAIL A
M2

" This Record Drawing has been prepared by Opus DaytonKnight ("Opus DK") for the exclusive use of "Sunshine Coast Regional District" (the "Client"). Any use which a third party makes of this drawing, or any reliance or decisions or actions taken by any such third party based upon this drawing, are the sole responsibility of any such third party and Opus DK accepts no responsibility, liability or risk for any damages, loss, or claims, if any, suffered by any such third party or any related party of such third party as a result of any reliance, or decisions made or actions taken, based upon this drawing. It is the user's sole responsibility to check the accuracy of this digital drawing."

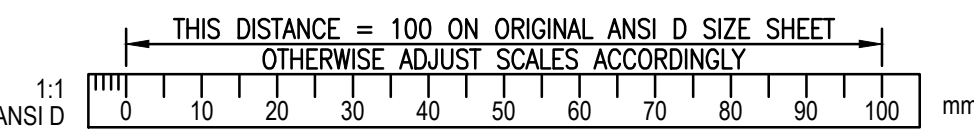

FILE: G:\DK CAD Drawings\KORSEVER P Share\Receivng\SUNSHINE COAST\28-206\MECHANICAL\28-206-M2.dwg Tab: M2 13-08-07



ISSUE	DATE	DRAWN	CHK'D	APP'D	DESCRIPTION	ISSUE	DATE	DRAWN	CHK'D	APP'D	DESCRIPTION
A	JAN27/12	AIS	EP	EP	ISSUED FOR TENDER	D	MAY15/13	MMc	WB	WB	RECORD DRAWING
B	FEB16/12	RB	ZA	WB	ADDENDUM NO. 2 - AS SHOWN						
C	APR25/12	RB	ZA	WB	ISSUED FOR CONSTRUCTION						

DESIGNED EP
DRAWN KS/RB
CHECKED EP



OPUS DAYTONKNIGHT
North Vancouver Office
604-990-4800
210-889 Harbourside Drive
North Vancouver BC
V7P 3S1, Canada

SUNSHINE COAST REGIONAL DISTRICT
GARDEN BAY UV BUILDING
MECHANICAL - SECTIONS

SCALE: AS SHOWN		
DRAWING No. 028.206		
SHEET No.	M2	ISSUE D

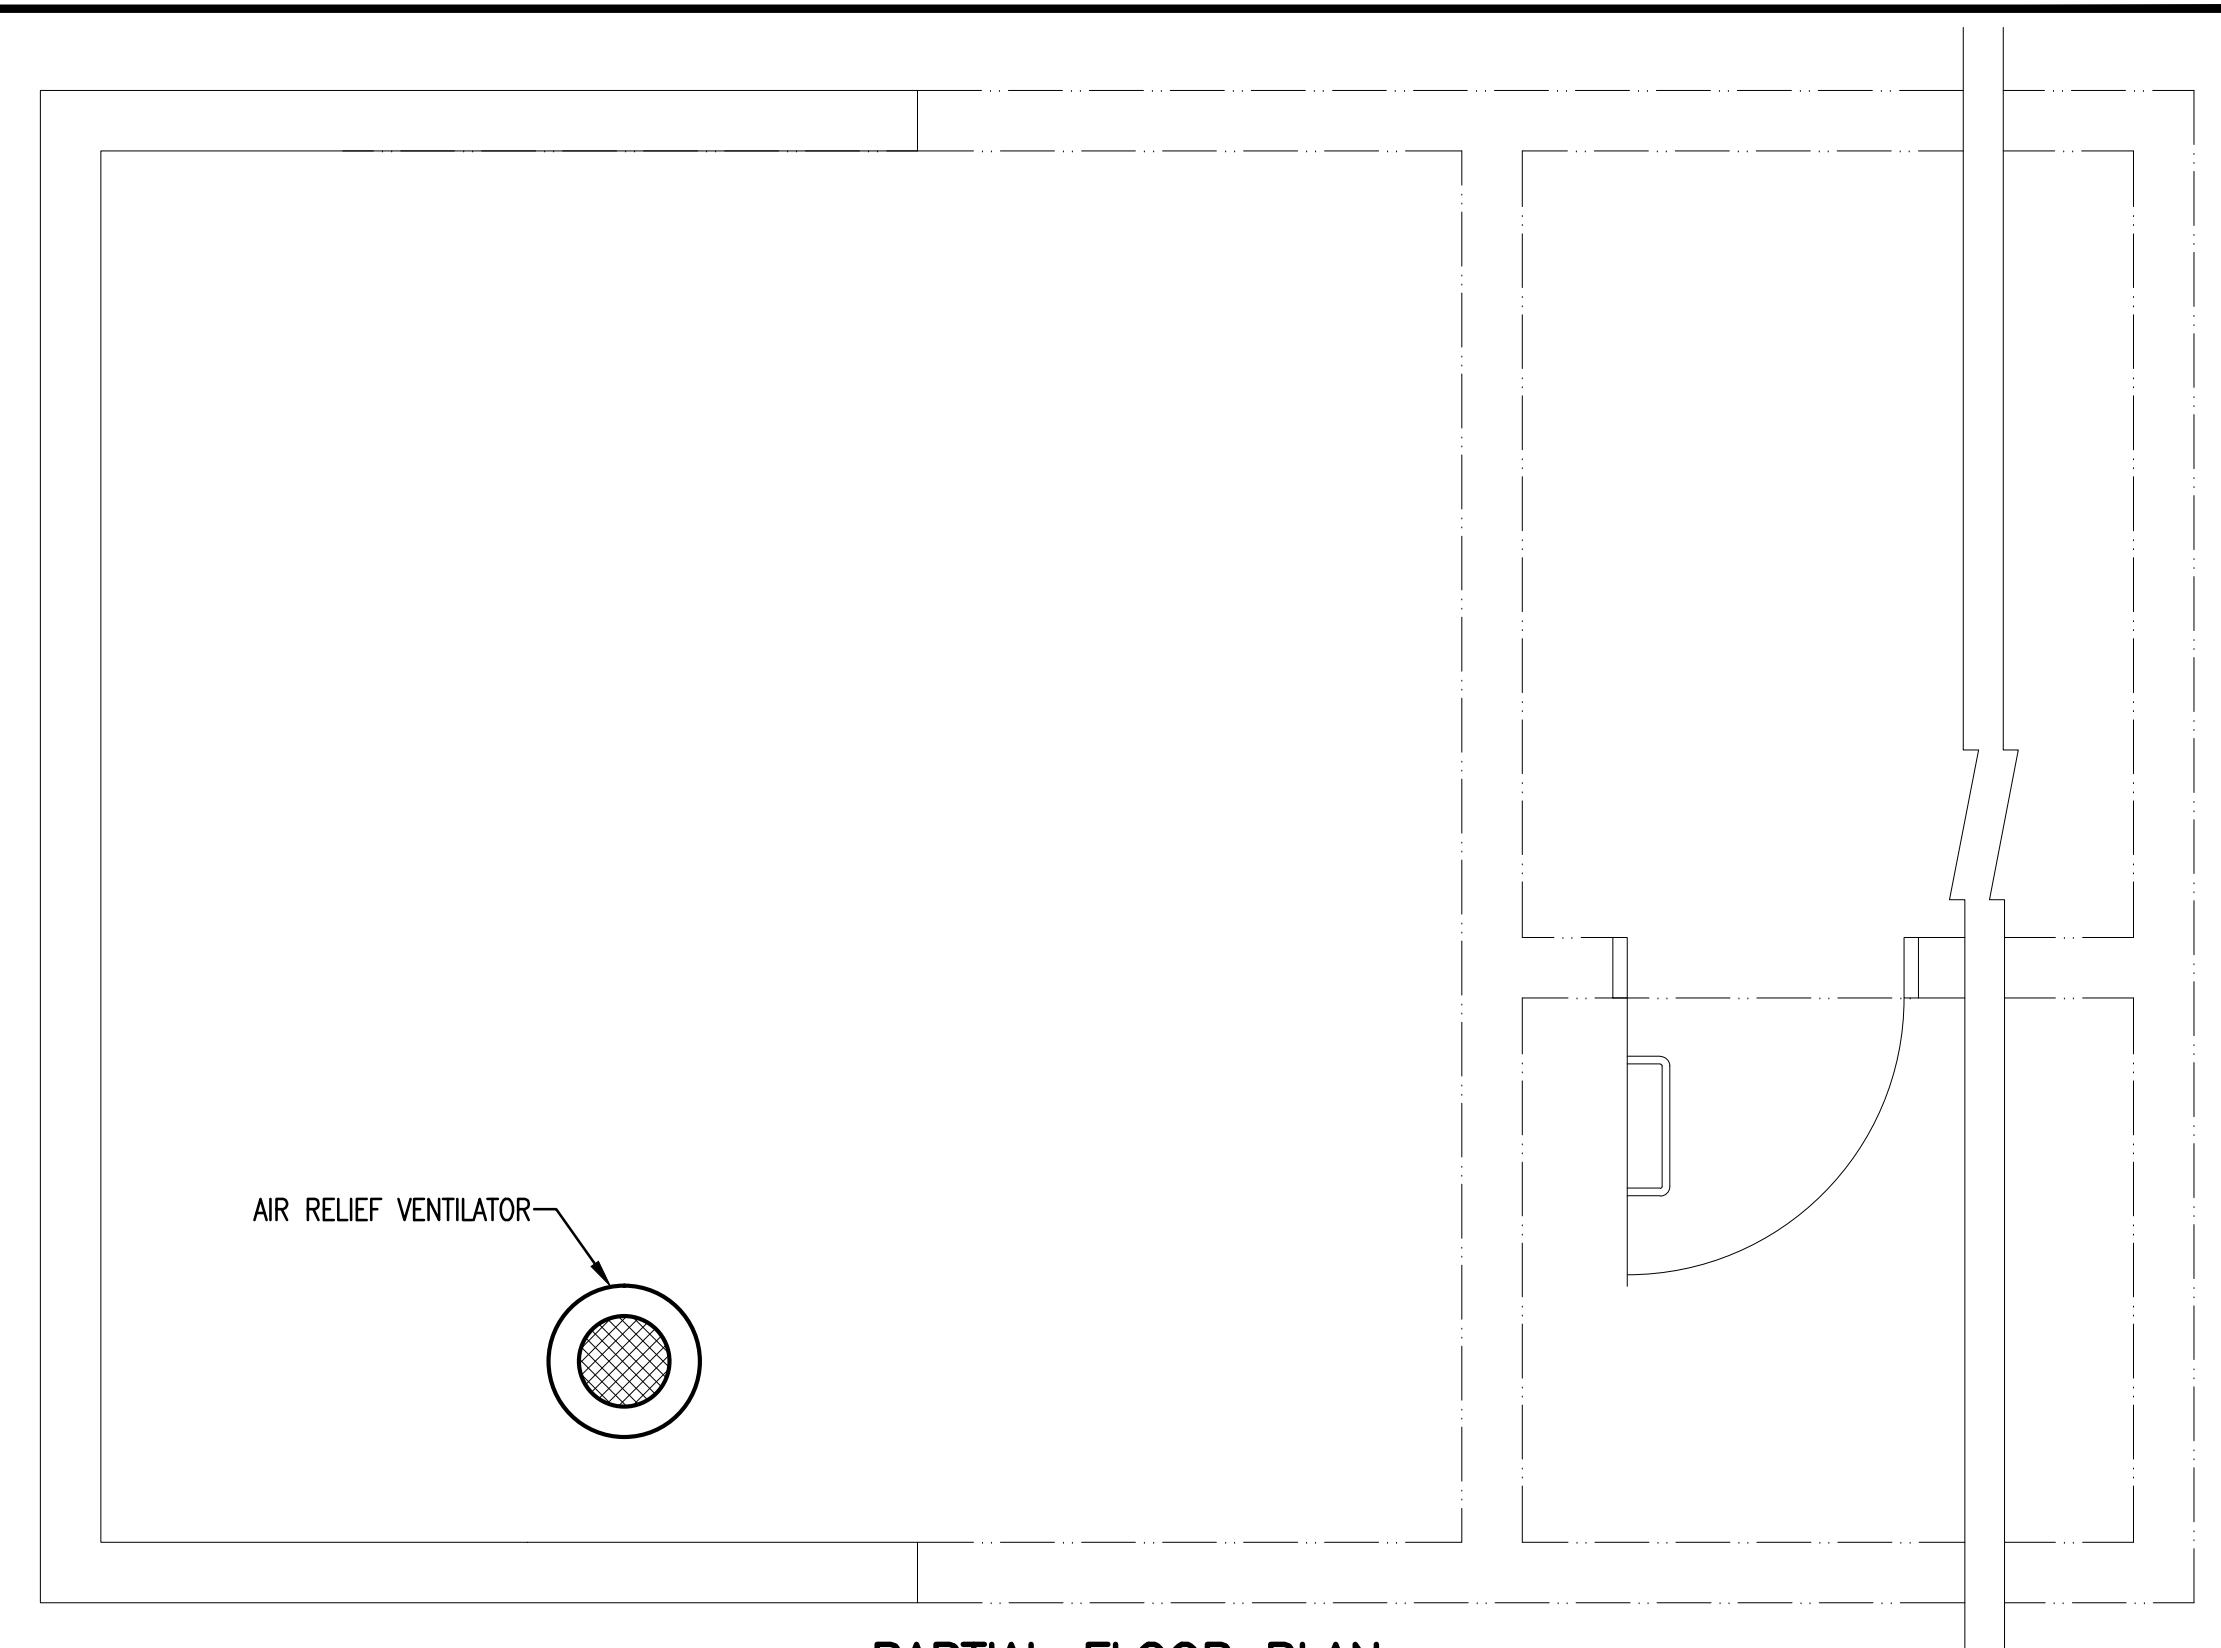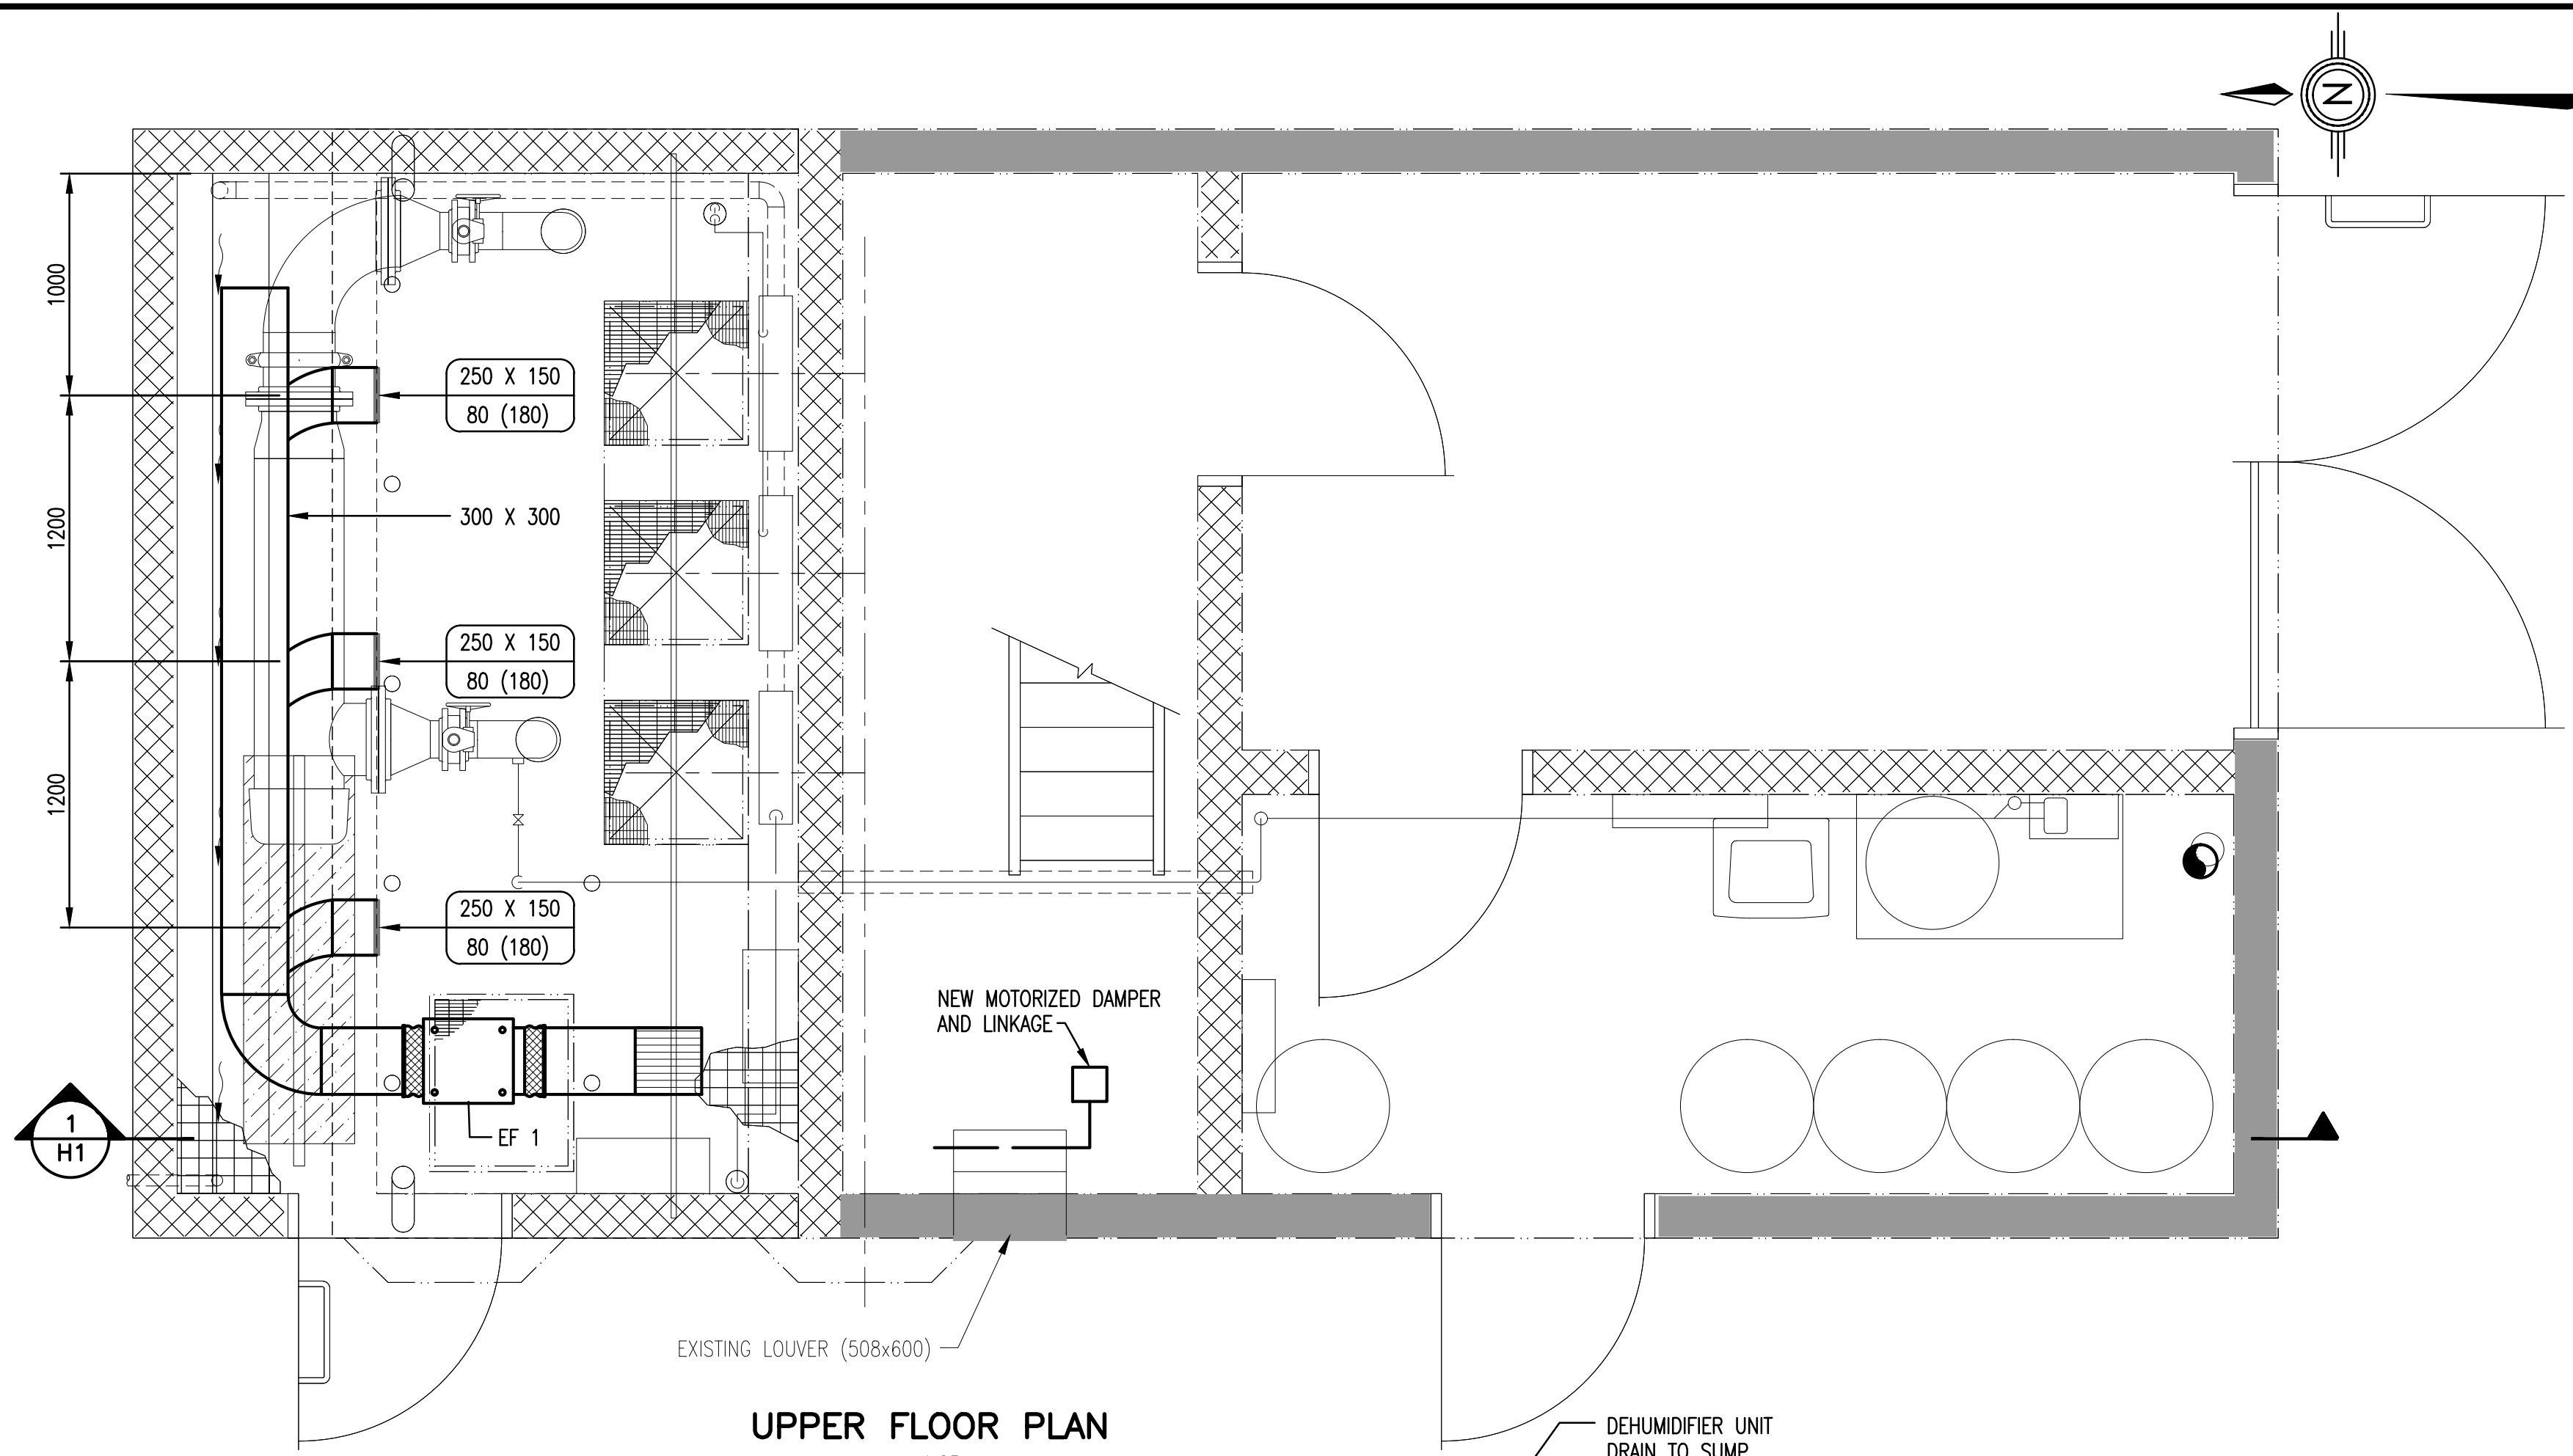

" This Record Drawing has been prepared by Opus DaytonKnight ("Opus DK") for the exclusive use of "Sunshine Coast Regional District" (the "Client"). Any use which a third party makes of this drawing, or any reliance or decisions or actions taken by any such third party based upon this drawing, are the sole responsibility of any such third party and Opus DK accepts no responsibility, liability or risk for any damages, loss, or claims, if any, suffered by any such third party or any related party of such third party as a result of any reliance, or decisions made or actions taken, based upon this drawing. It is the user's sole responsibility to check the accuracy of this digital drawing."

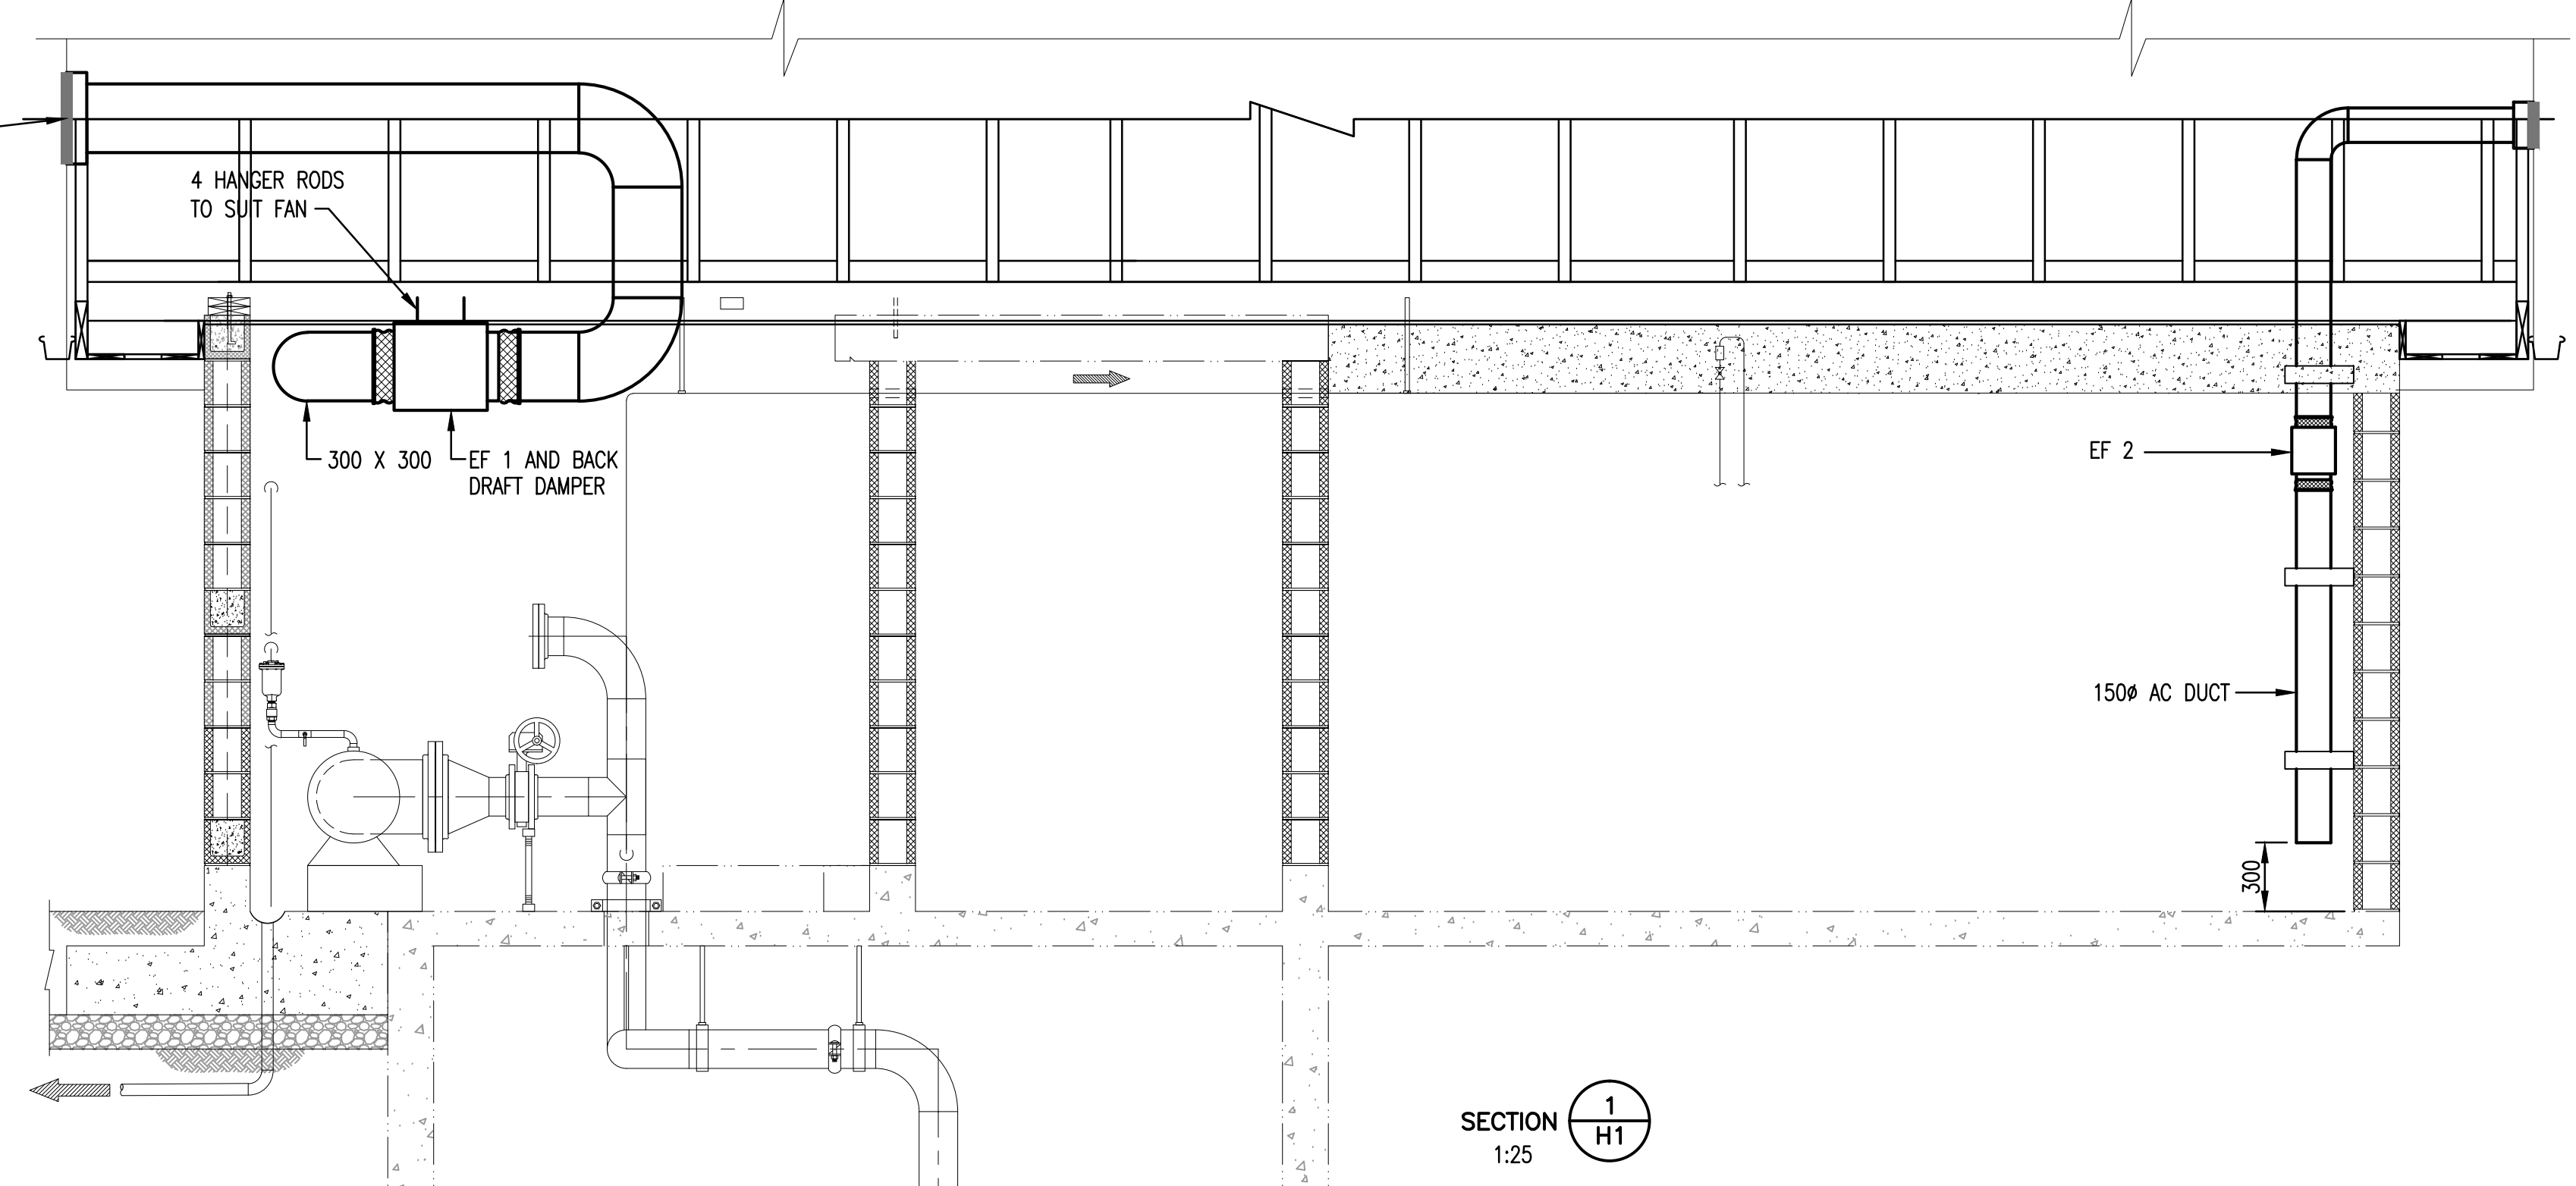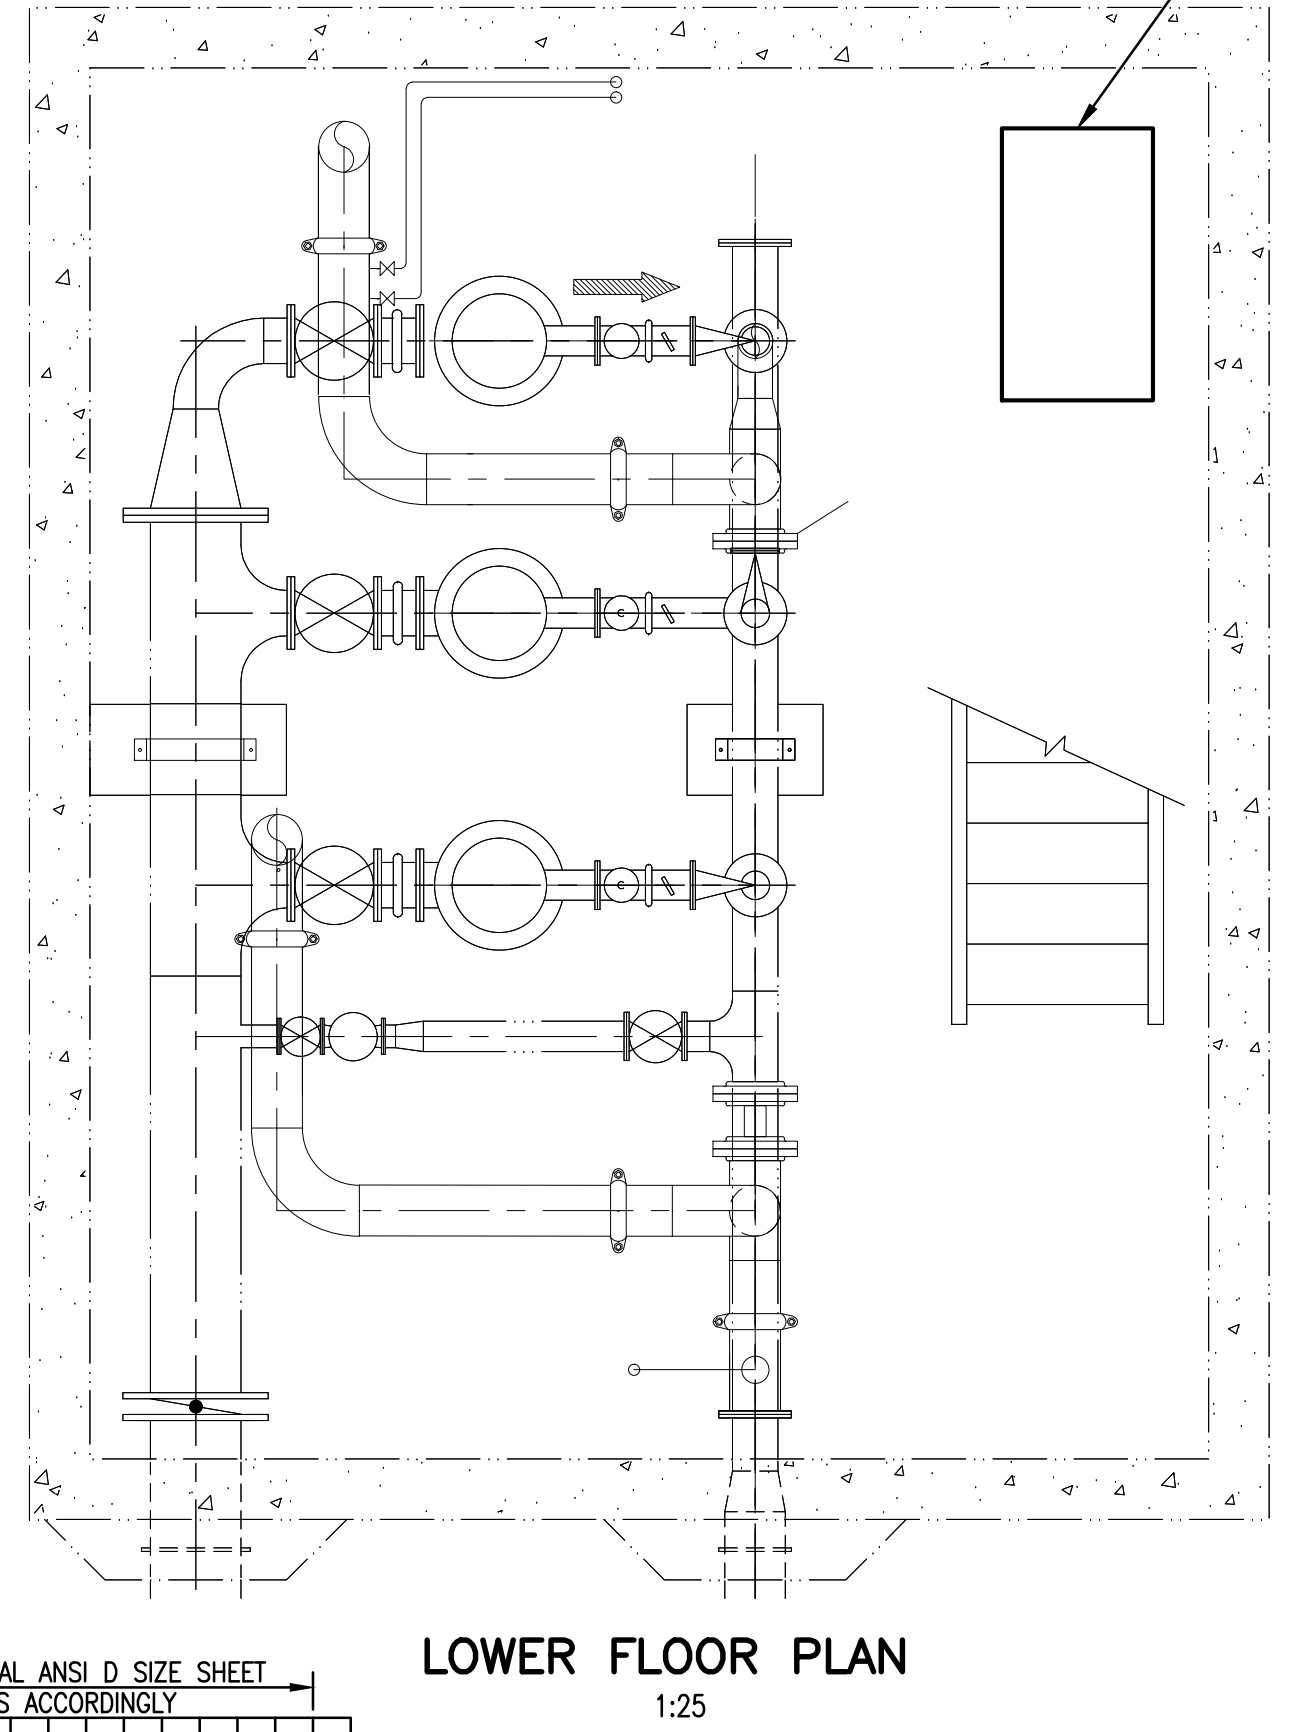

THIS DISTANCE = 100 ON ORIGINAL ANSI D SIZE SHEET
OTHERWISE ADJUST SCALES ACCORDINGLY

1:1 @ ANSI D
0 10 20 30 40 50 60 70 80 90 100 mm

ISSUE	DATE	DRAWN	CHK'D	APP'D	DESCRIPTION	ISSUE	DATE	DRAWN	CHK'D	APP'D	DESCRIPTION
A	JAN27/12	AIS	EP	EP	ISSUED FOR TENDER	D	APR25/12	RB	ZA	WB	ISSUED FOR CONSTRUCTION
B	FEB09/12	RB	EP	EP	ADDENDUM NO. 1 - AS SHOWN	E	MAY15/13	MMc	WB	WB	RECORD DRAWING
C	FEB16/12	RB	ZA	WB	ADDENDUM NO. 2 - AS SHOWN						

DESIGNED	EP
DRAWN	AIS/RB
CHECKED	EP

OPUS DAYTONKNIGHT
North Vancouver Office
604-990-4600

210-889 Harbourside Drive
North Vancouver BC
V7P 3S1, Canada




SUNSHINE COAST REGIONAL DISTRICT
GARDEN BAY UV BUILDING
HVAC - PLANS & SECTION

SCALE: AS SHOWN
DRAWING No. 28.206
SHEET No. H1 ISSUE E



FILE: G:\d&k CAD Drawings\DKSERVER P_Shore\Rectrags\SUNSHINE_COAST\28-206 HVAC\28-206 H1.dwg Tab: H1 13-06-07 vcsjz

600V RELOCATED SERVICE, O/H CONNECTION
600-347V, 3Ø, 60Hz

NOTE 1.

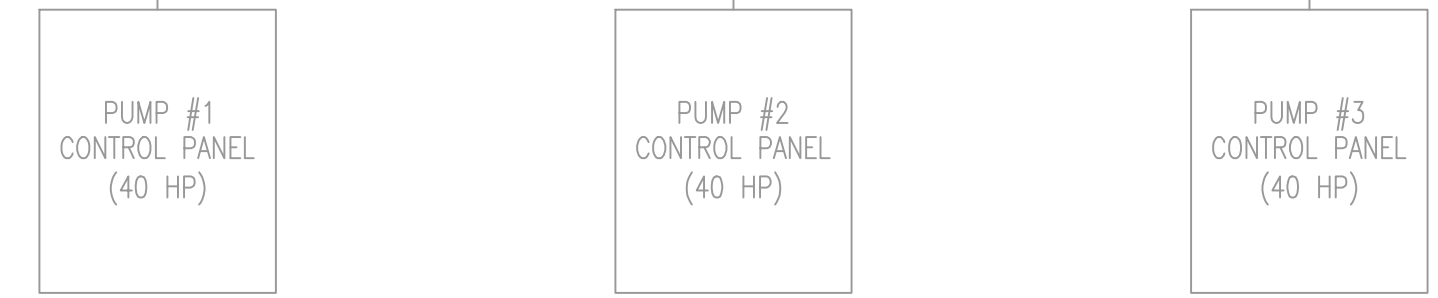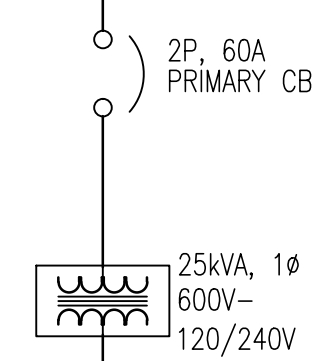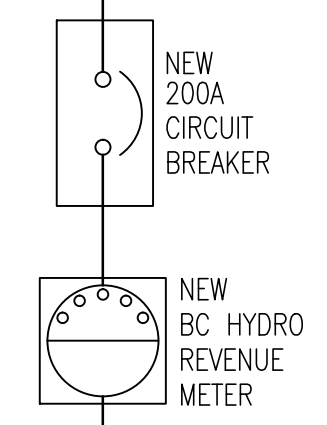

NOTE 2.

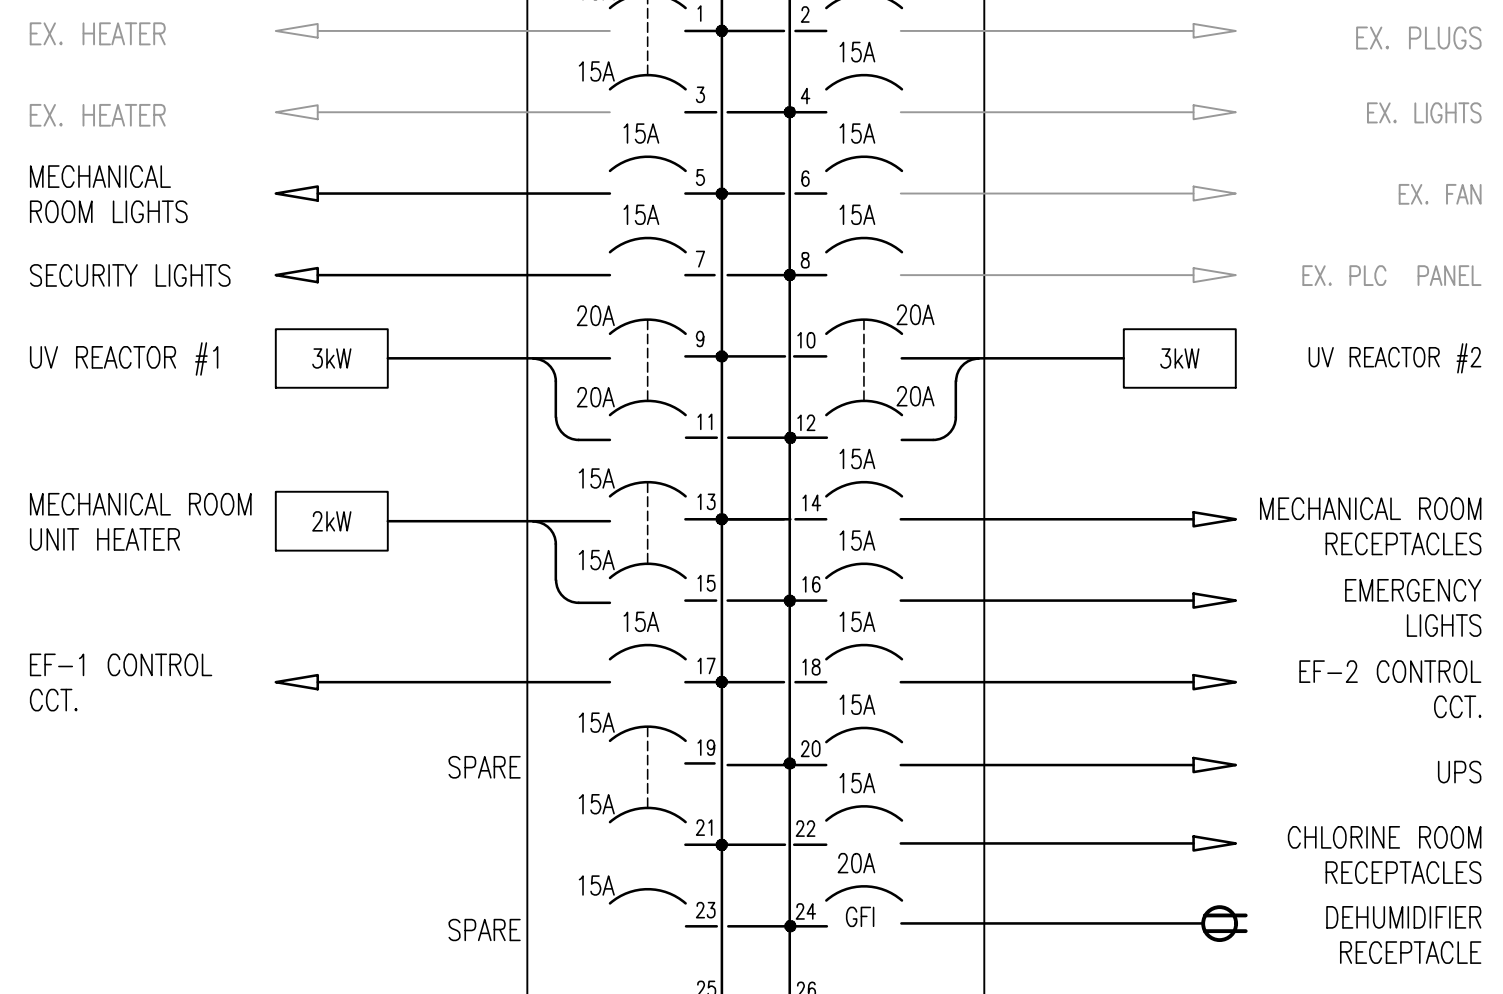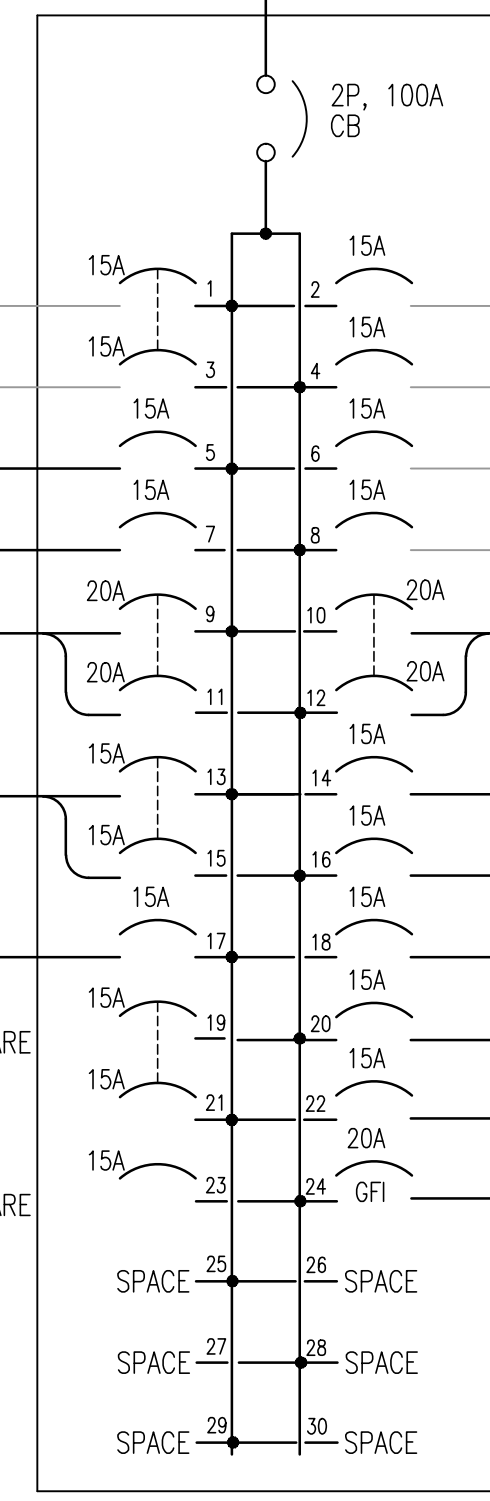


PANELBOARD LOAD	
ITEM	LOAD [kVA]
EXISTING BASEBOARD HEATER	3.0
EXISTING PLUGS	0.5
EXISTING LIGHTS	0.4
EXISTING FAN	0.1
EXISTING PLC PANEL	0.5
MECHANICAL ROOM LIGHTS	0.2
UV REACTOR #1	3.3
UV REACTOR #2	3.3
MECHANICAL ROOM UH	2.0
MECHANICAL ROOM RECEPTACLES	0.5
EMERGENCY LIGHTS	0.1
FAN EF-1	0.1
FAN EF-2	0.1
UPS INSTRUMENTATION POWER	1.0
CHLORINE ROOM RECEPTACLES	0.5
DEHUMIDIFIER	1.5
TOTAL	17.10


SINGLE LINE DIAGRAM

- NOTES:
- INSTALL A NEW SERVICE MAST IN PLACE OF THE EXISTING AS REQUIRED BY BC HYDRO. CO-ORDINATE THE WORK WITH BC HYDRO AND INSTALL A NEW 200A MAINSWITCH AT THE MOST CONVENIENT TIME TO MINIMIZE SERVICE INTERRUPTION. DECOMMISSION THE EXISTING UTILITY METERING EQUIPMENT AND PROVIDE NEW 600V METERBASE ON THE OUTSIDE ENVELOPE OF THE BUILDING. (BY OTHERS)
 - REPLACE THE EXISTING LIGHTING PANEL WITH A NEW DISTRIBUTION PANELBOARD, REWIRE THE EXISTING CIRCUITS AND ADD NEW CIRCUITS AS REQUIRED. PROVIDE A NEW DISTRIBUTION TRANSFORMER AND TRANSFORMER PRIMARY CIRCUIT BREAKER.


" This Record Drawing has been prepared by Opus DaytonKnight ("Opus DK") for the exclusive use of "Sunshine Coast Regional District" (the "Client"). Any use which a third party makes of this drawing, or any reliance or decisions or actions taken by any such third party based upon this drawing, are the sole responsibility of any such third party and Opus DK accepts no responsibility, liability or risk for any damages, loss, or claims, if any, suffered by any such third party or any related party of such third party as a result of any reliance, or decisions made or actions taken, based upon this drawing. It is the user's sole responsibility to check the accuracy of this digital drawing."

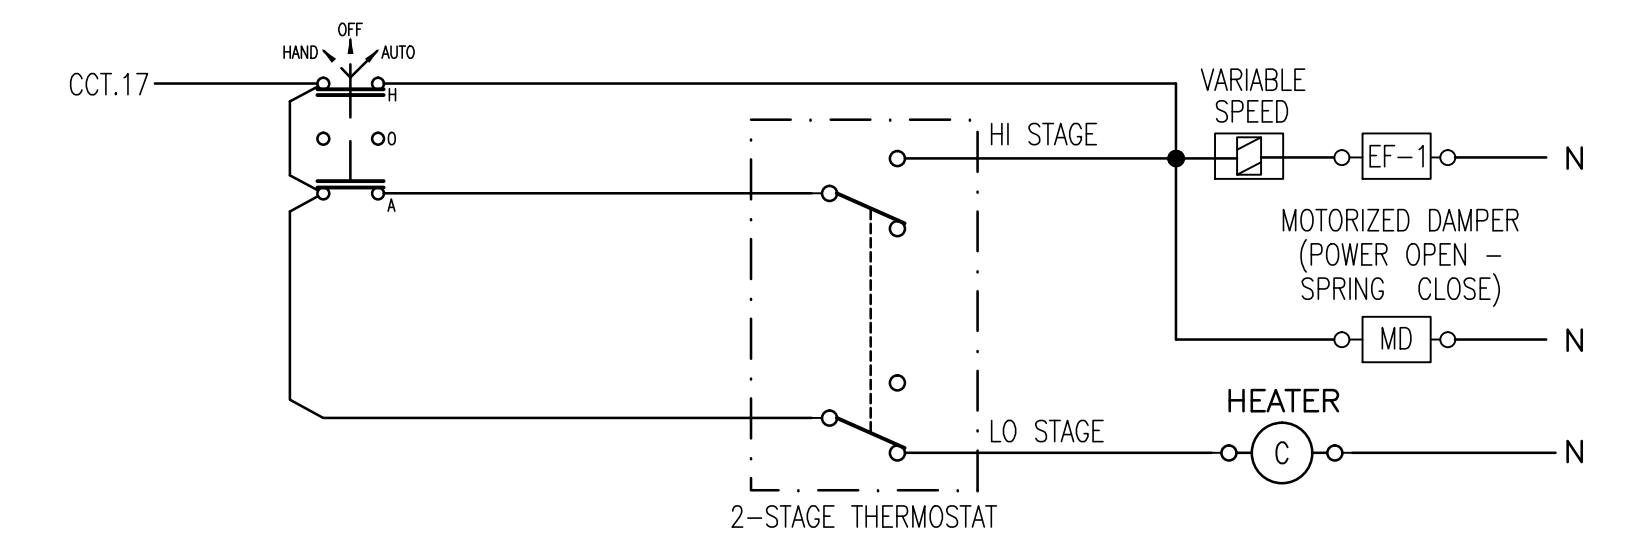


PUMP ROOM & ELECTRICAL ROOM FAN/HEATER CONTROL

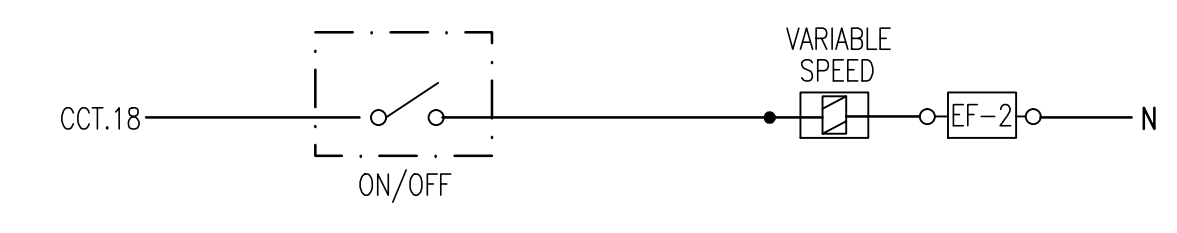


EF-2 FAN CONTROL

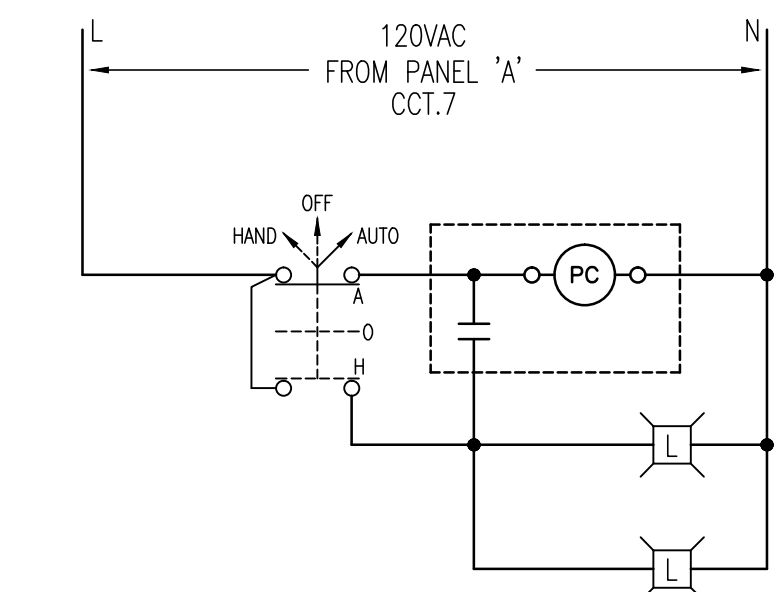


OUTSIDE LIGHTS CONTROL

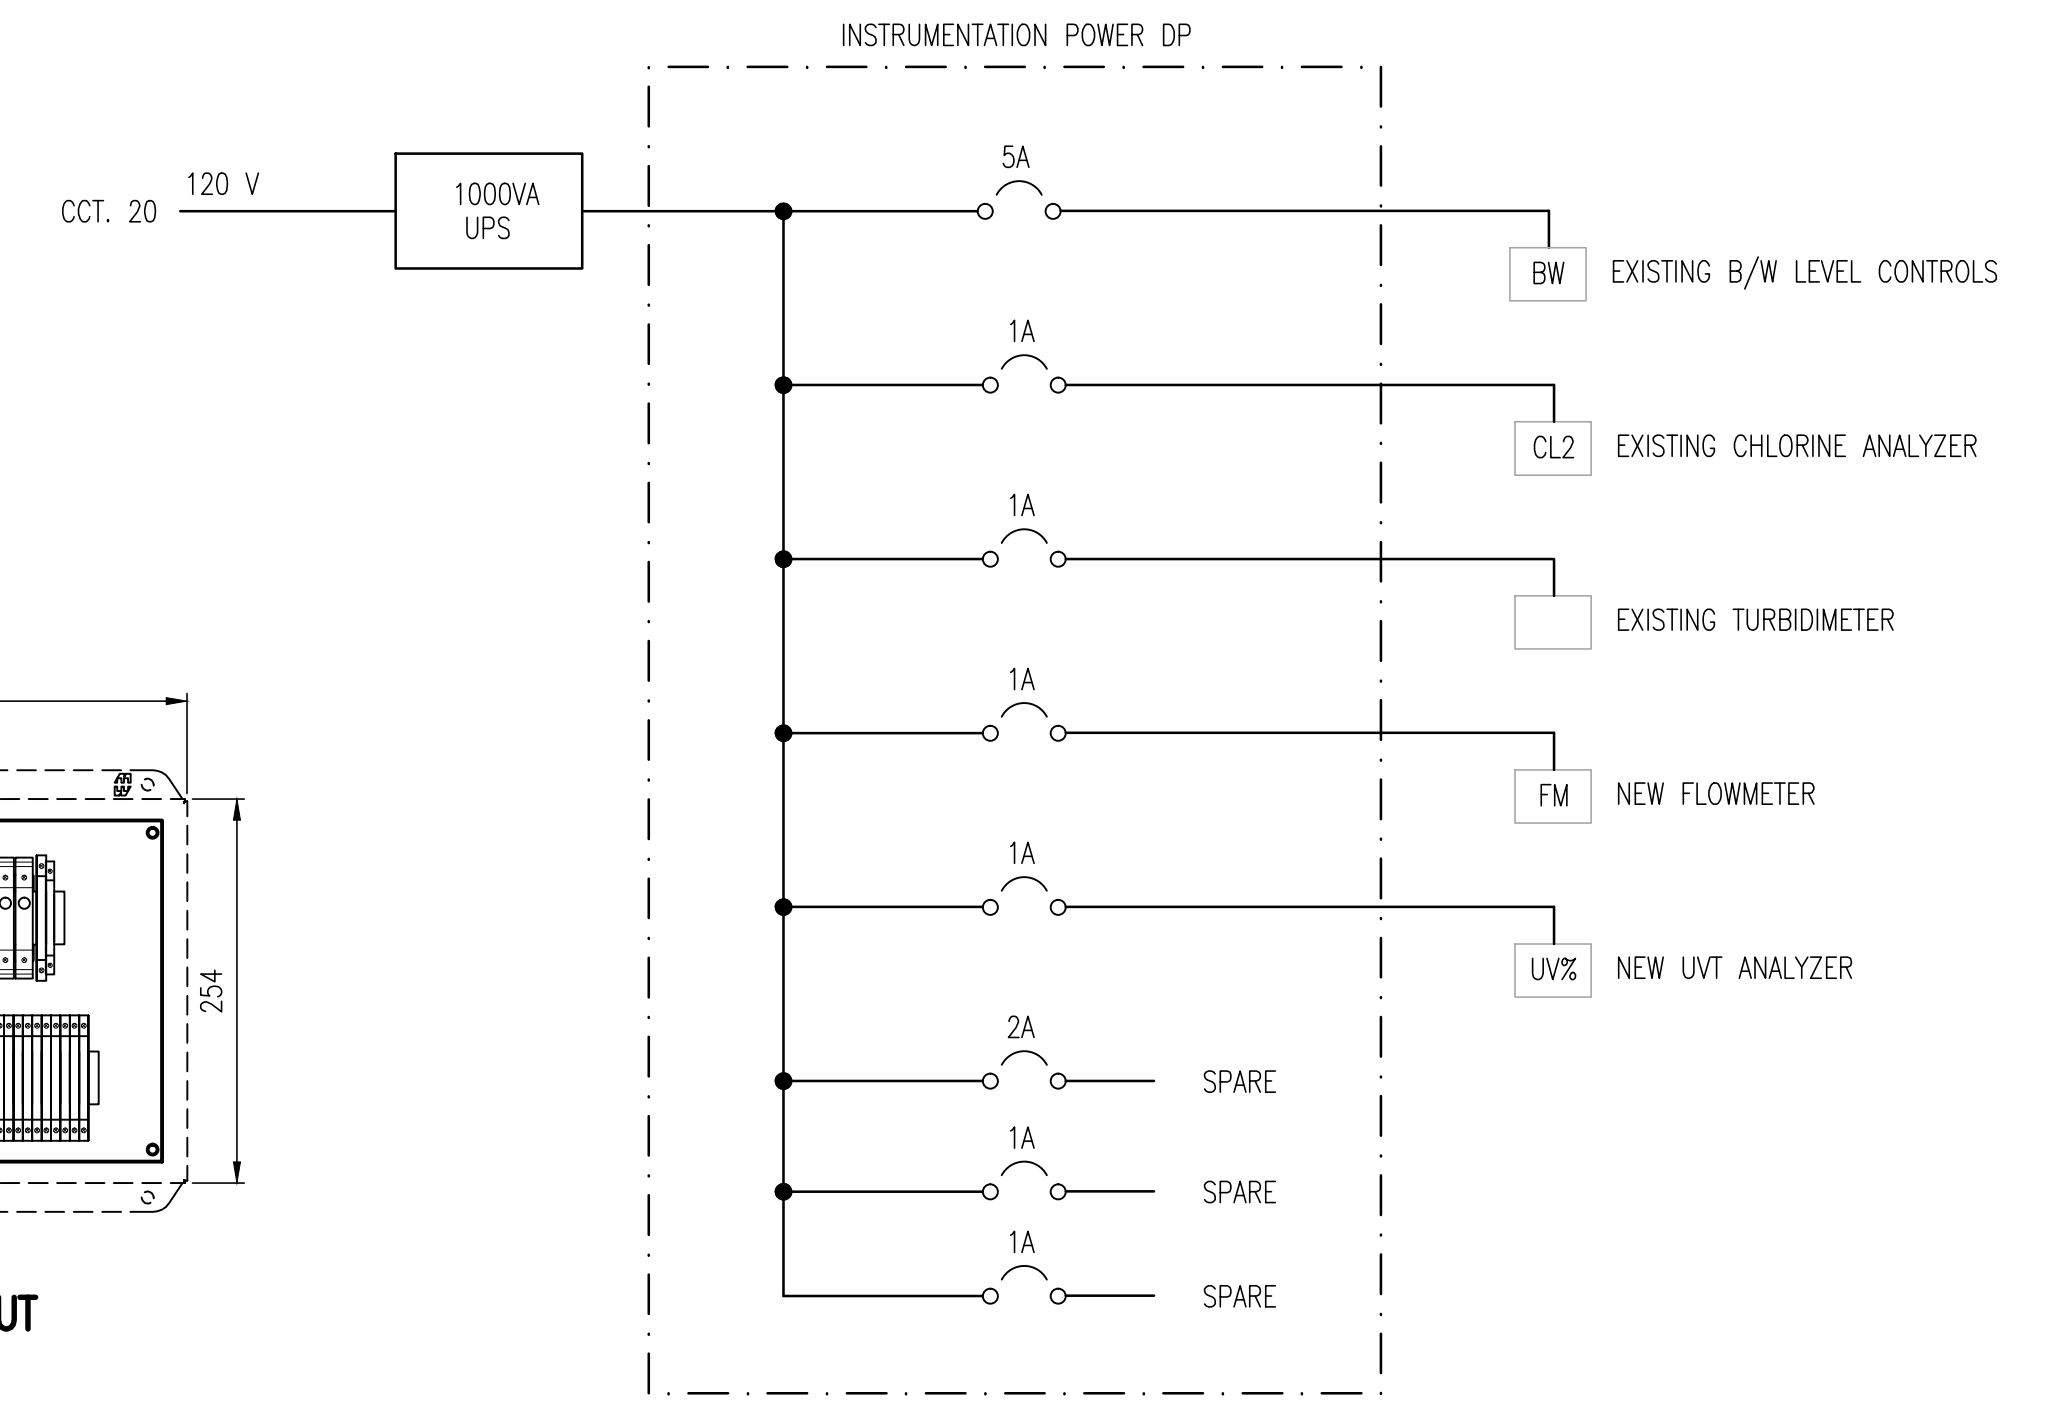

INSTRUMENTATION POWER DP

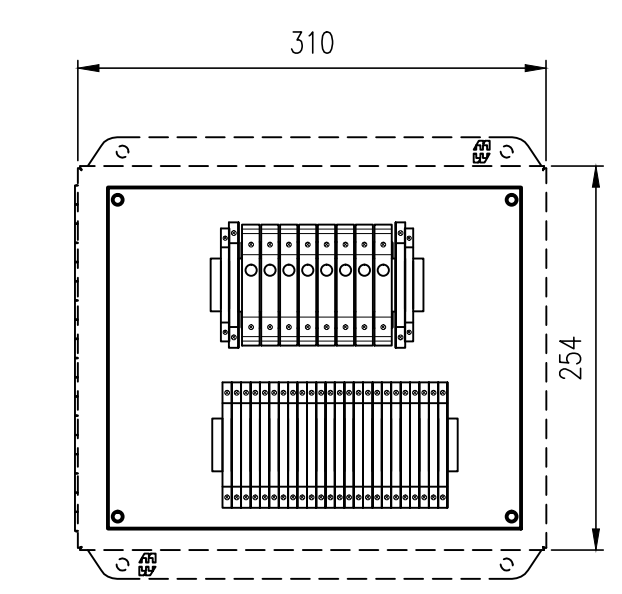

1:5 LAYOUT

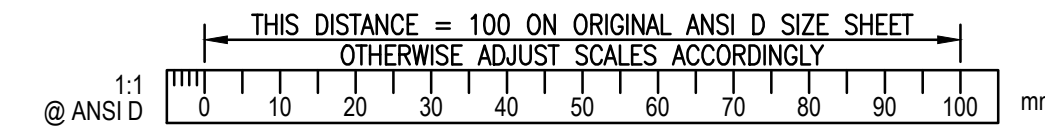



REVISIONS	ISSUE	DATE	DRAWN	CHK'D	APP'D	DESCRIPTION	ISSUE	DATE	DRAWN	CHK'D	APP'D	DESCRIPTION
A	JAN27/12	GV	TT	TT		ISSUED FOR TENDER	D	APR25/12	GV	ZA	GV	ISSUED FOR CONSTRUCTION
B	FEB16/12		ZA	GV		ADDENDUM NO.2-AS SHOWN	E	MAY08/13	RB	GV	WB	RECORD DRAWING
C						MODIFIED - AS SHOWN						

OPUS DAYTONKNIGHT
North Vancouver Office
604-990-4800
210-889 Harbourside Drive
North Vancouver BC
V7P 3S1, Canada


SUNSHINE COAST REGIONAL DISTRICT
GARDEN BAY UV BUILDING
ELECTRICAL - SINGLE LINE DIAGRAM & MISCELLANEOUS DETAILS

SCALE: AS SHOWN
DRAWING No. 028.206
SHEET No. E1 ISSUE E

FILE: G:\d&k CAD Drawings\DKSERVER P Store\Records\SUNSHINE COAST\28-206\ELECTRICAL\28-206-E1.dwg Tab: E1 1:3-06-07 vcajz0

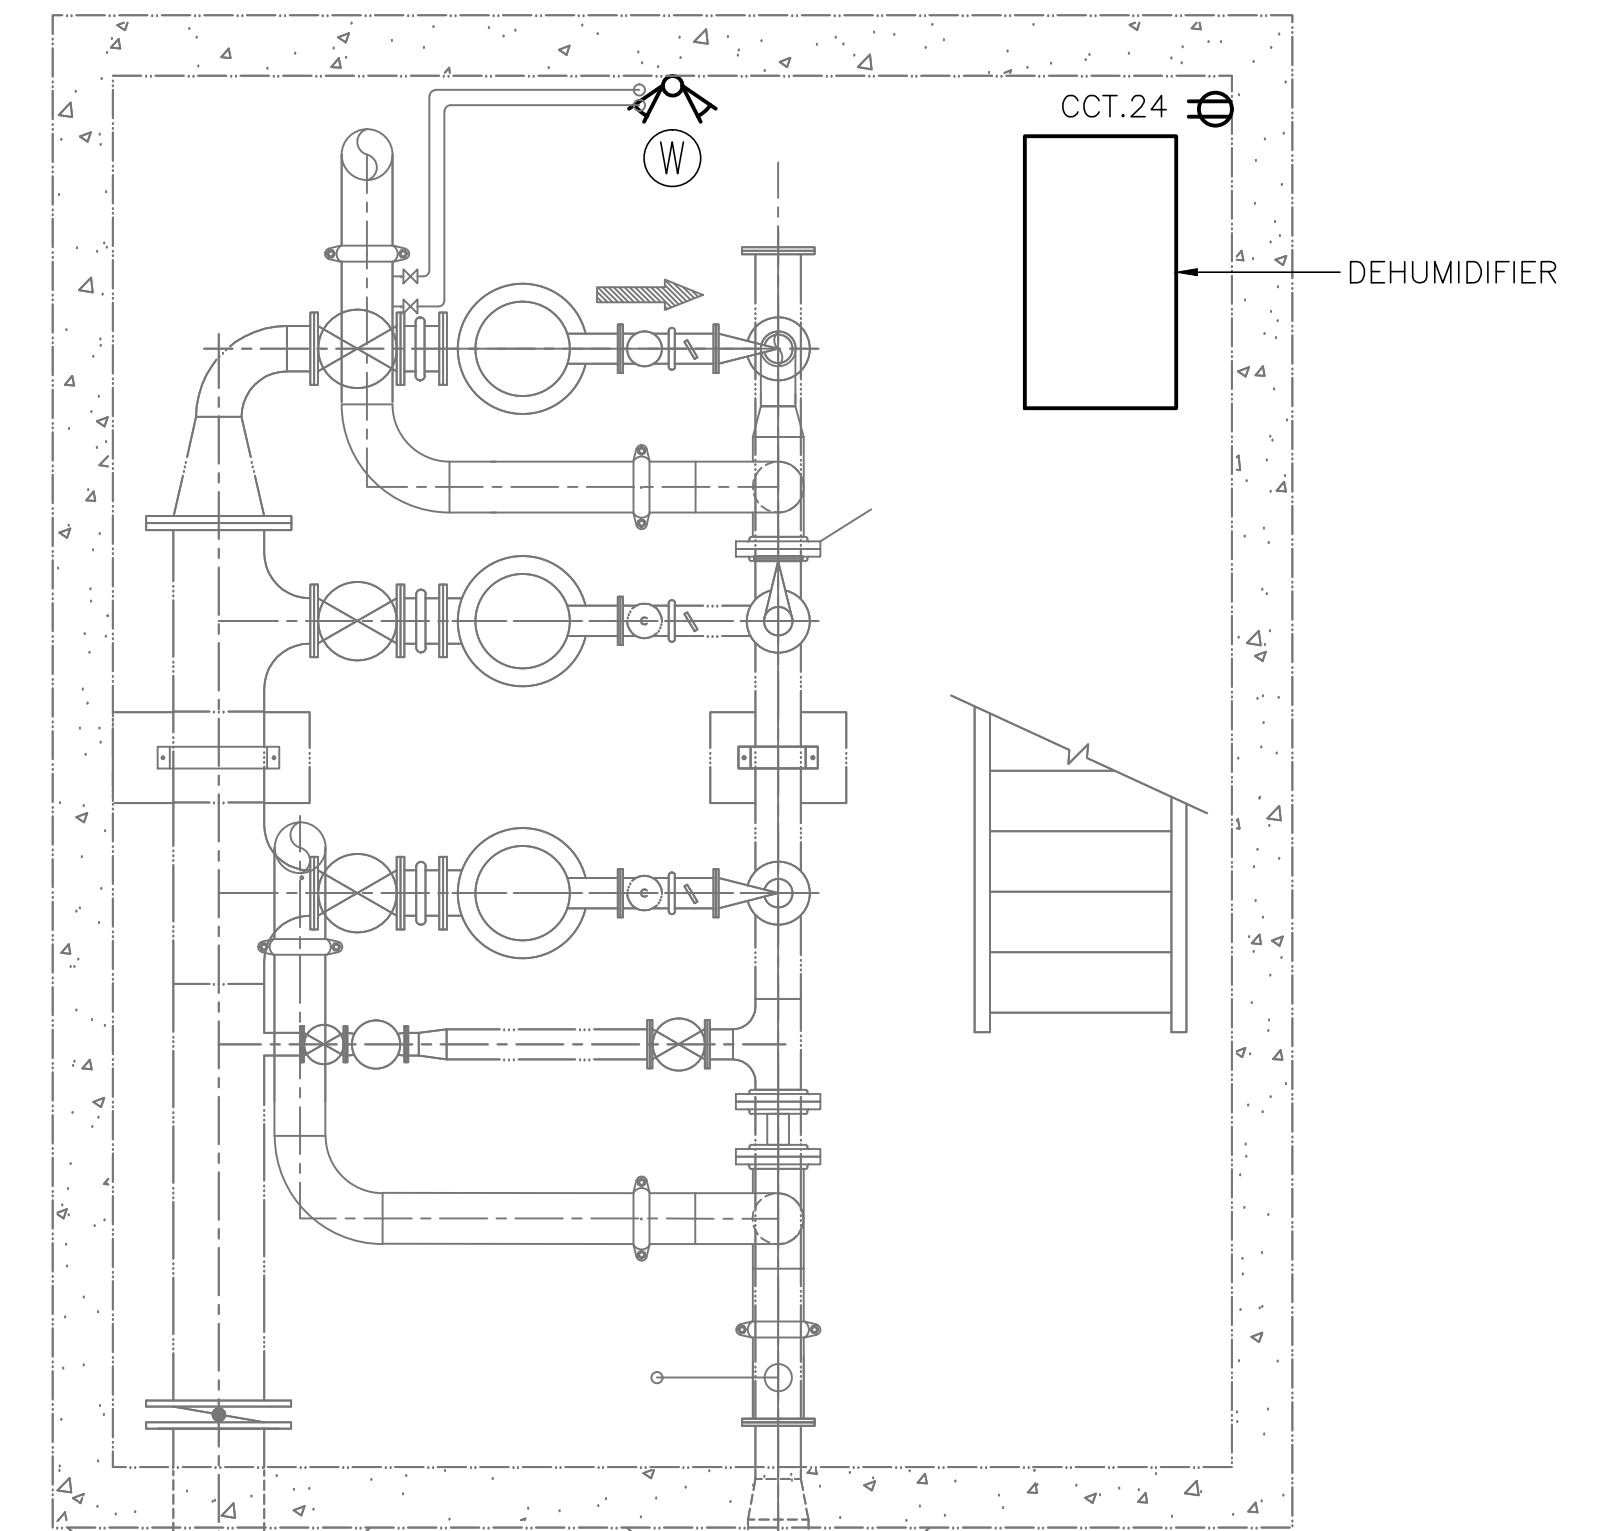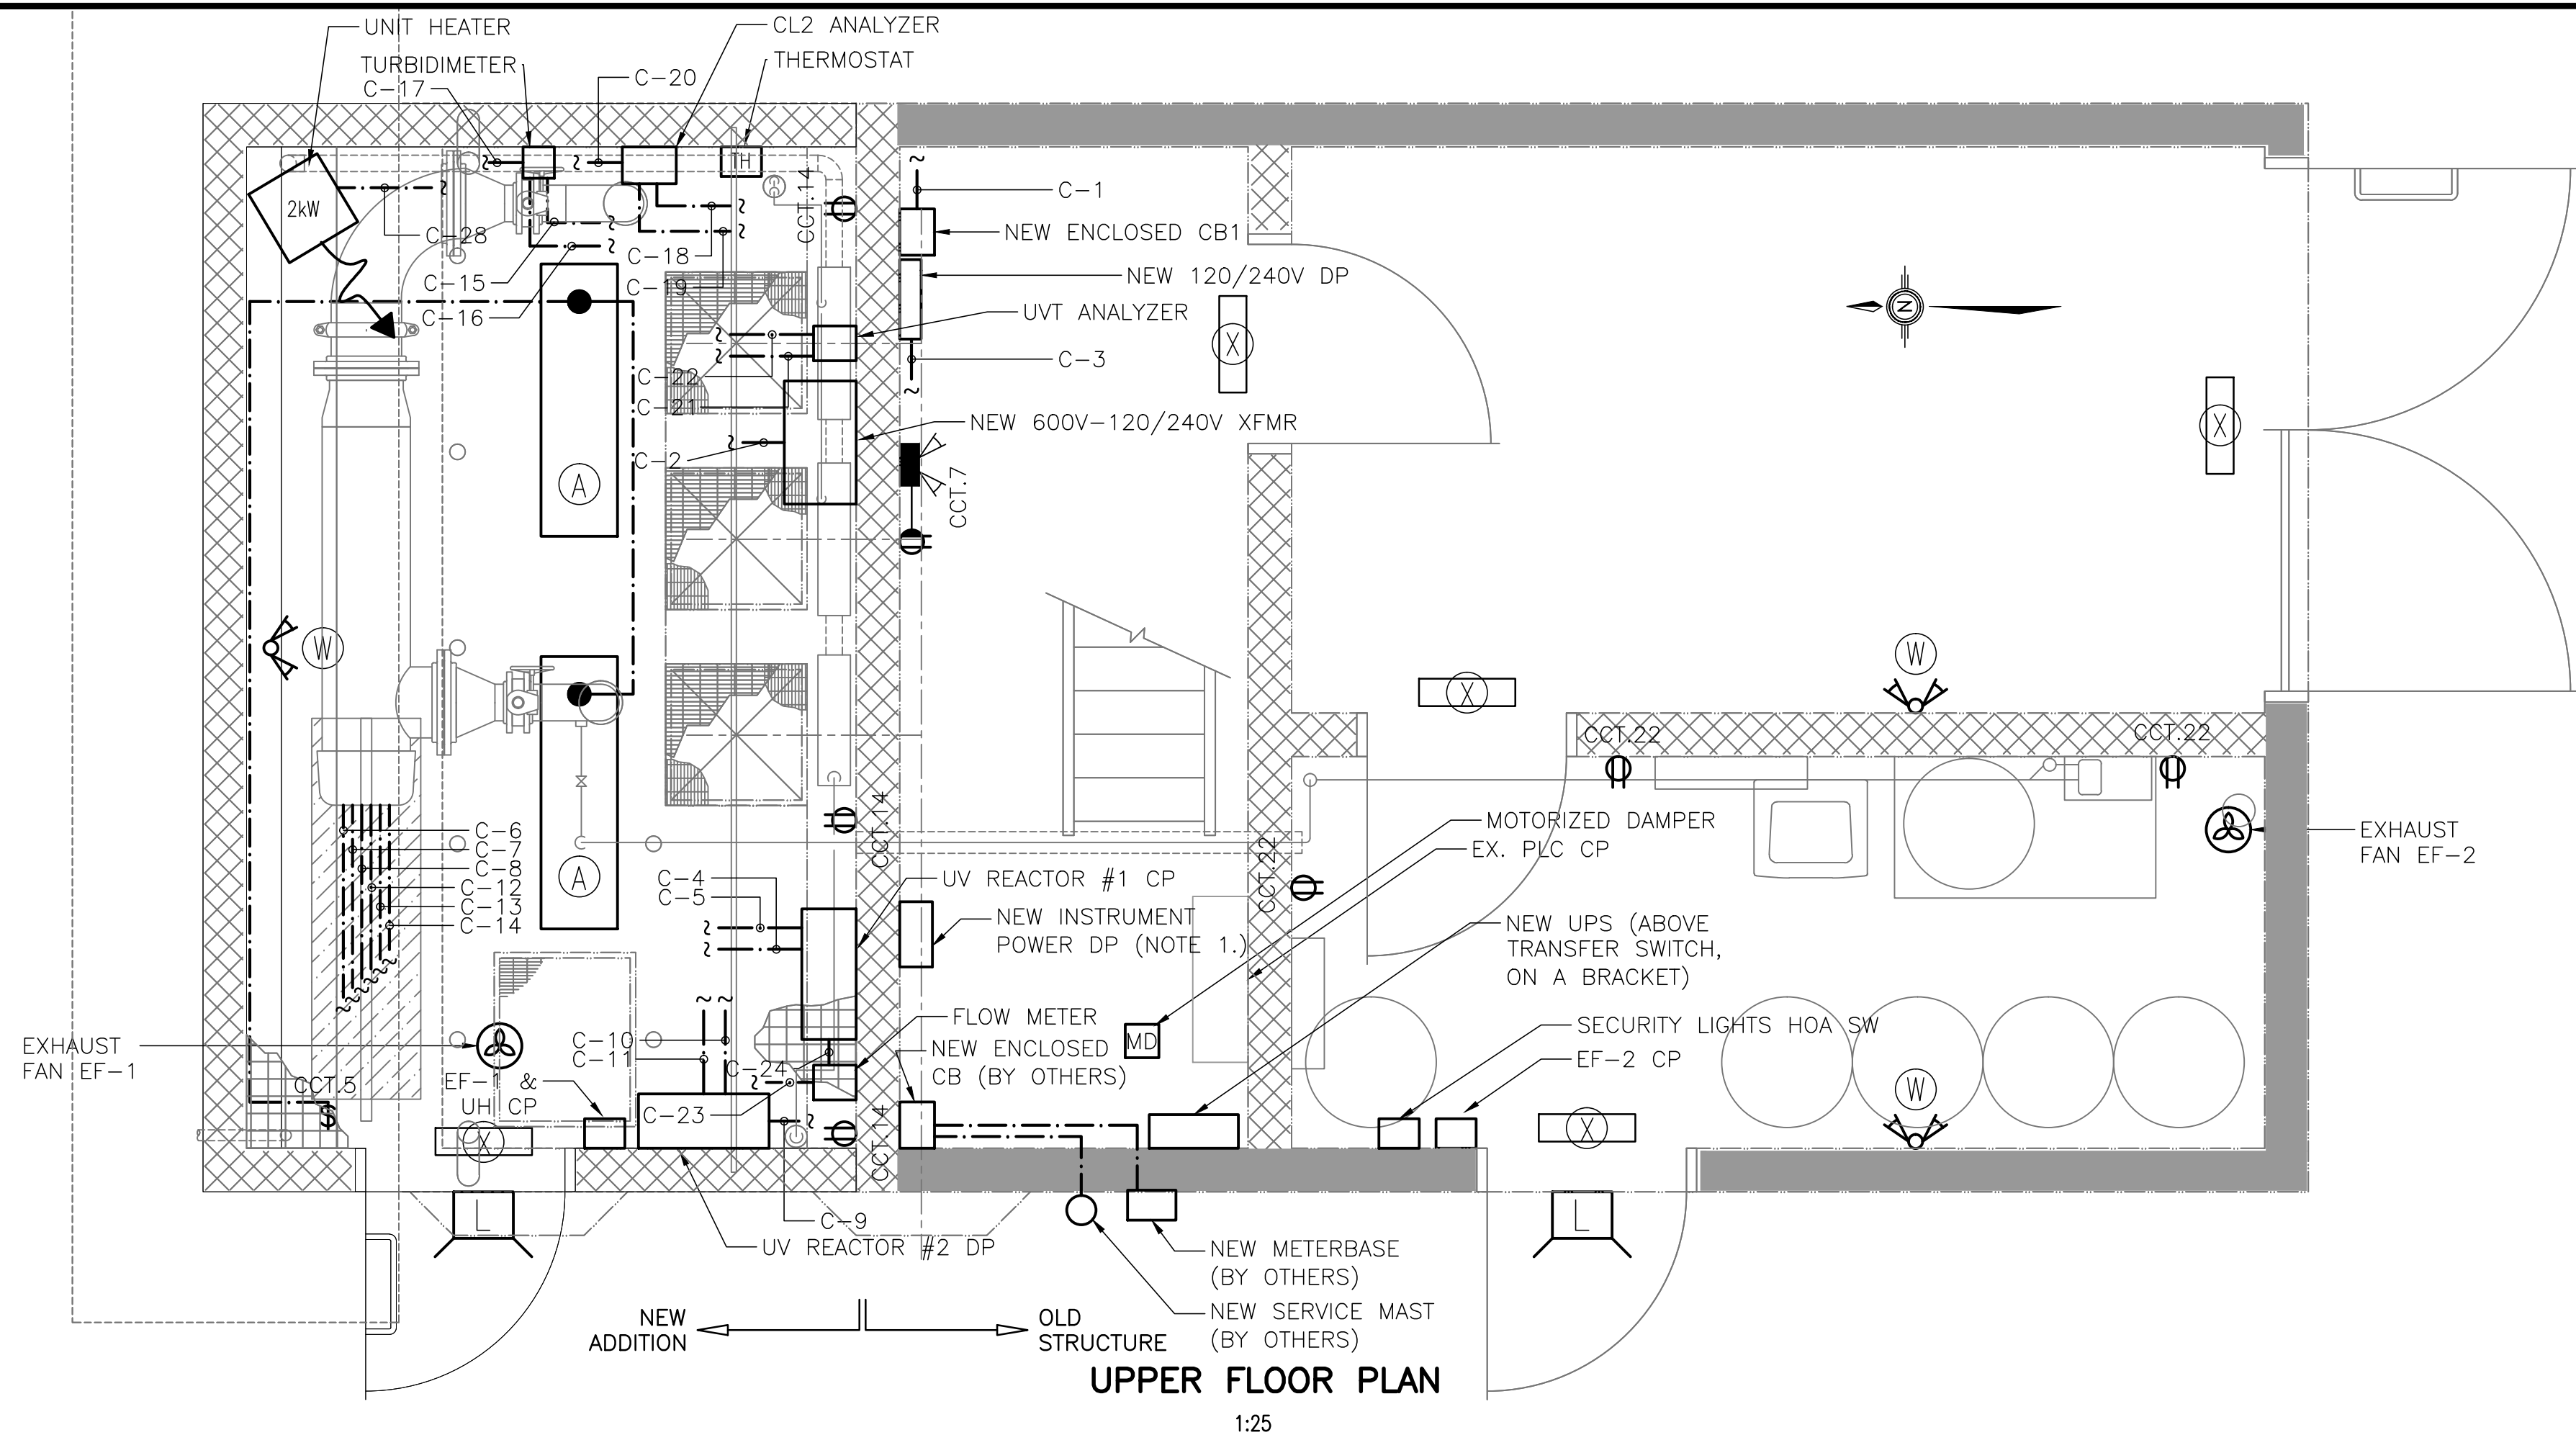

LOWER FLOOR PLAN
1:25

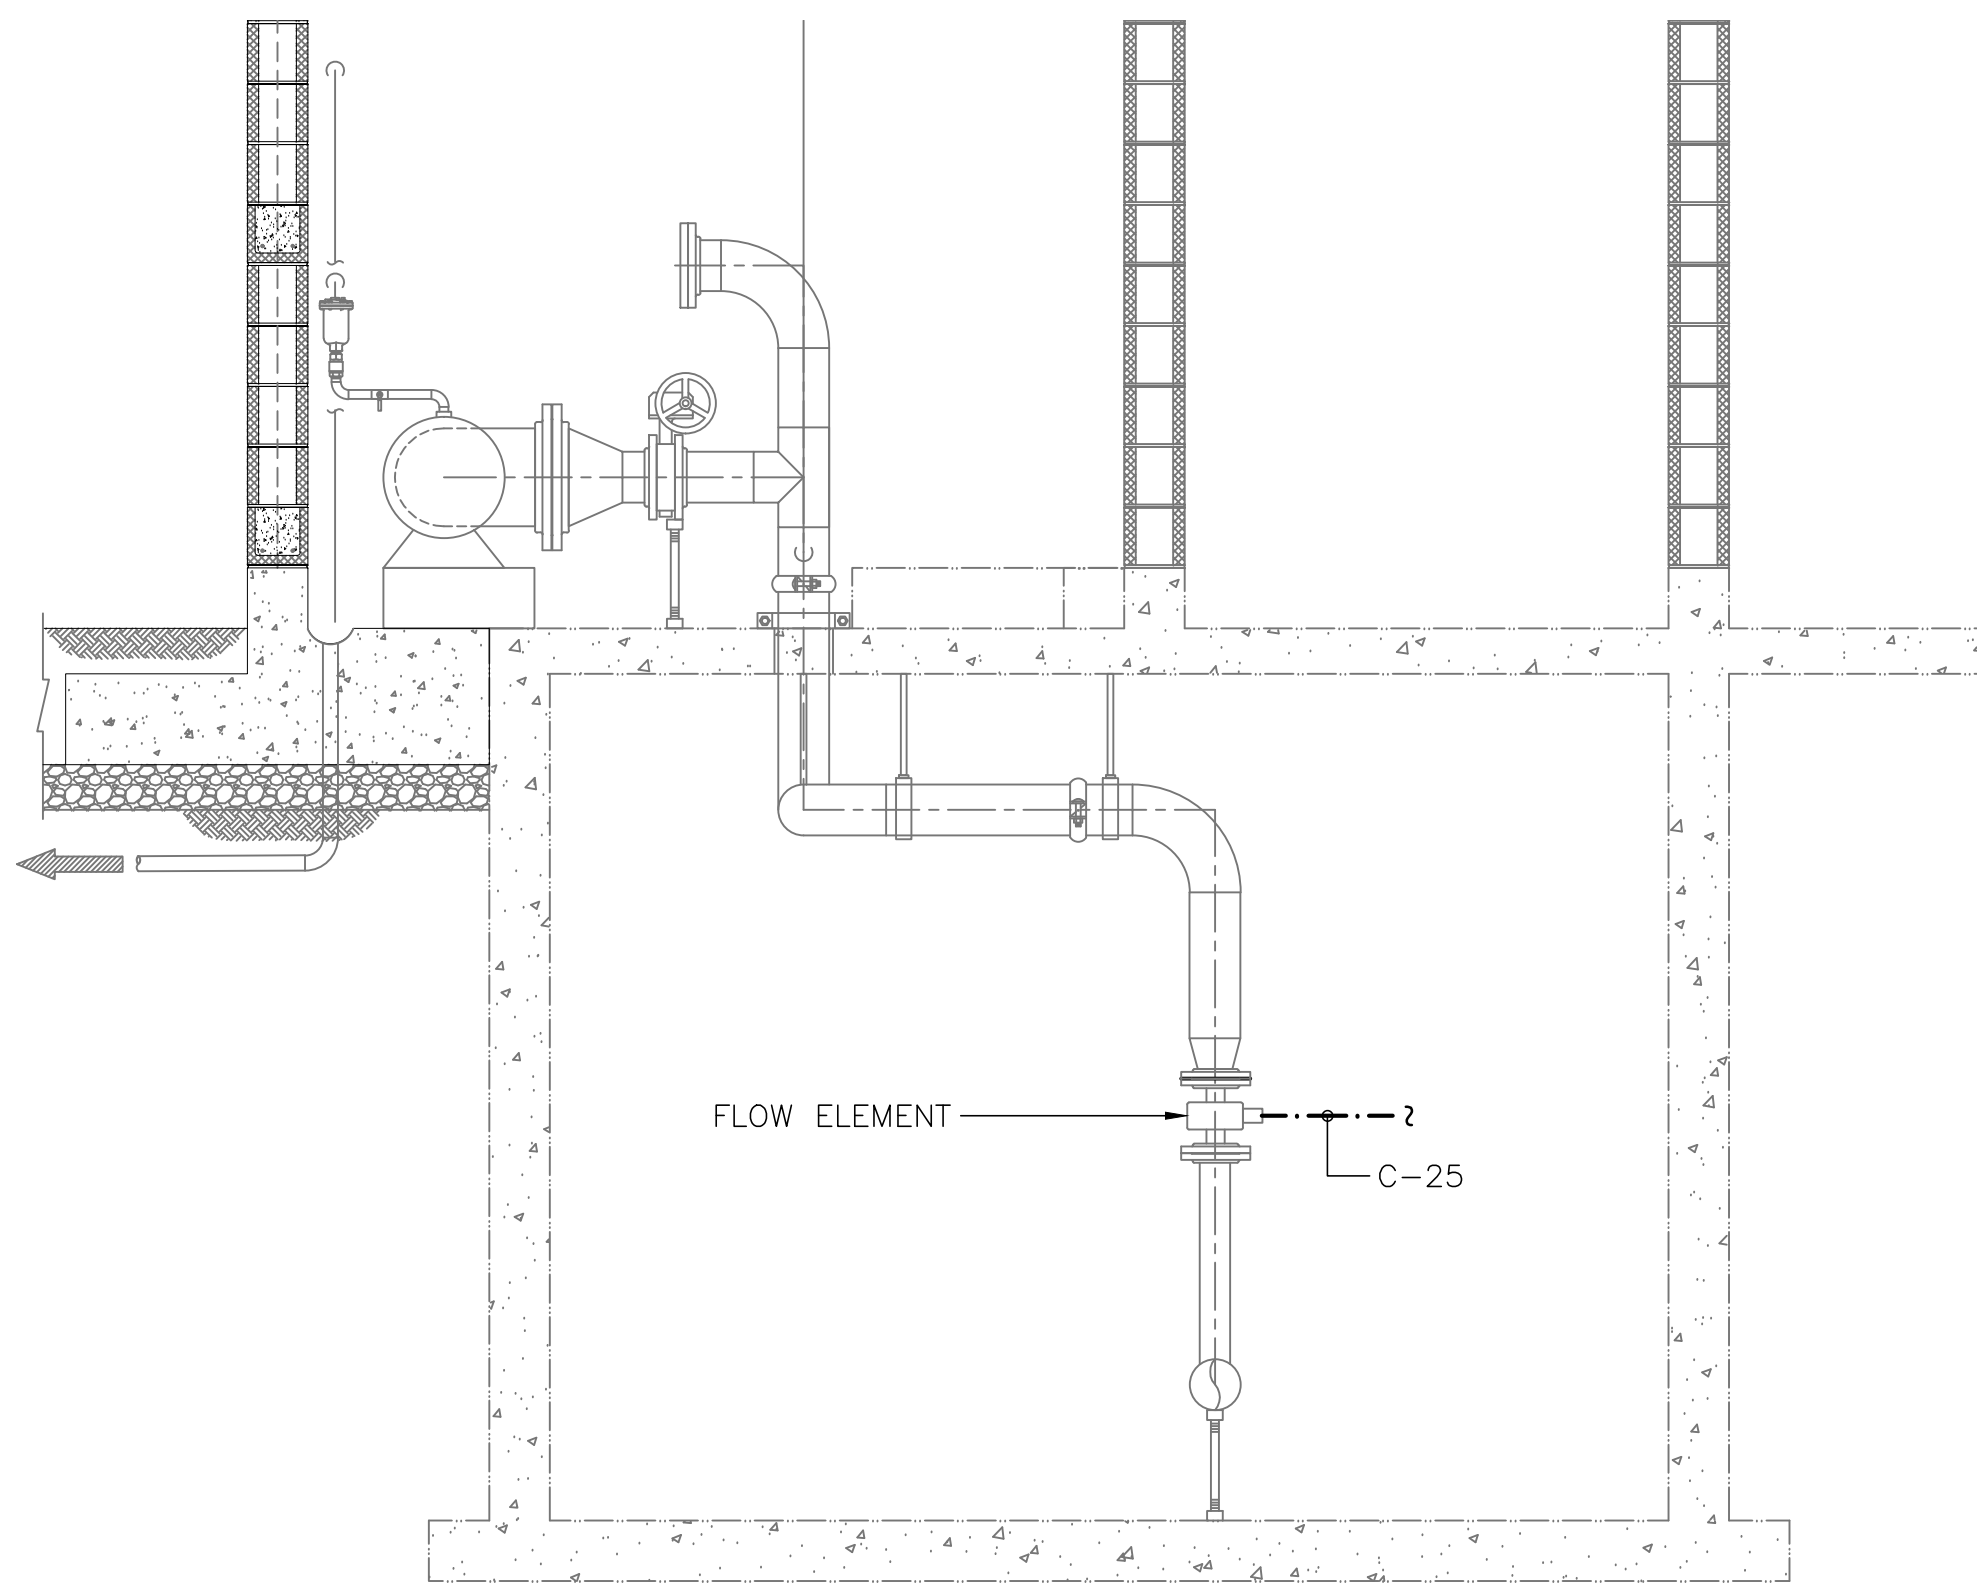


LOWER LEVEL SECTION - DETAIL
1:25

NOTES:
1. INSTALL A NEW SERVICE MAST IN PLACE OF THE EXISTING AS REQUIRED BY BC HYDRO. CO-ORDINATE THE WORK WITH BC HYDRO AND INSTALL A NEW 200A MAINSWITCH AT THE MOST CONVENIENT TIME TO MINIMIZE SERVICE INTERRUPTION. DECOMMISSION THE EXISTING UTILITY METERING EQUIPMENT AND PROVIDE NEW 600V METERBASE ON THE OUTSIDE ENVELOPE OF THE BUILDING. (BY OTHERS)

" This Record Drawing has been prepared by Opus DaytonKnight ("Opus DK") for the exclusive use of "Sunshine Coast Regional District" (the "Client"). Any use which a third party makes of this drawing, or any reliance or decisions or actions taken by any such third party based upon this drawing, are the sole responsibility of any such third party and Opus DK accepts no responsibility, liability or risk for any damages, loss, or claims, if any, suffered by any such third party or any related party of such third party as a result of any reliance, or decisions made or actions taken, based upon this drawing. It is the user's sole responsibility to check the accuracy of this digital drawing."

CABLE SCHEDULE			
NUMBER	RACEWAY & CONDUCTORS	FROM	TO
C-1	53C-2#4+BOND	600V SPLITTER	ENCLOSED CIRCUIT BREAKER CB1
C-2	53C-2#4+BOND	ENCLOSED CIRCUIT BREAKER CB1	DISTRIBUTION TRANSFORMER PRIMARY
C-3	53C-3#0+BOND	DISTRIBUTION TRANSFORMER SECONDARY	DISTRIBUTION PANEL
C-4	27C-3#10+BOND	DISTRIBUTION PANEL	UV REACTOR #1 CP
C-5	53C-5BELDEN#8760+BELDEN#9136A	MAIN PLC CP	UV REACTOR #1 CP
C-6	35C-MFR.CABLE	UV REACTOR #1 CP	UV REACTOR #1 LAMPS ASSEMBLY (LAMPS 1-6)
C-7	35C-MFR.CABLE	UV REACTOR #1 CP	UV REACTOR #1 LAMPS ASSEMBLY (LAMPS 7-12)
C-8	21C-MFR.CABLE	UV REACTOR #1 CP	UV REACTOR #1 LAMPS ASSEMBLY (SENSORS)
C-9	27C-PULLCORD (FOR FUTURE BELDEN#9136A)	UV REACTOR #1 CP	UV REACTOR #2 CP
C-10	27C-PULLCORD (FUTURE 3#10+BOND)	DISTRIBUTION PANEL	UV REACTOR #2 CP
C-11	27C-PULLCORD (FUTURE 10#14)	MAIN PLC CP	UV REACTOR #2 CP
C-12	35C-PULLCORD (FUTURE MFR.CABLE)	UV REACTOR #2 CP	UV REACTOR #2 LAMPS ASSEMBLY (LAMPS 1-6)
C-13	35C-PULLCORD (FUTURE MFR.CABLE)	UV REACTOR #2 CP	UV REACTOR #2 LAMPS ASSEMBLY (LAMPS 7-12)
C-14	21C-PULLCORD (FUTURE MFR.CABLE)	UV REACTOR #2 CP	UV REACTOR #2 LAMPS ASSEMBLY (SENSORS)
C-15	27C-2#14+BOND	INSTRUMENTATION POWER DP	TURBIDIMETER CONTROLLER HACH SC100
C-16	27C-BELDEN#8760	MAIN PLC CP	TURBIDIMETER CONTROLLER HACH SC100
C-17	27C-MFR.CABLE	HACH SC100 CONTROLLER	1720E TURBIDIMETER
C-18	27C-2#14+BOND	INSTRUMENTATION POWER DP	CHLORINE ANALYZER MICROCHEM 2
C-19	27C-BELDEN#8760	MAIN PLC CP	CHLORINE ANALYZER MICROCHEM 2
C-20	27C-MFR.CABLE	CHLORINE ANALYZER MICROCHEM 2	CL ₂ PROBE
C-21	27C-2#14+BOND	INSTRUMENTATION POWER DP	UVT ANALYZER
C-22	27C-BELDEN#8760	MAIN PLC CP	UVT ANALYZER
C-23	27C-2#14+BOND	INSTRUMENTATION POWER DP	FLOW METER (TRANSMITTER)
C-24	27C-BELDEN#8760	MAIN PLC CP	FLOW METER (TRANSMITTER)
C-25	27C-MFR. CABLE	FLOW METER (TRANSMITTER)	FLOW ELEMENT
C-26	27C-BELDEN#9369	MAIN PLC CP	UV REACTOR #1 CP (UVT, FLOW, SPARE)
C-27	27C-BELDEN#9369	MAIN PLC CP	UV REACTOR #2 CP (UVT, FLOW, SPARE)
C-28	27C-2#12+BOND	DISTRIBUTION PANEL	UNIT HEATER IN UV ROOM

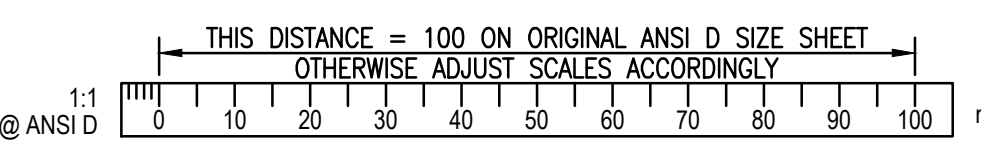


FILE: G:\DK CAD Drawings\KOSERVER P Share\Records\SUNSHINE COAST\28-206\ELECTRICAL\28-206-EZ.dwg, Tab: E2, 13-06-07 vsj:so

ISSUE	DATE	DRAWN	CHK'D	APP'D	DESCRIPTION	ISSUE	DATE	DRAWN	CHK'D	APP'D	DESCRIPTION	DESIGNED	DRAWN	CHECKED	SCALE: 1:25
A	JAN27/12	GV	TT	TT	ISSUED FOR TENDER	D	MAY08/13	RB	GV	WB	RECORD DRAWING	GV	GV/RB	IT	DRAWING No. 028.206
B	FEB16/12	RB	ZA	GV	ADDENDUM NO. 2 - AS SHOWN										SHEET No. E2
C	APR25/12	RB	ZA	GV	ISSUED FOR CONSTRUCTION										ISSUE D

OPUS DAYTONKNIGHT
North Vancouver Office
604-990-4800
210-889 Harbourside Drive
North Vancouver BC
V7P 3S1, Canada


SUNSHINE COAST REGIONAL DISTRICT
GARDEN BAY UV BUILDING
ELECTRICAL - LIGHTING, UTILITY, POWER AND CONTROL LAYOUT

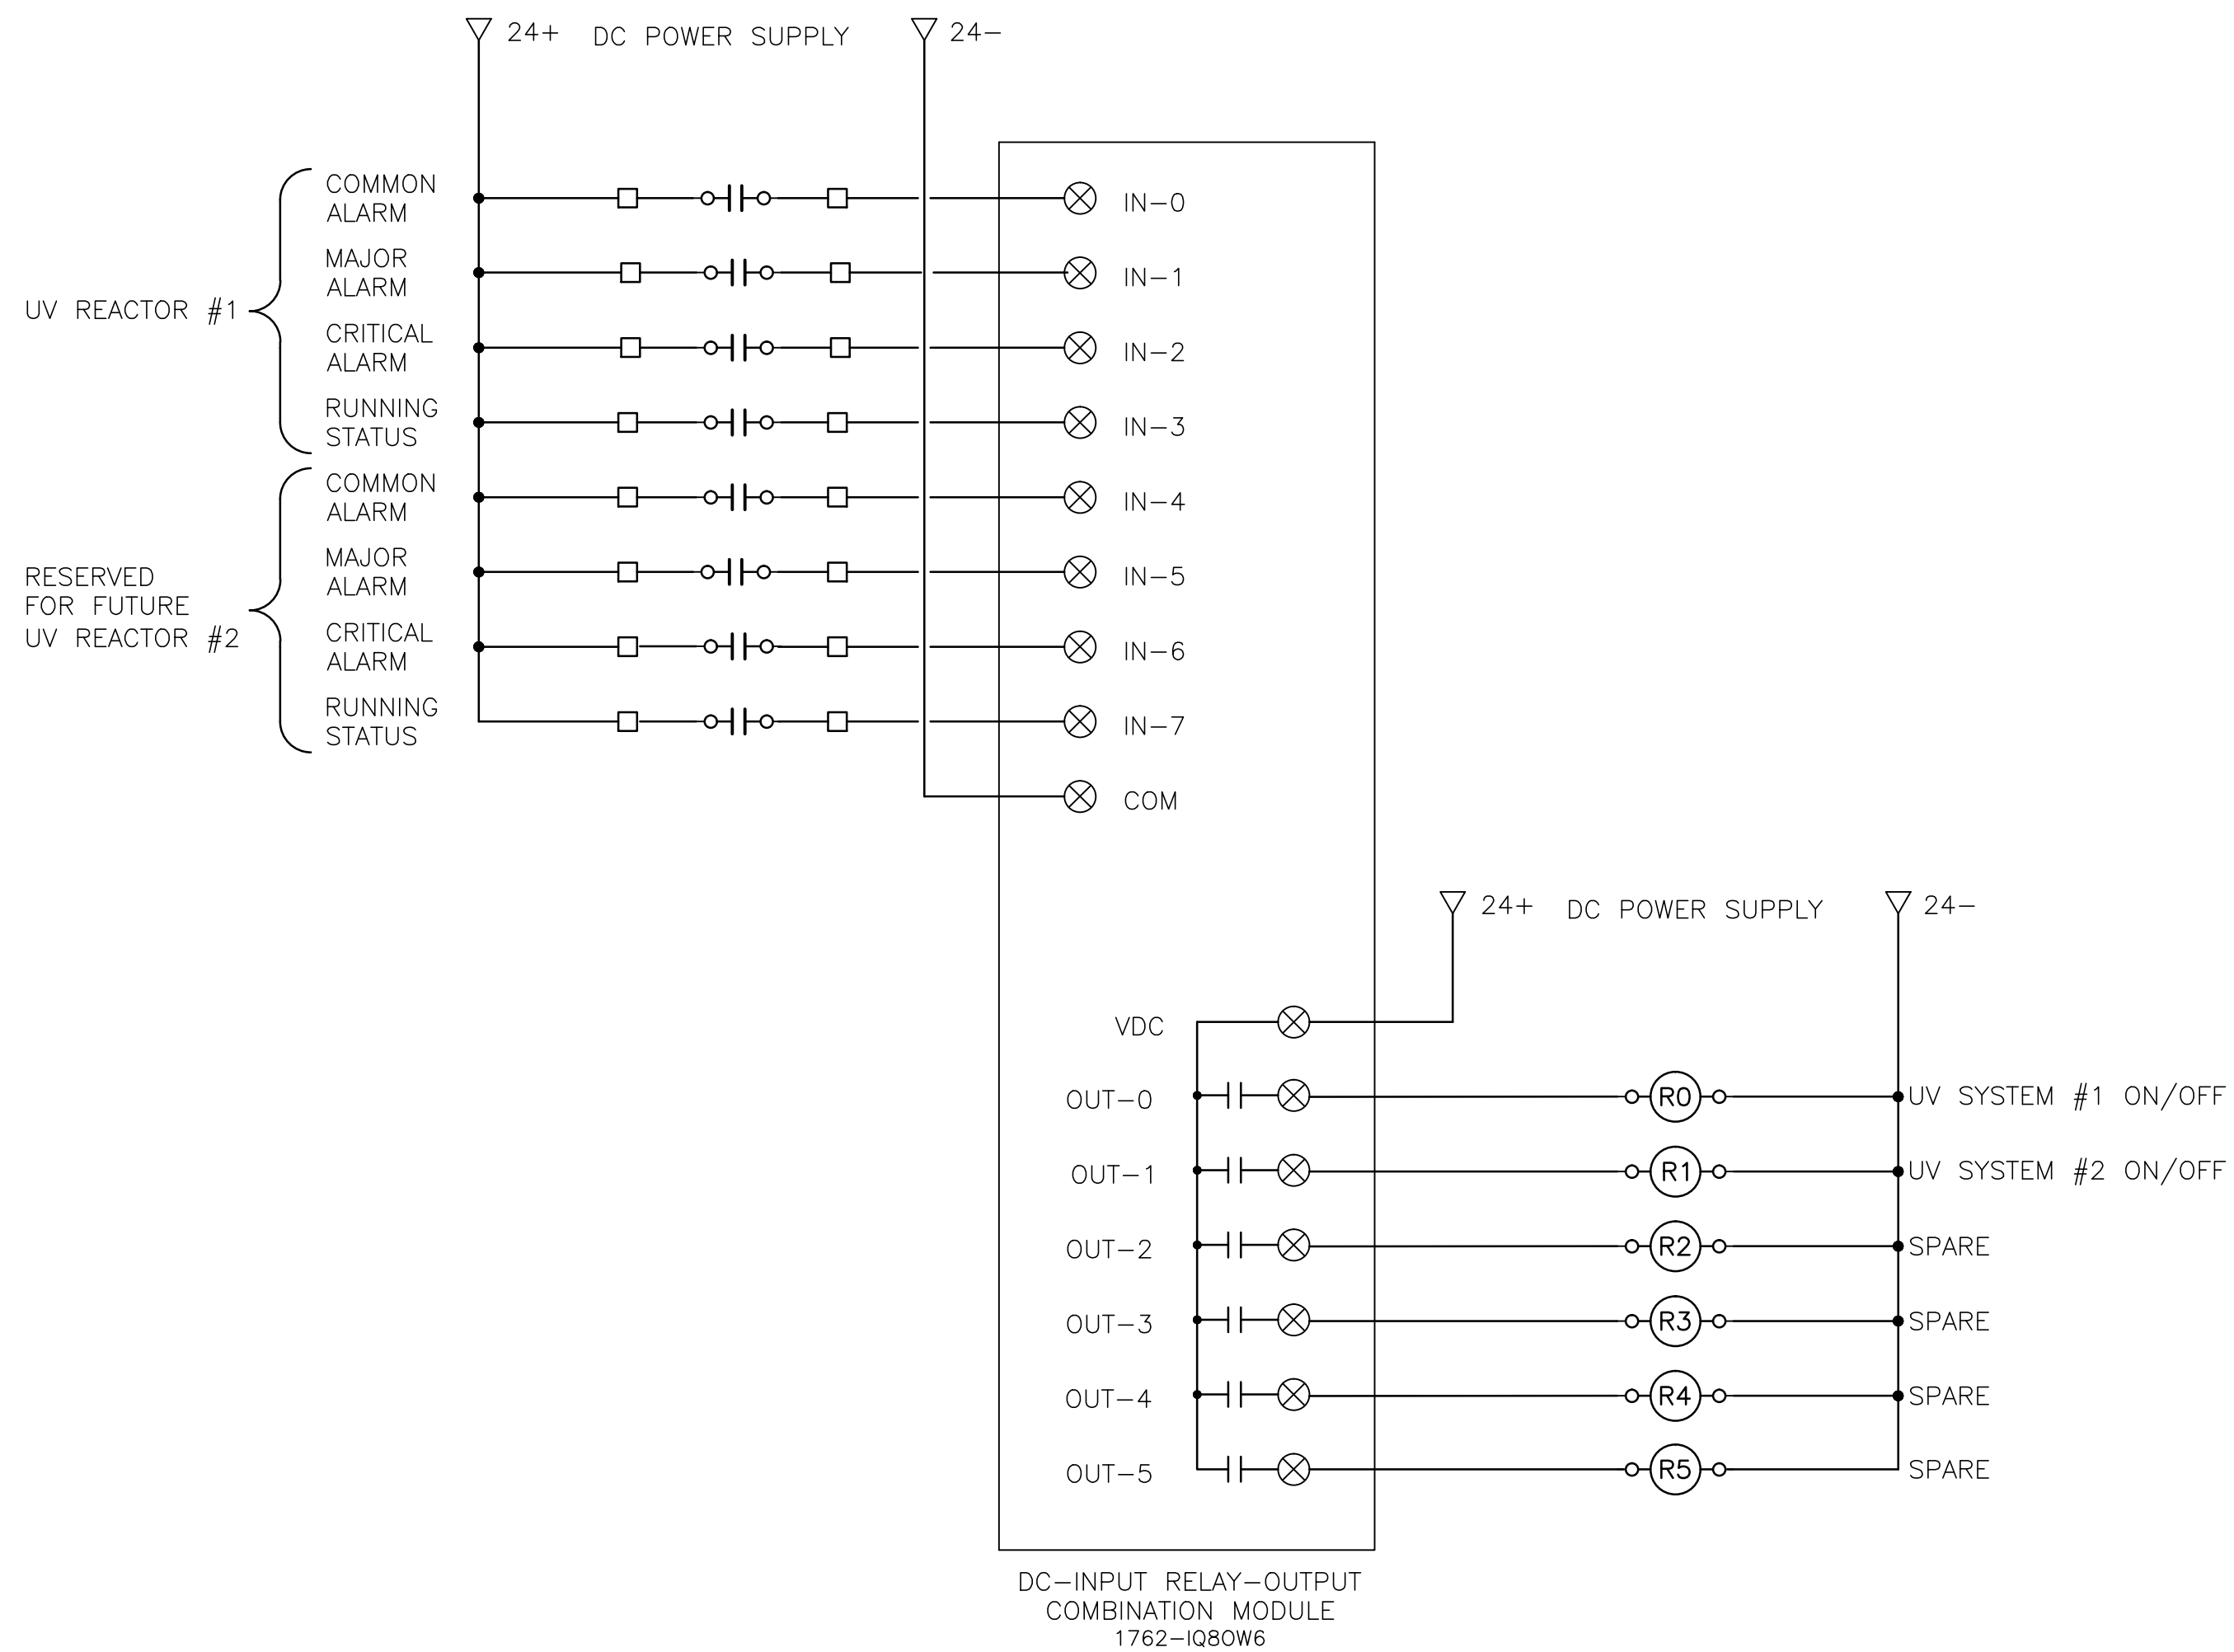


EXISTING PLC PANEL NEW I/O

NOTES:
1. CONTRACTOR TO PROVIDE, IF REQUIRED, EXTERNAL POWER FOR THE UV REMOTE ON/OFF SIGNALS TO SUIT THE UV SYSTEM THAT IS SELECTED.

" This Record Drawing has been prepared by Opus DaytonKnight ("Opus DK") for the exclusive use of "Sunshine Coast Regional District" (the "Client"). Any use which a third party makes of this drawing, or any reliance or decisions or actions taken by any such third party based upon this drawing, are the sole responsibility of any such third party and Opus DK accepts no responsibility, liability or risk for any damages, loss, or claims, if any, suffered by any such third party or any related party of such third party as a result of any reliance, or decisions made or actions taken, based upon this drawing. It is the user's sole responsibility to check the accuracy of this digital drawing."

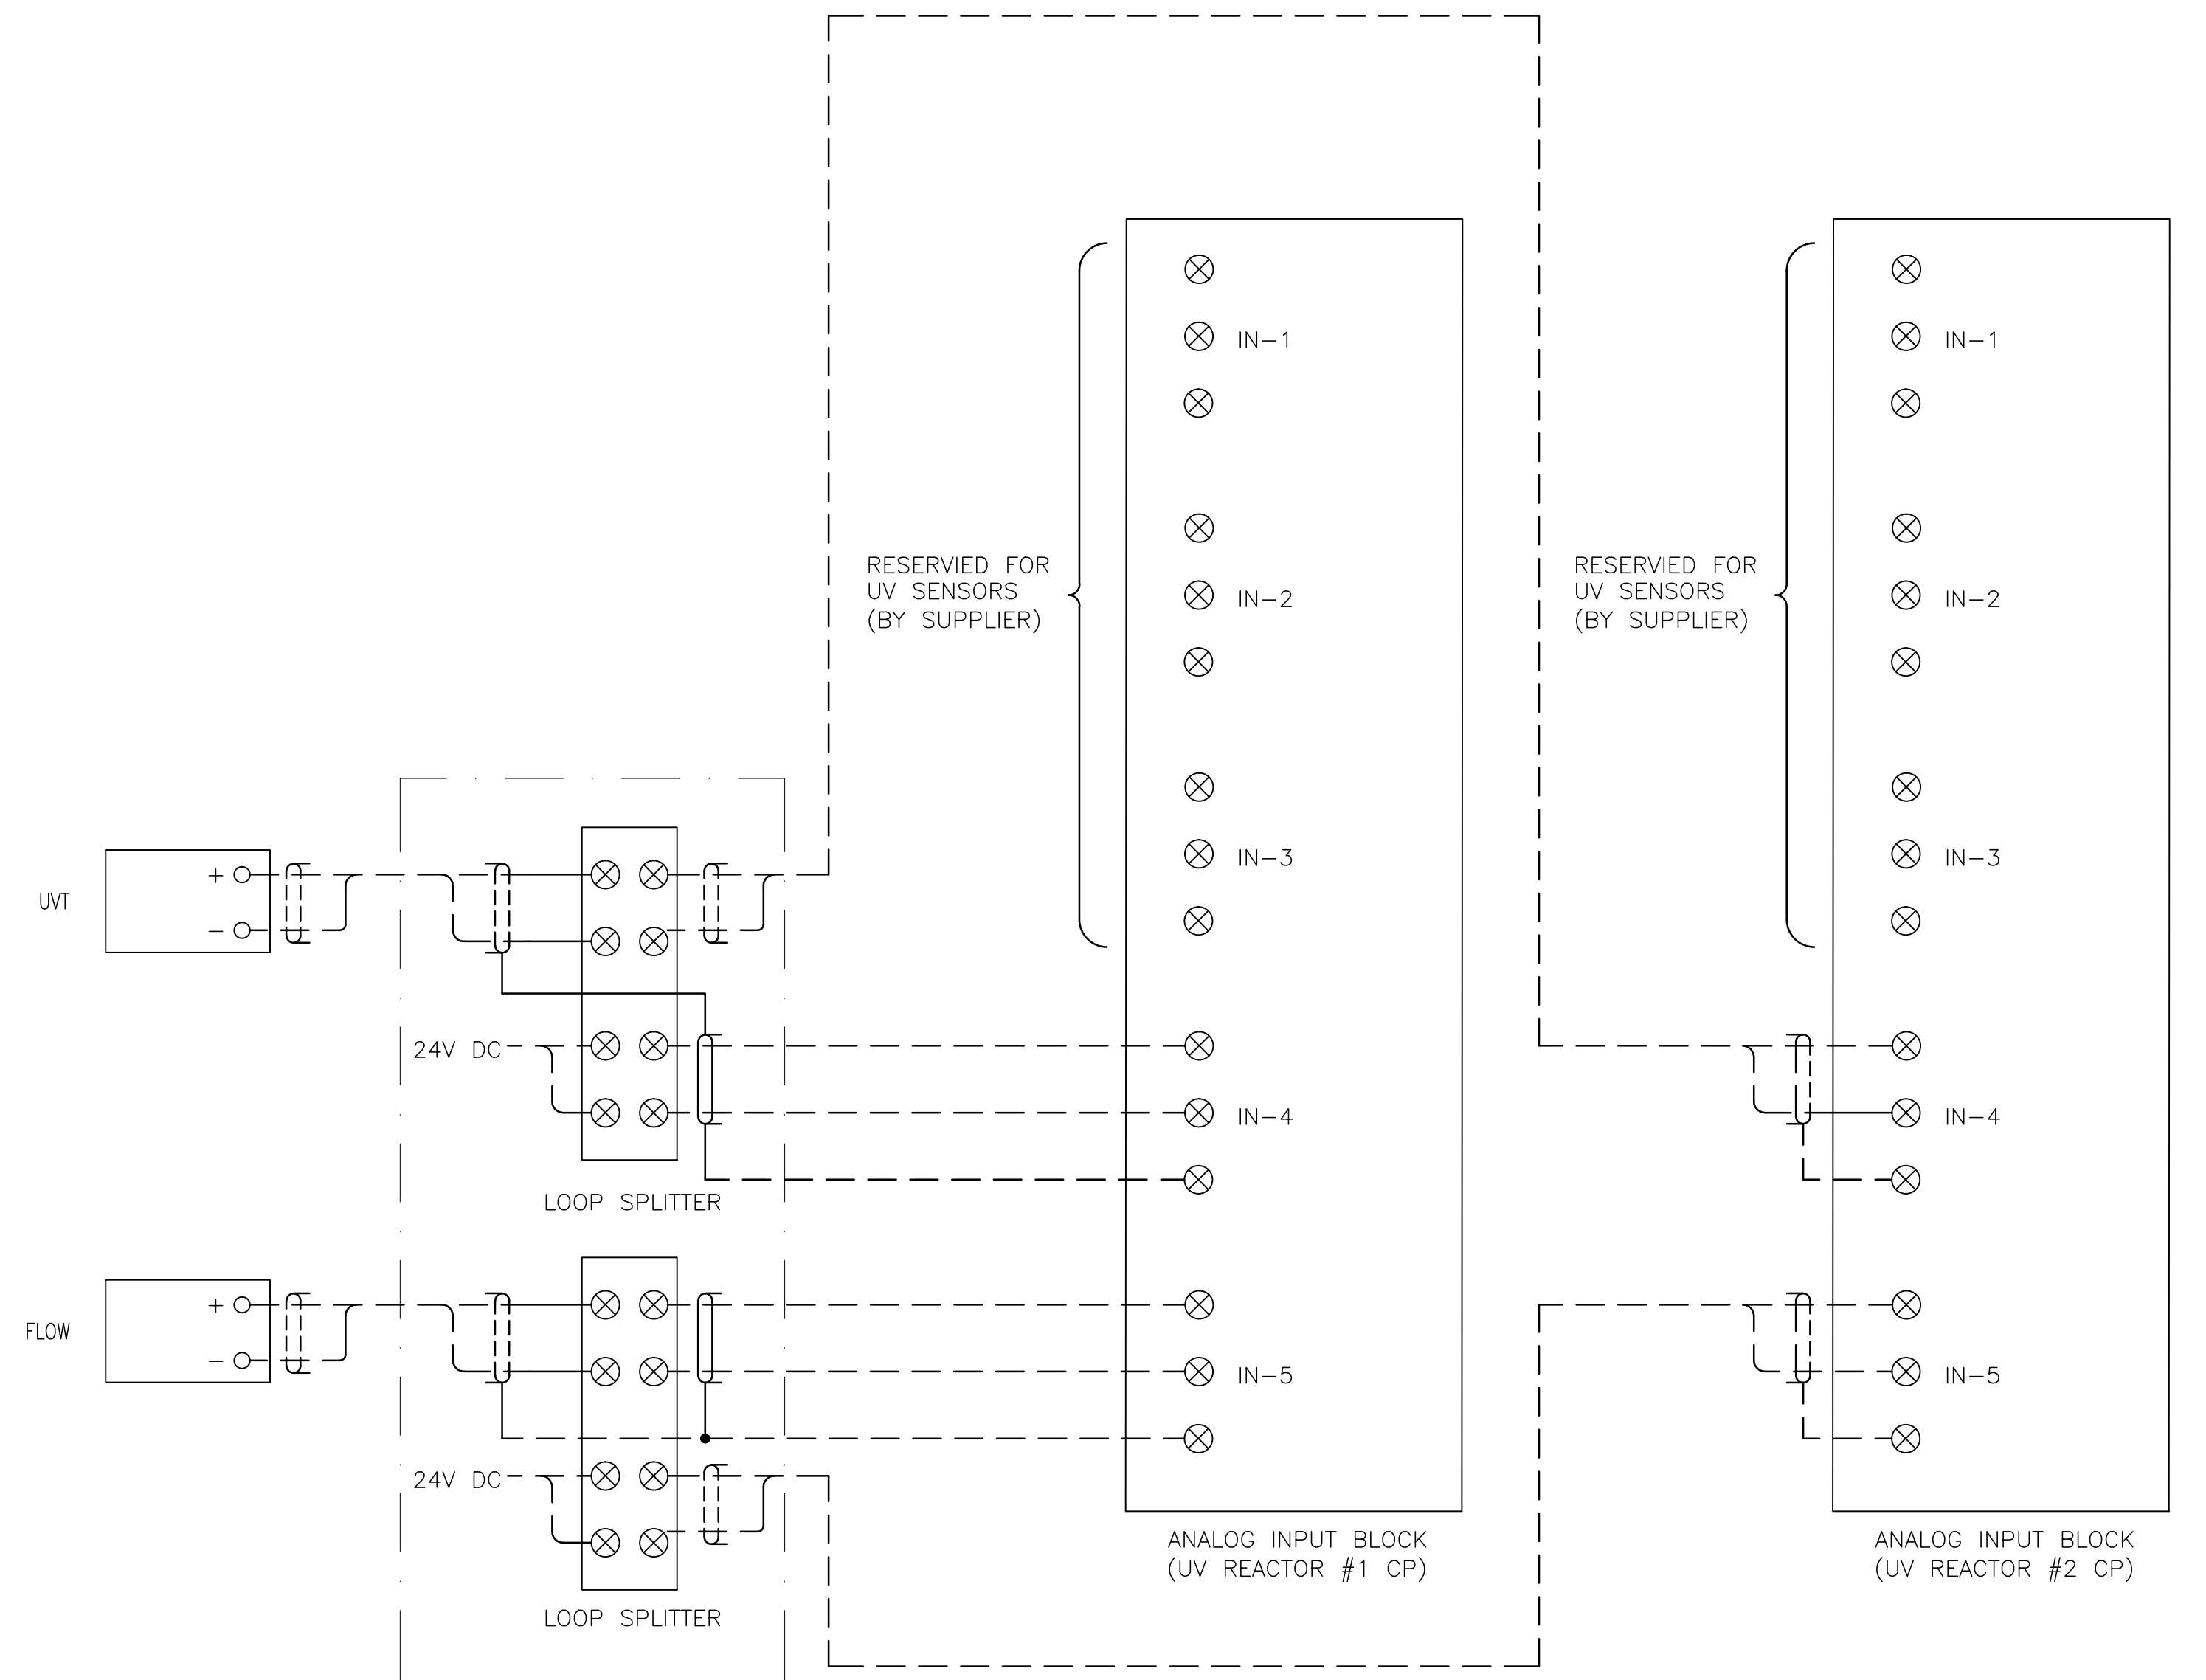

EXISTING PLC CP

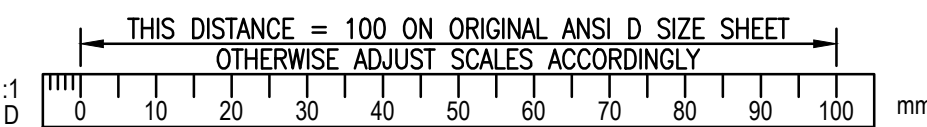


REVISIONS	ISSUE	DATE	DRAWN	CHK'D	APP'D	DESCRIPTION	ISSUE	DATE	DRAWN	CHK'D	APP'D	DESCRIPTION
A	JAN27/12	GV	TT	TT		ISSUED FOR TENDER						
B	APR25/12	GV	TT	TT		ISSUED FOR CONSTRUCTION						
C	MAY08/13	RB	GV	WB		RECORD DRAWING						

DESIGNED	GV
DRAWN	GV
CHECKED	TT


OPUS DAYTONKNIGHT
 North Vancouver Office 604-990-4800
 210-889 Harbourside Drive North Vancouver BC V7P 3S1, Canada

SUNSHINE COAST REGIONAL DISTRICT
GARDEN BAY UV BUILDING
ELECTRICAL - NEW I/O

SCALE: AS SHOWN
DRAWING No. 028.206
SHEET No. E3 ISSUE C

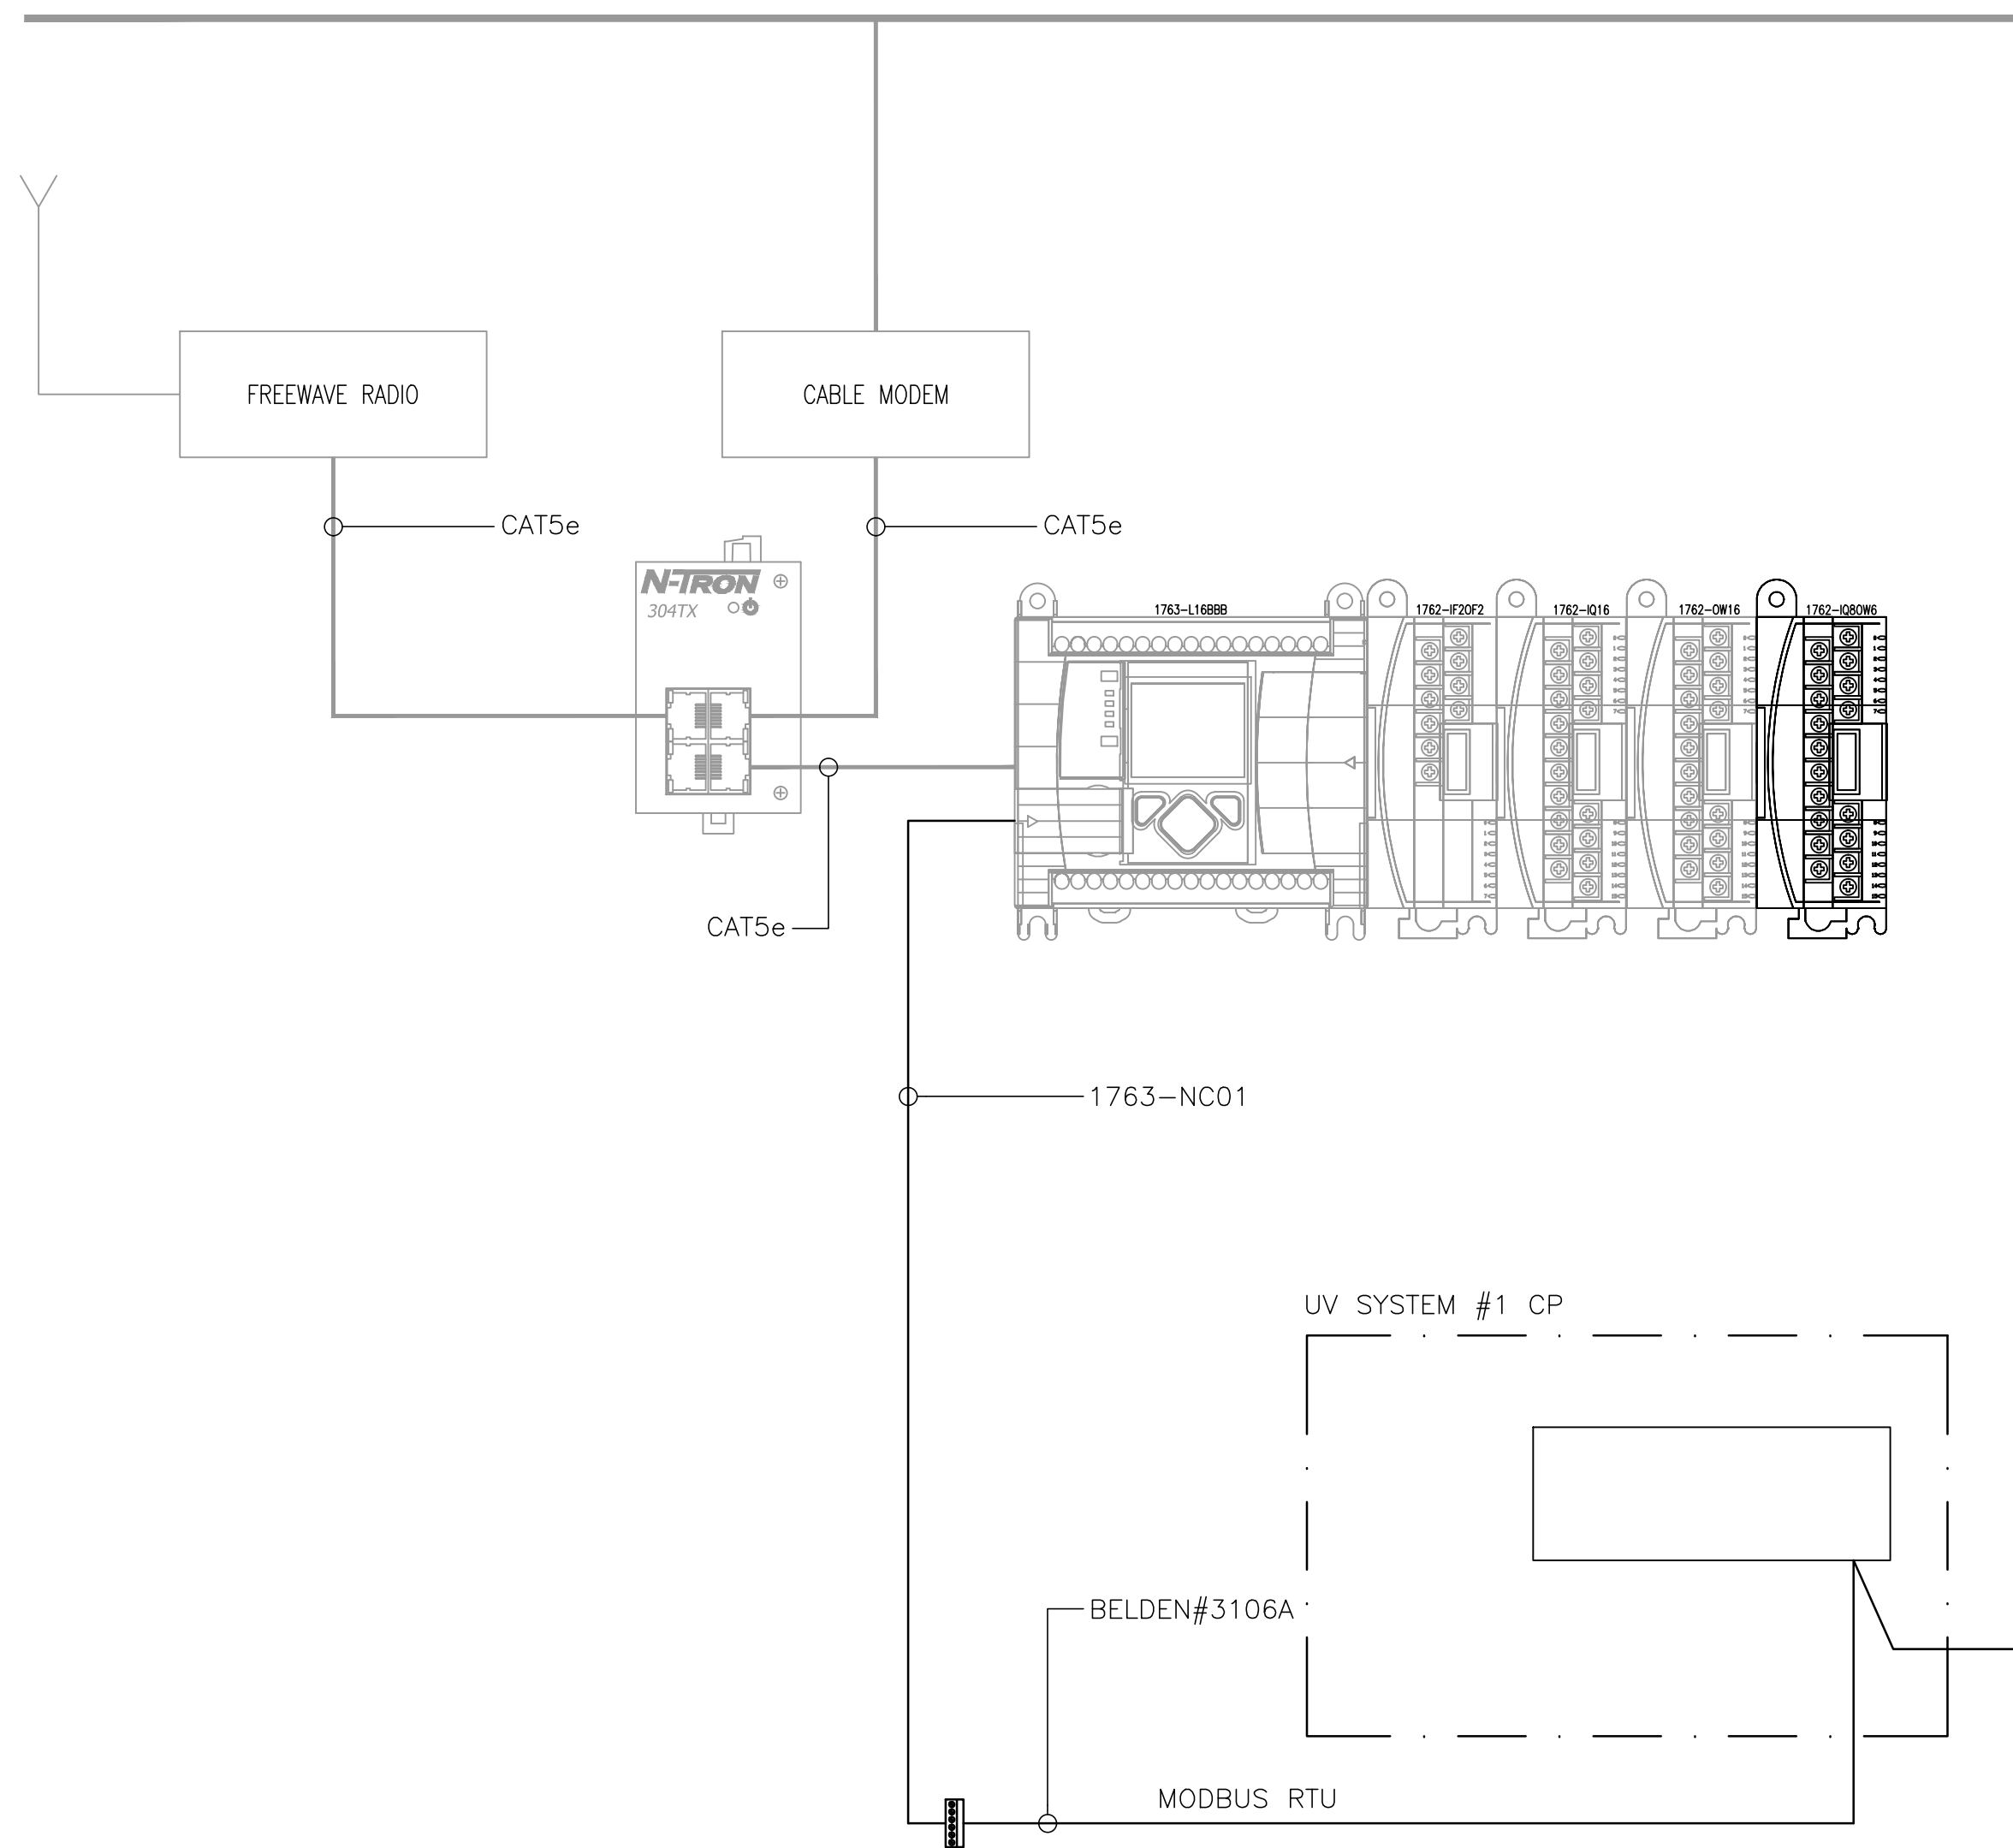


PLC LAYOUT AND COMMUNICATION BLOCK DIAGRAM

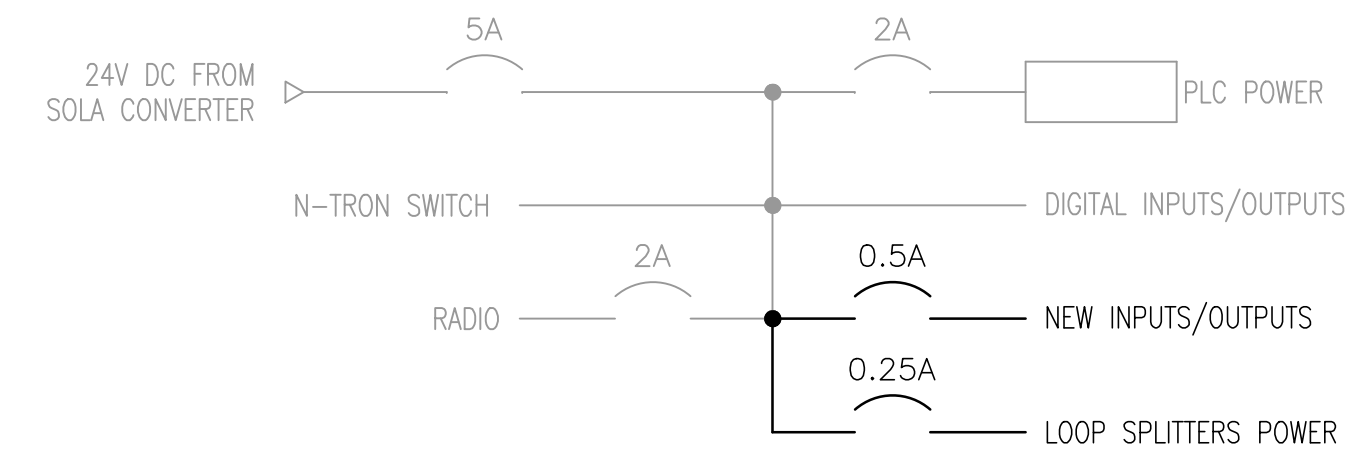

DC CONTROL POWER MODIFICATIONS

NOTE 2.

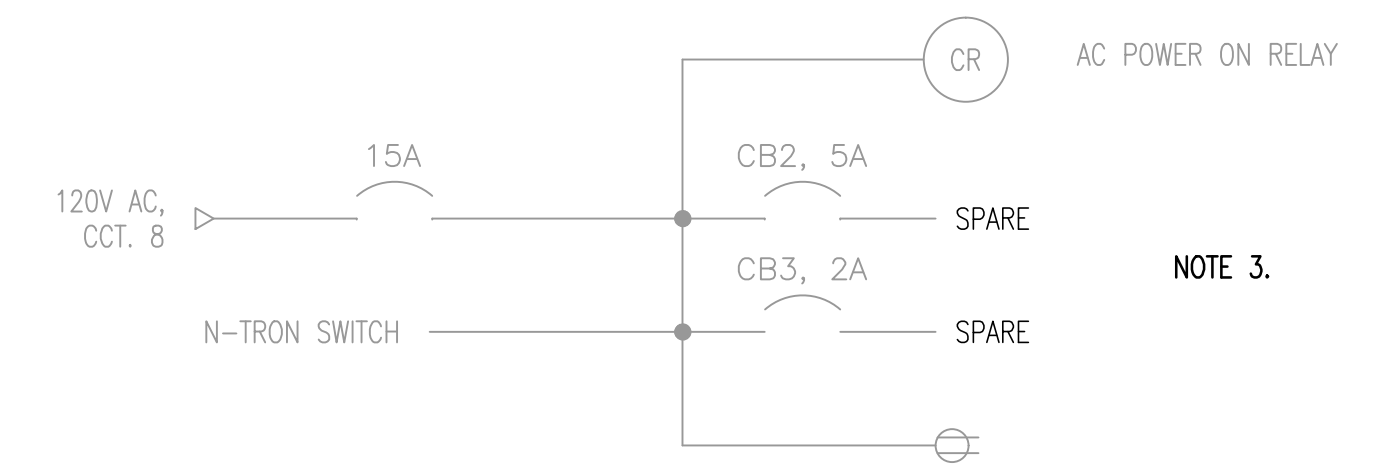


PLC CP AC POWER MODIFICATIONS

NOTE 3.

NOTES:

1. PROVIDE NEW EQUIPMENT AND WIRING INSIDE THE MAIN PLC PANEL, AND WIRE WITH OUTSIDE EQUIPMENT.
2. PROVIDE NEW CIRCUIT BREAKERS AND WIRING.
3. POWER THE INSTRUMENTATION FROM THE NEW INSTRUMENTATION POWER DP, LEAVE THE EXISTING CIRCUIT BREAKERS INSIDE THE MAIN PLC CP AS SPARE.

" This Record Drawing has been prepared by Opus DaytonKnight ("Opus DK") for the exclusive use of "Sunshine Coast Regional District" (the "Client"). Any use which a third party makes of this drawing, or any reliance or decisions or actions taken by any such third party based upon this drawing, are the sole responsibility of any such third party and Opus DK accepts no responsibility, liability or risk for any damages, loss, or claims, if any, suffered by any such third party or any related party of such third party as a result of any reliance, or decisions made or actions taken, based upon this drawing. It is the user's sole responsibility to check the accuracy of this digital drawing."

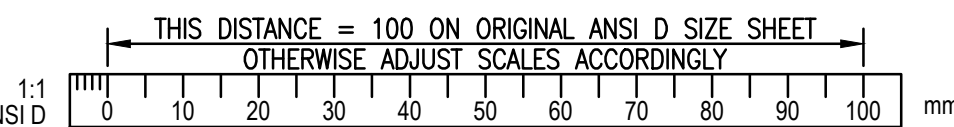

ISSUE	DATE	DRAWN	CHK'D	APP'D	DESCRIPTION	ISSUE	DATE	DRAWN	CHK'D	APP'D	DESCRIPTION
A	JAN27/12	GV	TT	TT	ISSUED FOR TENDER						
B	APR25/12	GV	TT	YY	ISSUED FOR CONSTRUCTION						
C	MAY08/13	RB	GV	WB	RECORD DRAWING						

DESIGNED	GV
DRAWN	GV
CHECKED	TT

OPUS DAYTONKNIGHT
 North Vancouver Office
 604-990-4800
 210-889 Harbourside Drive
 North Vancouver BC
 V7P 3S1, Canada

SUNSHINE COAST REGIONAL DISTRICT
 GARDEN BAY UV BUILDING
 ELECTRICAL - PLC LAYOUT / COMMUNICATION BLOCK DIAGRAM

SCALE: AS SHOWN
DRAWING No. 028.206
SHEET No. E4 ISSUE C

FILE: G:\D&K CAD Drawings\DKSERVER P - Shore\Records\SUNSHINE COAST\28-206\ELECTRICAL\28-206-E4.dwg Tab: PLC LAYOUT 13-06-07 vggj00